

O.D.O.T. DISTRICT 2 SURVEY OFFICE (USE ONLY)

PERSONNEL \_\_\_\_\_ REFERENCE NO. 4 SHEET 4 OF 48

NOTES HOMAN DATE 7/29/16 ROUTE US 20A  
 H.C. HOMAN WEATHER CLOUDY COUNTY LUCAS  
 R.C. KEFFER TEMP. 75°F TOWNSHIP SWANTON  
 \_\_\_\_\_ SECTION 8  
 \_\_\_\_\_ T 7 N R 5 E

TYPE MONUMENT MOBORA MON


~~ON SURFACE~~ - BELOW 3"

LEFT - ☉ PAV'T - RIGHT 1.0'


27' TO LT EDGE PAVEMENT

S.L.M. 78+70

GRID: NORTHING: 701091.3889 EASTING: 1598079.533

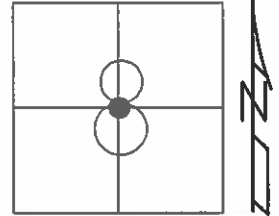


RECORD:  
 FD MOBORA MON  
 6/15/03, DCH  
 SET MAG/WASHER  
 1/13/04, DCH  
 FD MOBORA MON  
 3" DOWN  
 GPS, REF4  
 7/29/16  
 SET MAG/WASHER  
 GPS, NEWREF4  
 10/05/16

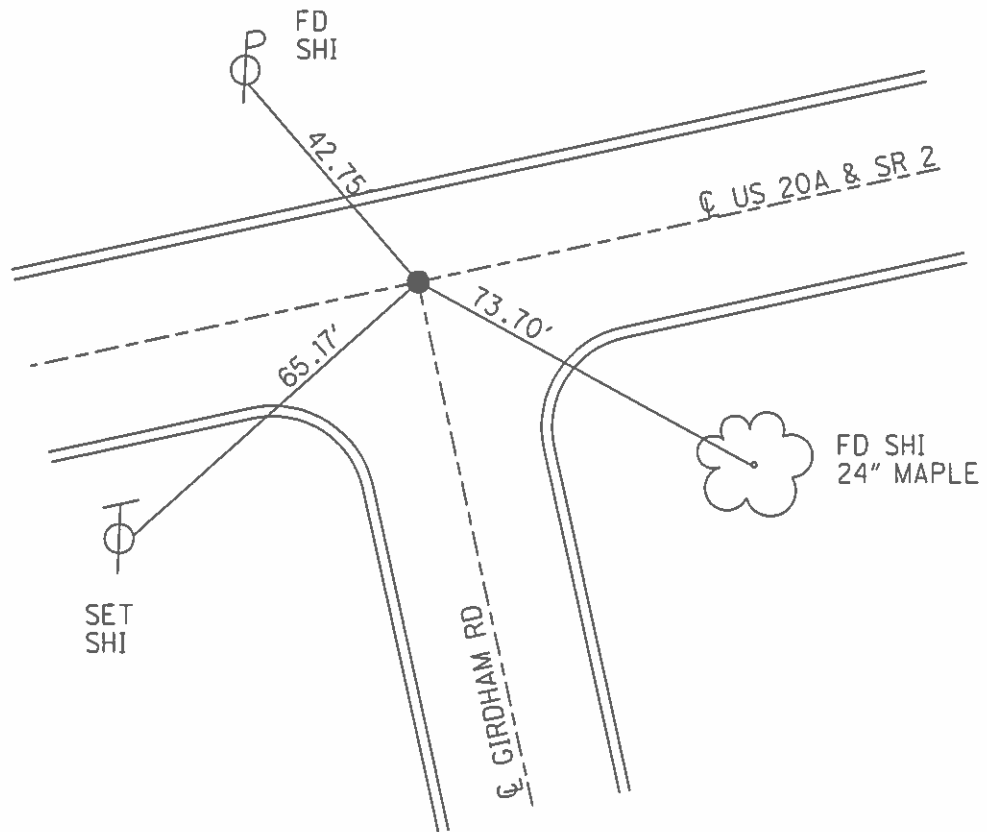

O.D.O.T. DISTRICT 2 SURVEY OFFICE (USE ONLY)


PERSONNEL \_\_\_\_\_ REFERENCE NO. 4 SHEET 4 OF 31  
 NOTES HOMAN DATE 7/29/16 ROUTE SR 2  
 H.C. HOMAN WEATHER CLOUDY COUNTY LUCAS  
 R.C. RYALL TEMP. 75°F TOWNSHIP SWANTON  
 \_\_\_\_\_ SECTION 8  
 \_\_\_\_\_ T 7 N R 5 E

TYPE MONUMENT MOBORA MON  
~~ON SURFACE~~ - BELOW 3"  
 LEFT - Q PAV'T - ~~RIGHT~~ 1.0'  
27' TO LT EDGE PAVEMENT  
 S.L.M. 78+70

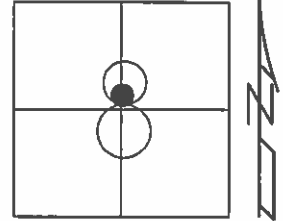

GRID: NORTHING: 701091.3889 EASTING: 1598079.533


RECORD:  
 FD MOBORA MON.  
 6/15/03 DCH  
 SET MAG/WASH  
 1/13/04 DCH  
 FD MOBORA MON  
 3" DOWN  
 GPS, REF4  
 7/29/16  
 SET MAG/WASHER  
 GPS, NEWREF4  
 10/05/16

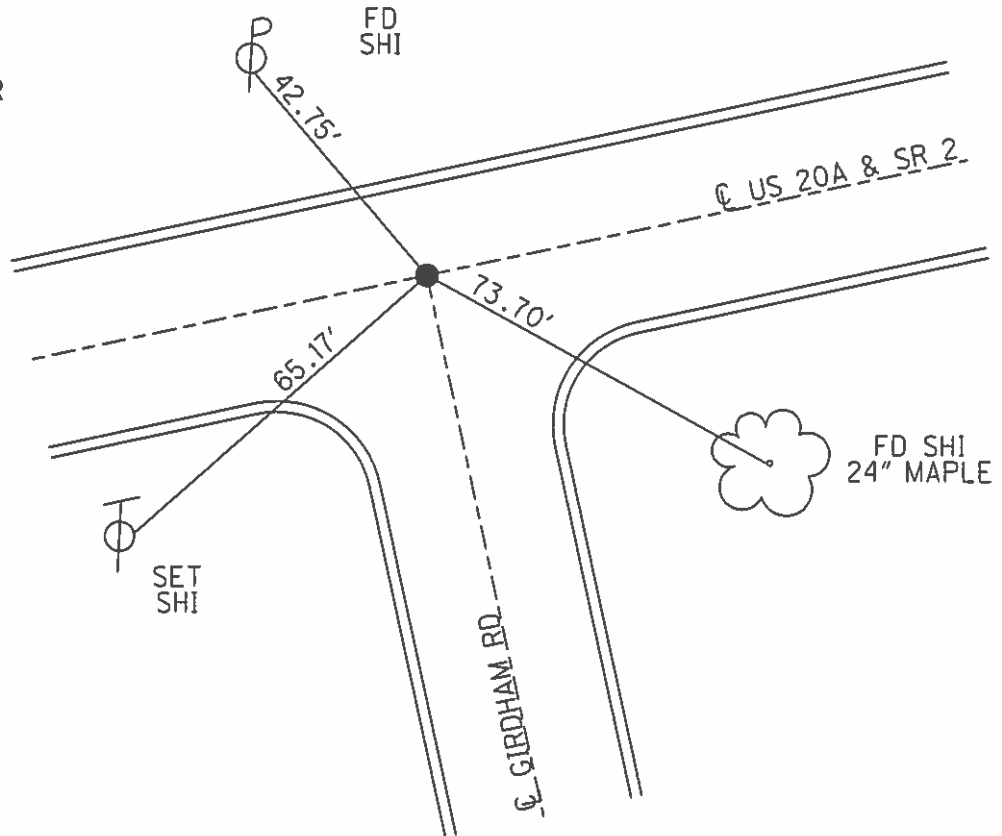

O.D.O.T. DISTRICT 2 SURVEY OFFICE (USE ONLY)

PERSONNEL \_\_\_\_\_ REFERENCE NO. 4 SHEET 4 OF 11  
 NOTES HOMAN DATE 7-29-16 ROUTE SR 2  
 H.C. HOMAN WEATHER CLOUDY COUNTY LUCAS  
 R.C. RYALL TEMP. 75°F TOWNSHIP SWANTON  
 \_\_\_\_\_ SECTION 8  
 \_\_\_\_\_ T 7 N R 5 E

TYPE MONUMENT MOBORA MON  
~~ON SURFACE~~ - BELOW 3"  
 LEFT - ☉ PAV'T - ~~RIGHT~~ 1.0'  
27' TO LT EDGE PAVEMENT  
 S.L.M. 78+70

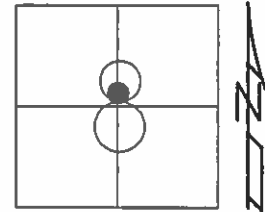


Grid: Northing: 701091.3889 Easting: 1598079.533

RECORD:  
 FD. MOBORA MON.  
 6-15-03 DCH

SET MAG/WASH  
 1-13-04 DCH

FD MOBORA MON  
 3" DOWN  
 GPS, REF 4  
 7-29-16

SET MAG/WASHER  
 GPS, NEWREF 4  
 10-05-16

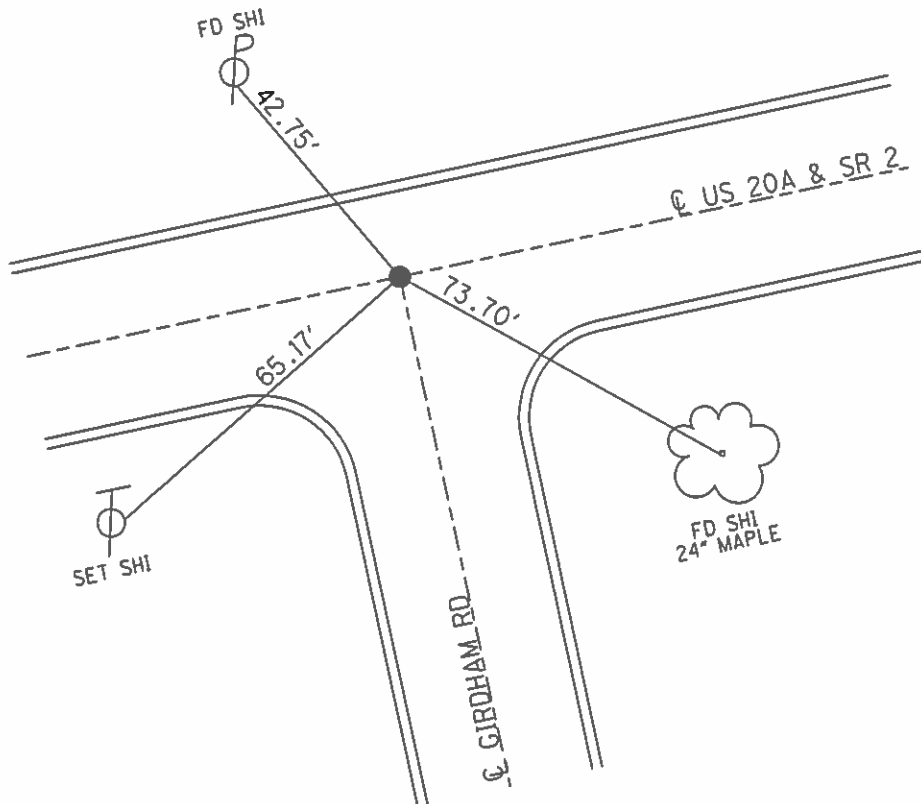

County LUCAS S.R. U.S. 20-A

Date 9-25-80

Township SWANTON

Weather CLEAR

Section 8


Temp. +68'

T1N, R5E

Personnel SMITH

BOWERS


MEAD

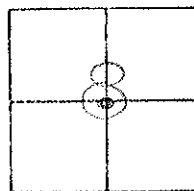

1.48

#4

FD. MOBORA MON  
TO SURFACE  
27' TO N. EDGE PAVE.

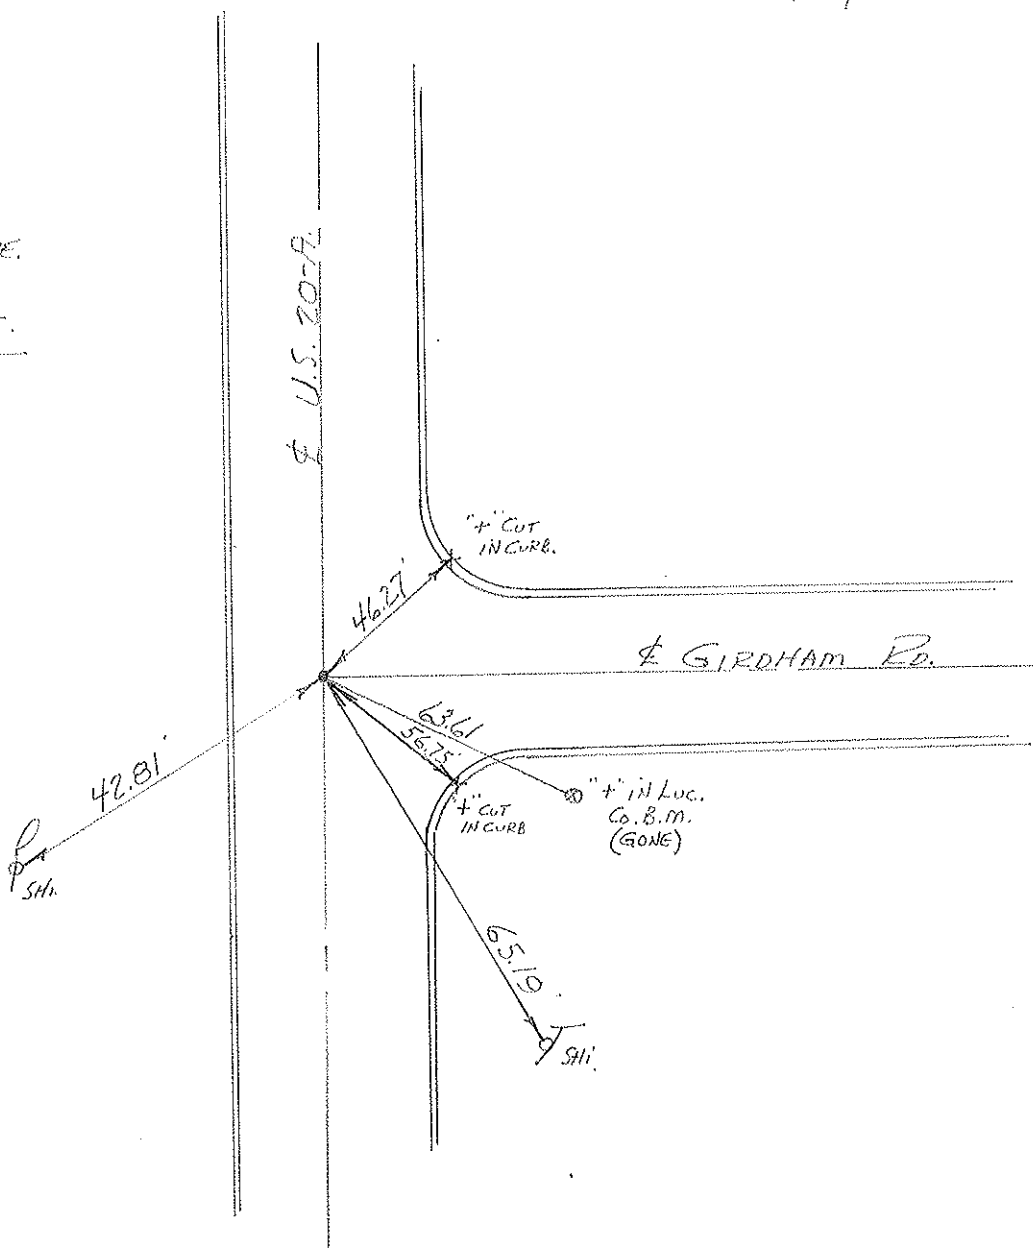


PERSONNEL	TITLE	PERSONNEL	TITLE	COUNTY	DATE
Tomsic					Dec. 14-64
Neuser				S. R.	WEATHER cloudy
Ando				SEC.	TEMP. 30°
Vanyo					


DESCRIPTION Short on S.R. #2 - 20A JOB NO. \_\_\_\_\_

Short #19 pipe at 33+03 - 24' Rt. is 8" F.T. and continues under surface to C.B. 36+09 Rt. This 8" F.T. is connected to 12" concrete pipe stub going West from C.B. at 36+09. Made check by digging down to pipe and found joint.

Short #20

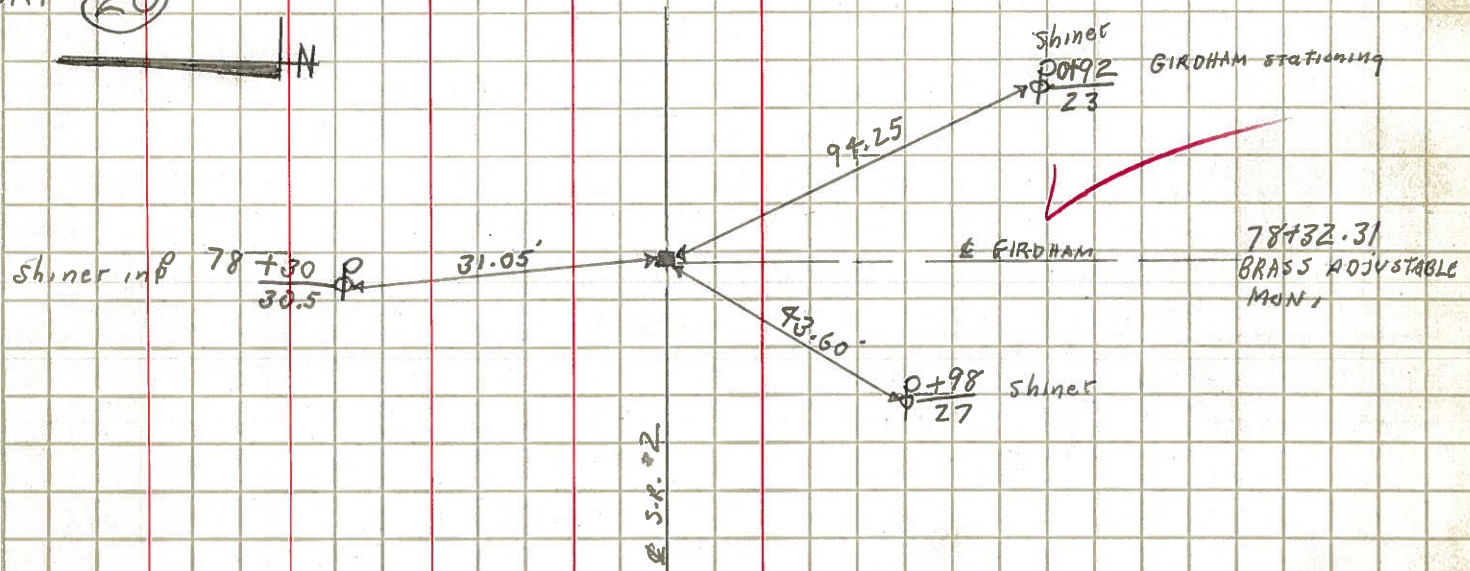

Short #22

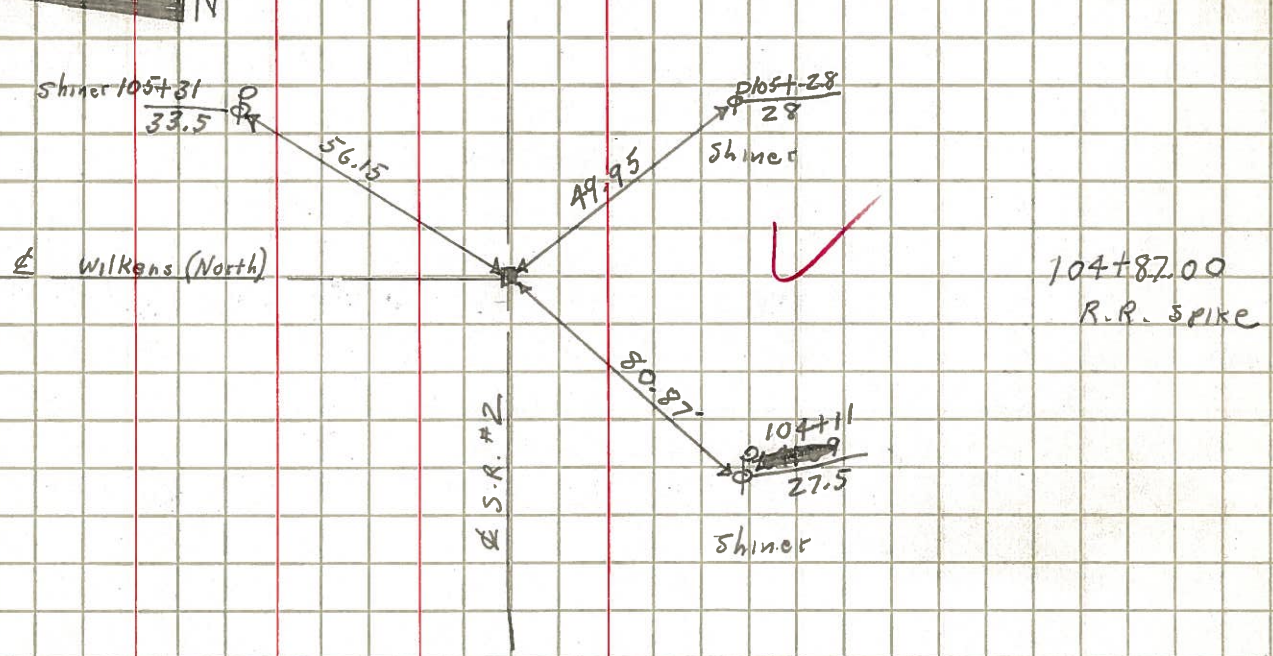

PERSONNEL TITLE PERSONNEL TITLE

COUNTY Lucas DATE 5 Nov. 64

Stang

f

Crow

S. R. #2-20A WEATHER Mild

SEC. TEMP. 60°

DESCRIPTION

References to Control Pts.

JOB NO.

LEFT

CENTER LINE

RIGHT

0+00 =	E Hallet Rd. Fd. Adj. Mon. 1" Below Surface	✓	27.73' S.S.W. to Shiner in ♂ 38.24' N.W. to Shiner in ♂ 95.45' N.E. to S.W. Cor. Mocombo
25+46.31 =	E S.R. #64 Fd. Adj. Mon. at Surface	✓	70.55' S.E. to N.W. Cor. Bldg. 38.58' N.W. to Shiner in ♂ 40.42' N.E. to Shiner in ♂ 78.33' S.S.W. to Shiner in ♂
54+94.93 =	E Scott Rd. Fd. Adj. Mon. at Surface	✓	194.10' S. to Brass Cop in Con. Mon. 72.42' S.E. to N.W. Cor. House 59.16' S.W. to Shiner in 28" Tree 72.16' N.E. to S.W. Cor. Porch 38.42' N.W. to Shiner in ♂
78+32.31 =	E Girdham Fd. Adj. Mon. at Surface		54.68' N.N.E. to S.W. Cor. Bldg, 1st. Block 94.24' S.S.E. to Shiner in ♂ 104.66' S.W. to N.E. Cor. Con. Wall 66.52' S.E. to N.W. Cor. Bldg. at sidewalk
100+10.86 =	P.I. Δ = 4952' Lt. Fd. Adj. Mon. at Surface	✓	82.98' N.E. to Shiner in ♂ 31.40' N.N.W. to Shiner in 32" Tree 76.44' S.W. to Shiner in 11" Tree 29.16' S.S.E. to Shiner in ♂
104+87.00 =	E Wilkens Rd. M. Fd. 1 1/2" I. Pin at Surface		56.15' N.E. to Shiner in ♂ 49.95' S.E. to Shiner in ♂ 37.76' S.W. to Ref. Mon. 80.88' W.S.W. to Shiner in ♂
118+04.01 =	E Wilkens Rd. S. Fd. R.R. Spt. to Surface	✓	65.30' N.E. to Shiner in 18" Tree 33.44' N.N.W. to Shiner in ♂ 86.16' S.S.W. to Shiner in ♂