


O.D.O.T. DISTRICT 2 SURVEY OFFICE (USE ONLY)


PERSONNEL _____ REFERENCE NO. 4 A SHEET 5 OF 48
 NOTES HOMAN DATE 7/29/16 ROUTE US 20A
 H.C. HOMAN WEATHER CLOUDY COUNTY LUCAS
 R.C. KEFFER TEMP. 75°F TOWNSHIP SWANTON
 _____ SECTION 8
 _____ T 7 N R 5 E

TYPE MONUMENT MOBORA MON
~~ON SURFACE~~ - BELOW 5"
 LEFT - ☉ PAV'T - RIGHT 3.0'
23.5' TO RT EDGE PAVEMENT
 S.L.M. 100+55

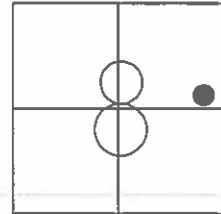

GRID: NORHTING: 701267.101 EASTING: 1600251.266


RECORD:
 PI CURVE LEFT
 EAST OF GIRDHAM
 FD MOBORA MON
 6/15/03, DCH
 SET MAG/WASHER
 1/13/04, DCH
 FD MOBORA MON
 5" DOWN
 GPS, REFA4
 7/29/16
 SET MAG/WASHER
 GPS, NEWREFA4
 10/05/16

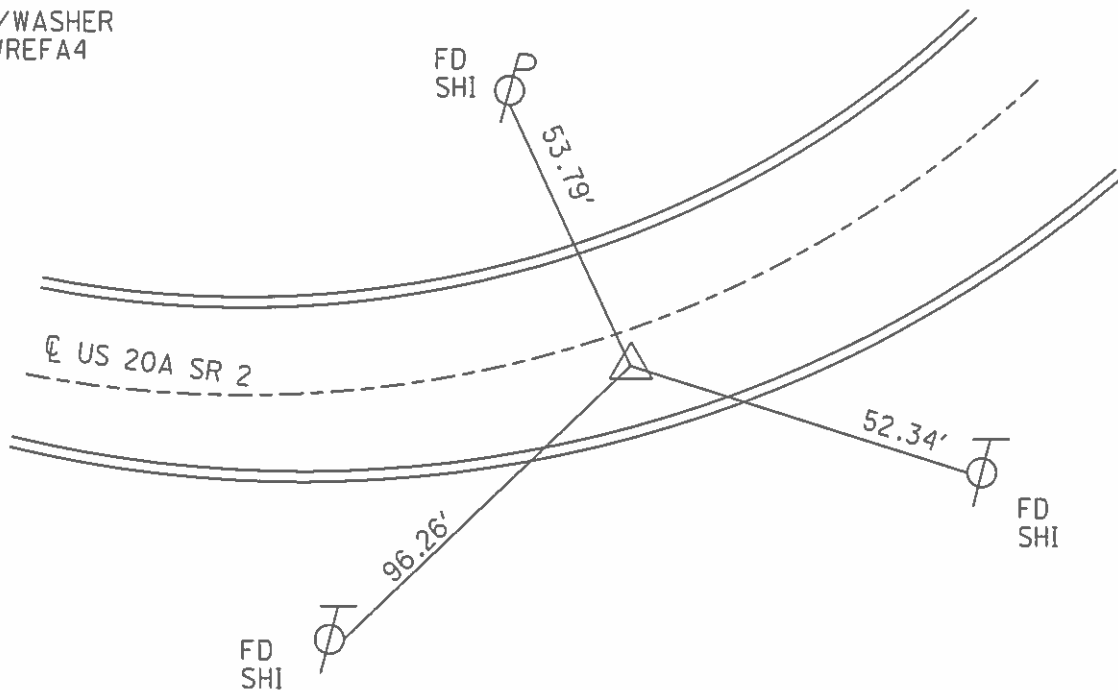


O.D.O.T. DISTRICT 2 SURVEY OFFICE (USE ONLY)

PERSONNEL _____ REFERENCE NO. 4 A SHEET 5 OF 31
 NOTES HOMAN DATE 7/29/26 ROUTE SR 2
 H.C. HOMAN WEATHER CLOUDY COUNTY LUCAS
 R.C. RYALL TEMP. 75°F TOWNSHIP SWANTON
 _____ SECTION 8
 _____ T 7 N R 5 E

TYPE MONUMENT MOBORA MON
~~ON SURFACE~~ - BELOW 5"
~~LEFT~~ - ☉ PAV'T - RIGHT 3.0'
23.5' TO RT EDGE PAVEMENT
 S.L.M. 100+55
 GRID: NORTHING: 701267.101 EASTING: 1600251.266

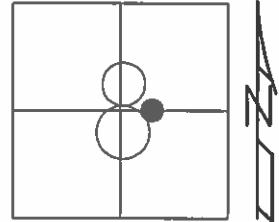



RECORD:
 PI CURVE LEFT
 EAST OF GIRDHAM
 FD MOBORA MON
 6/15/03 DCH
 SET MAG/WASH
 1/13/04 DCH
 FD MOBORA MON
 5" DOWN
 GPS, REFA4
 7/29/16
 SET MAG/WASHER
 GPS, NEWREFA4
 10/05/16

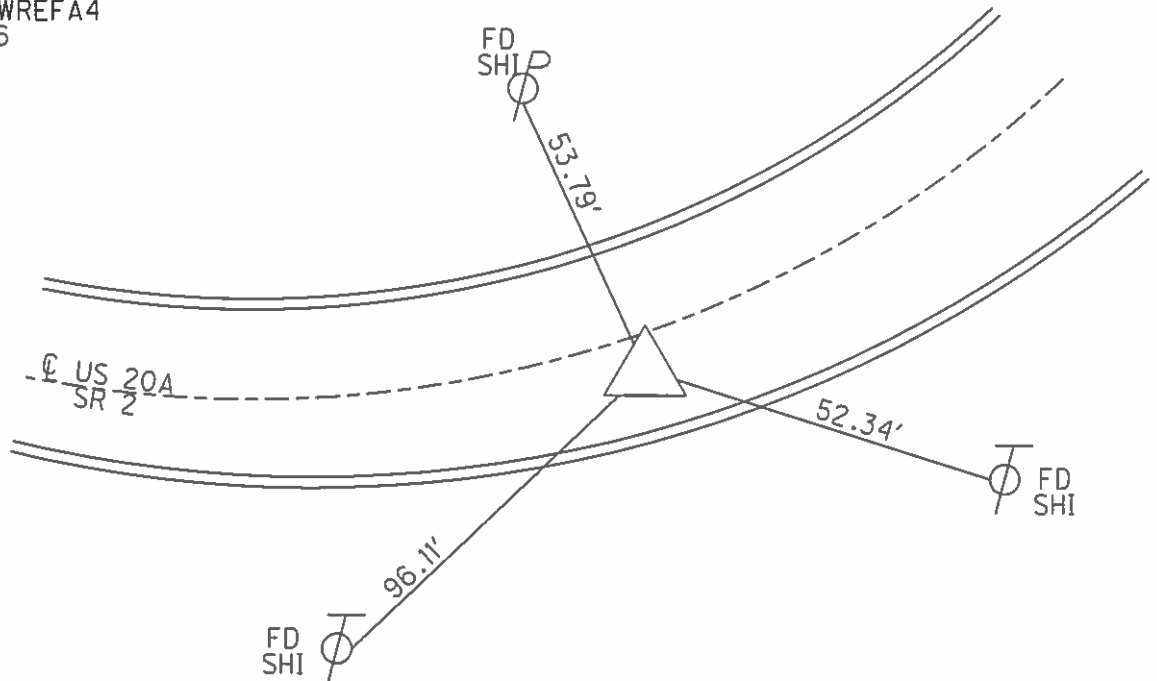

O.D.O.T. DISTRICT 2 SURVEY OFFICE (USE ONLY)

PERSONNEL _____ REFERENCE NO. 4 A SHEET 5 OF 11
 NOTES HOMAN DATE 7-29-16 ROUTE SR 2
 H.C. HOMAN WEATHER CLOUDY COUNTY LUCAS
 R.C. RYALL TEMP. 75°F TOWNSHIP SWANTON
 SECTION 8
 T 7 N R 5 E

TYPE MONUMENT MOBORA MON
~~ON SURFACE~~ - BELOW 5"
~~LEFT~~ - ☉ PAV'T - RIGHT 3.0'
23.5' TO RT EDGE PAVEMENT
 S.L.M. 100+55
 Grid: Northing: 701267.101 Easting: 1600251.266

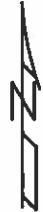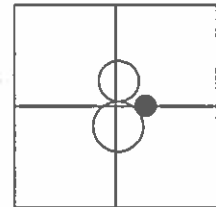


RECORD:
 PI CURVE LEFT
 EAST OF GIRDHAM

FD. MOBORA MON.
 6-15-03 DCH

SET MAG/WASH
 1-13-04 DCH

FD MOBORA MON
 5" DOWN
 GPS, REFA4
 7-29-16

SET MAG/WASHER
 GPS, NEWREFA4
 10-05-16

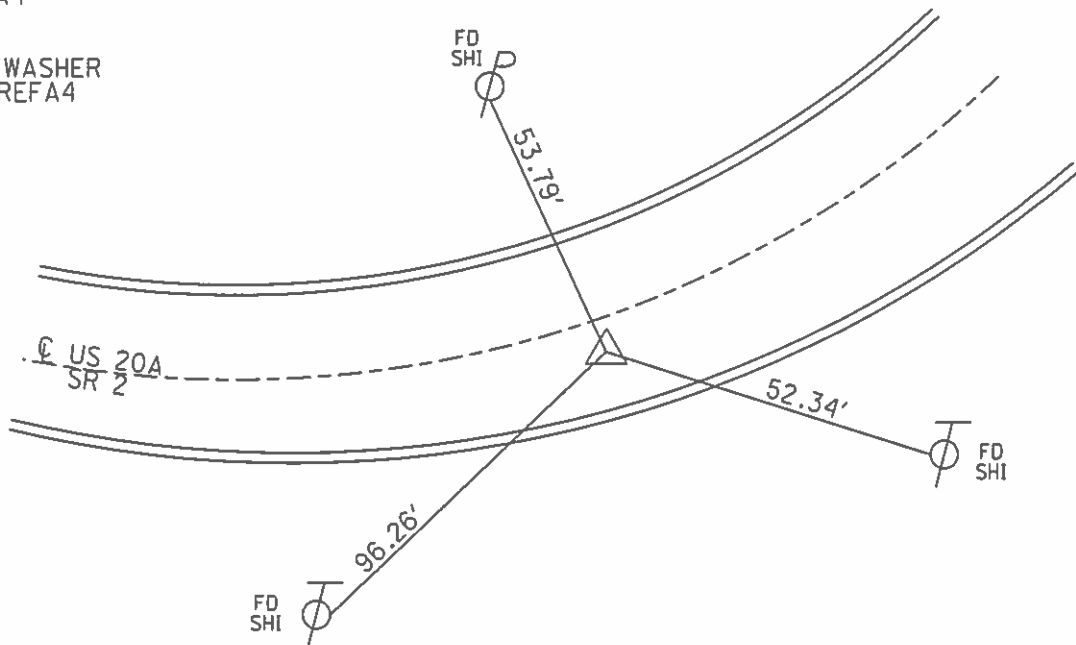

County LUCAS S.R. U.S. 20-A

Date 9-25-80

Township SWANTON

Weather CLEAR

Section 8



Temp. +68°

T7N, R5E

Personnel SMITH

BOWERS


MEAD

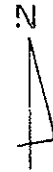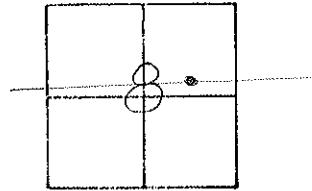

1.90

#4-A

Fd. MOBORA Mon. To
SURFACE
P.I. CURVE LEFT.
EAST OF GIRDHAM RD.
23.55' TO S. EDGE PAVE.
30.55' TO N. EDGE PAVE.

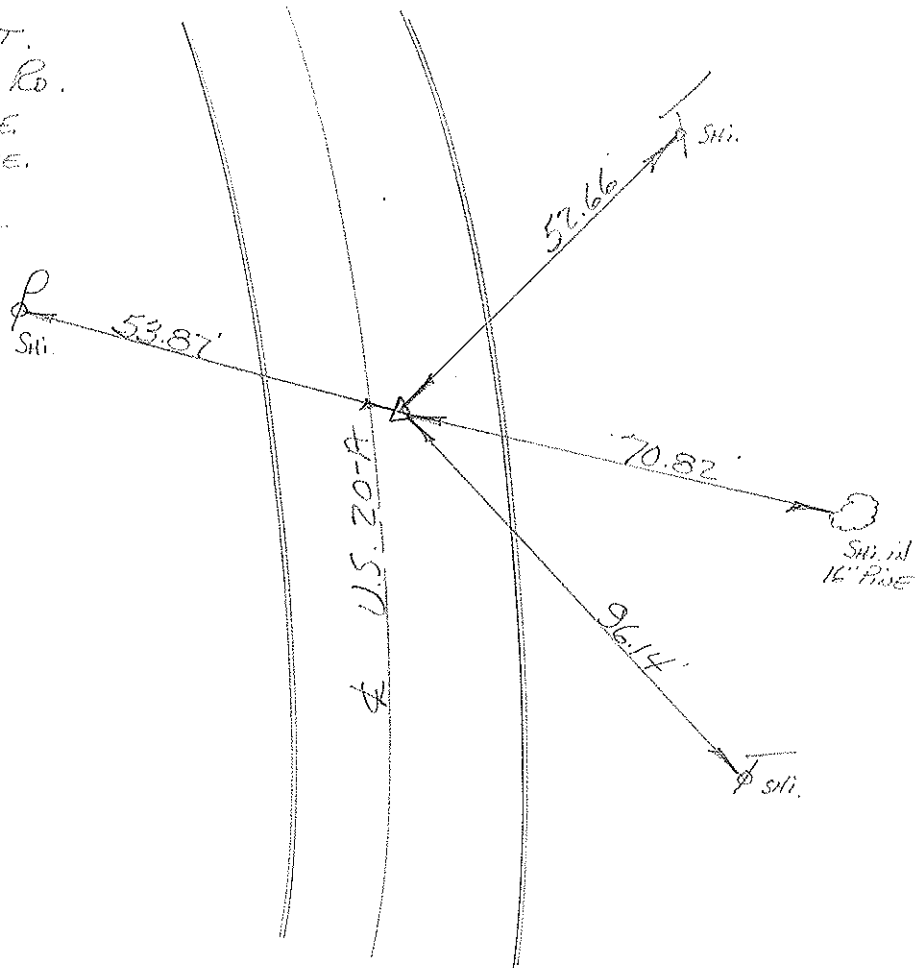

PERSONNEL TITLE PERSONNEL TITLE

COUNTY Lucas DATE 5 Nov. 64

Stang

f

Crow

S. R. #2-20A WEATHER Mild

SEC. TEMP. 60°

DESCRIPTION

References to Control Pts.

JOB NO.

LEFT

CENTER LINE

RIGHT

0+00 =	E Hallet Rd.	✓	27.73'	S.S.W. to Shiner in ♂
	Fd. Adj. Mon. 1" Below Surface		38.24'	N.W. to Shiner in ♂
			95.45'	N.E. to S.W. Cor. Mocombo
25+46.31 =	E S.R. #64	✓	70.55'	S.E. to N.W. Cor. Bldg.
	Fd. Adj. Mon. at Surface		38.58'	N.W. to Shiner in ♂
			40.42'	N.E. to Shiner in ♂
			78.33'	S.S.W. to Shiner in ♂
54+94.93 =	E Scott Rd.	✓	194.10'	S. to Brass Cop in Con. Mon.
	Fd. Adj. Mon. at Surface		72.42'	S.E. to N.W. Cor. House
			59.16'	S.W. to Shiner in 28" Tree
			72.16'	N.E. to S.W. Cor. Porch
			38.42'	N.W. to Shiner in ♂
78+32.31 =	E Girdham		54.68'	N.N.E. to S.W. Cor. Bldg. 1st. Block
	Fd. Adj. Mon. at Surface		94.24'	S.S.E. to Shiner in ♂
			104.66'	S.W. to N.E. Cor. Con. Wall
			66.52'	S.E. to N.W. Cor. Bldg. at sidewalk
100+10.86 =	P.I. Δ = 4952' Lt.	✓	82.98'	N.E. to Shiner in ♂
	Fd. Adj. Mon. at Surface		31.40'	N.N.W. to Shiner in 32" Tree
			76.44'	S.W. to Shiner in 11" Tree
			29.16'	S.S.E. to Shiner in ♂
104+87.00 =	E Wilkens Rd. N1		56.15'	N.E. to Shiner in ♂
	Fd. 1 1/2" I. Pin at Surface		49.95'	S.E. to Shiner in ♂
			37.76'	S.W. to Ref. Mon.
			80.88'	W.S.W. to Shiner in ♂
118+04.01 =	E Wilkens Rd. S1	✓	65.30'	N.E. to Shiner in 18" Tree
	Fd. R.R. Spt. to Surface		33.44'	N.N.W. to Shiner in ♂
			86.16'	S.S.W. to Shiner in ♂