


O.D.O.T. DISTRICT 2 SURVEY OFFICE (USE ONLY)


PERSONNEL _____ REFERENCE NO. 5 SHEET 6 OF 48
 NOTES HOMAN DATE 7/29/16 ROUTE US 20A
 H.C. HOMAN WEATHER CLOUDY COUNTY LUCAS
 R.C. KEFFER TEMP. 80°F TOWNSHIP SWANTON
 _____ SECTION 8
 _____ T 7 N R 5 E

TYPE MONUMENT SM RR SPIKE
~~ON SURFACE~~ - BELOW 2"
 LEFT - ☉ PAV'T - RIGHT ON
26.9' TO RT EDGE PAVEMENT
 S.L.M. 105+28

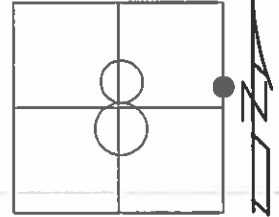

GRID: NORTHING: 701345.5995 EASTING: 1600721.366


RECORD:
 FD SM RR SPIKE
 6/15/03, DCH
 SET MAG/WASHER
 1/13/04, DCH
 FD MOBORA MON
 5" DOWN
 GPS, REFA4
 7/29/16
 SET MAG/WASHER
 GPS, NEWREFA4
 10/05/16

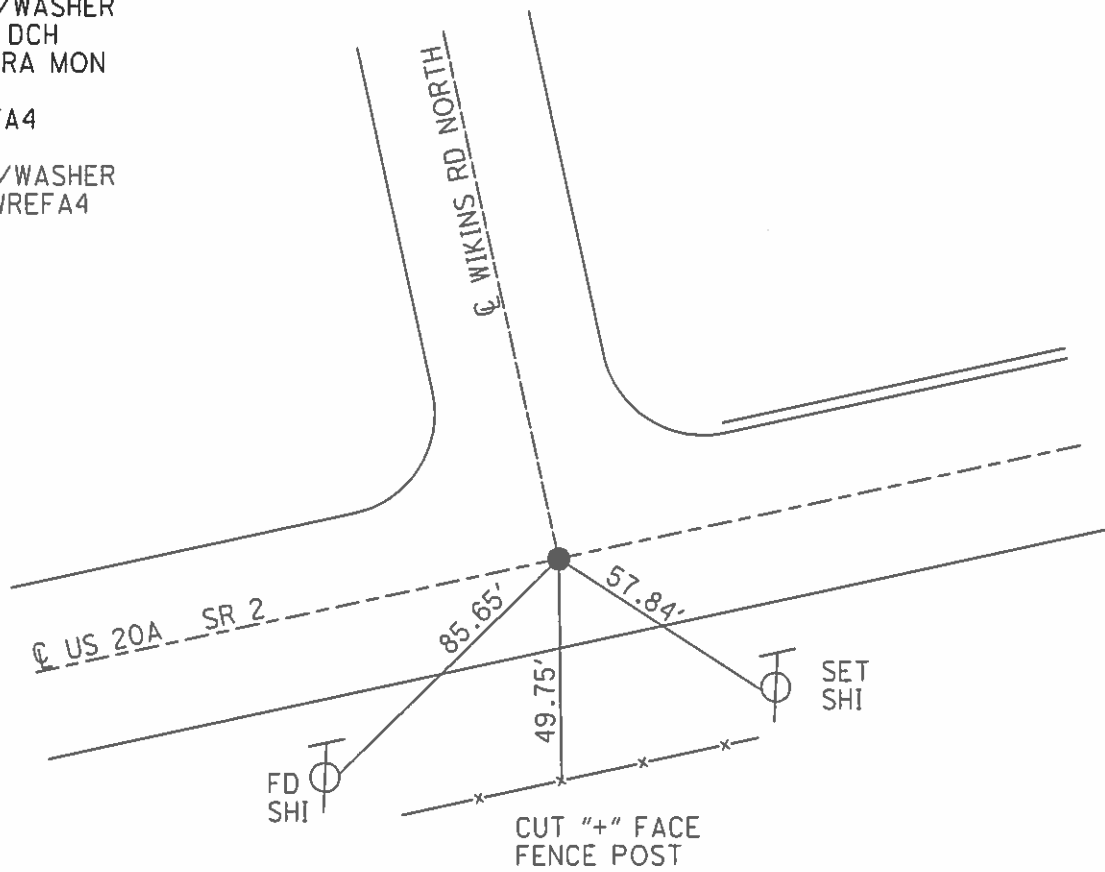


O.D.O.T. DISTRICT 2 SURVEY OFFICE (USE ONLY)

PERSONNEL _____ REFERENCE NO. 5 SHEET 6 OF 31
 NOTES HOMAN DATE 7/29/16 ROUTE SR 2
 H.C. HOMAN WEATHER CLOUDY COUNTY LUCAS
 R.C. RYALL TEMP. 80°F TOWNSHIP SWANTON
 _____ SECTION 8
 _____ T 7 N R 5 E

TYPE MONUMENT SM RR SPIKE
~~ON SURFACE~~ - BELOW 2"
 LEFT - ☉ PAV'T - RIGHT ON
26.9' TO RT EDGE PAVEMENT
 S.L.M. 105+28
 GRID: NORTHING: 701345.5995 EASTING: 1600721.366

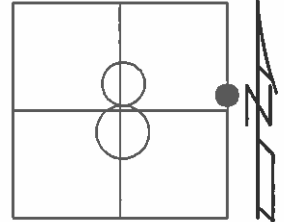

RECORD:
 FD SM RR SPIKE
 6/15/03, DCH
 SET MAG/WASH
 1/13/04 DCH
 FD MOBORA MON
 5" DOWN
 GPS, REFA4
 7/29/16
 SET MAG/WASHER
 GPS, NEWREFA4
 10/05/16

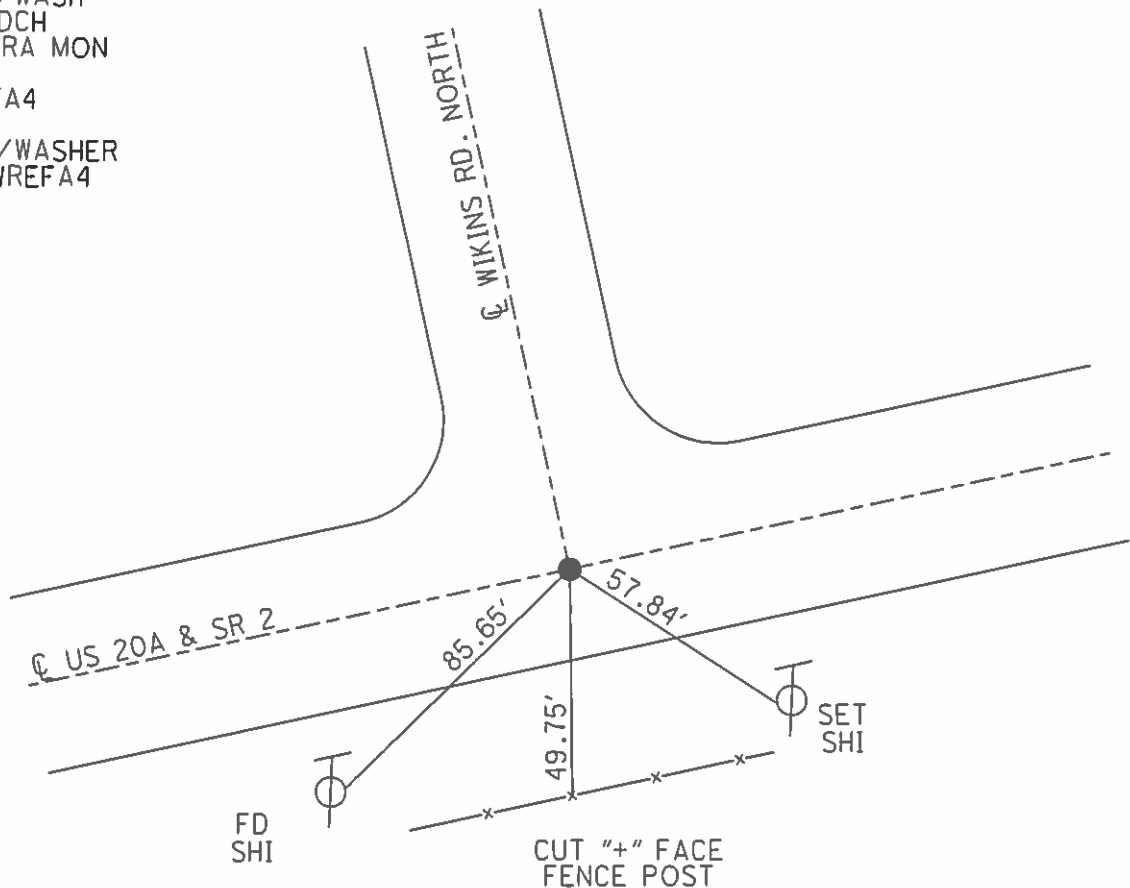


O.D.O.T. DISTRICT 2 SURVEY OFFICE (USE ONLY)

PERSONNEL _____ REFERENCE NO. 5 SHEET 6 OF 11

NOTES HOMAN DATE 7-29-16 ROUTE SR 2
H.C. HOMAN WEATHER CLOUDY COUNTY LUCAS
R.C. RYALL TEMP. 80°F TOWNSHIP SWANTON
SECTION 8
T 7 N R 5 E

TYPE MONUMENT SM RR SPIKE
~~ON SURFACE~~ - BELOW 2"
LEFT - ☉ PAV'T - RIGHT ON
26.9' TO RT EDGE PAVEMENT
S.L.M. 105+28

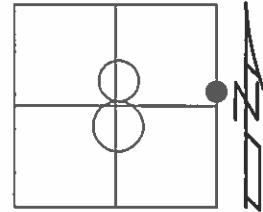


Grid: Northing: 701345.5995 Easting: 1600721.366

RECORD:
FD SM RR SPIKE
6-15-03, DCH

SET MAG/WASH
1-13-04 DCH

FD MOBORA MON
5" DOWN
GPS, REFA4
7-29-16

SET MAG/WASHER
GPS, NEWREFA4
10-05-16

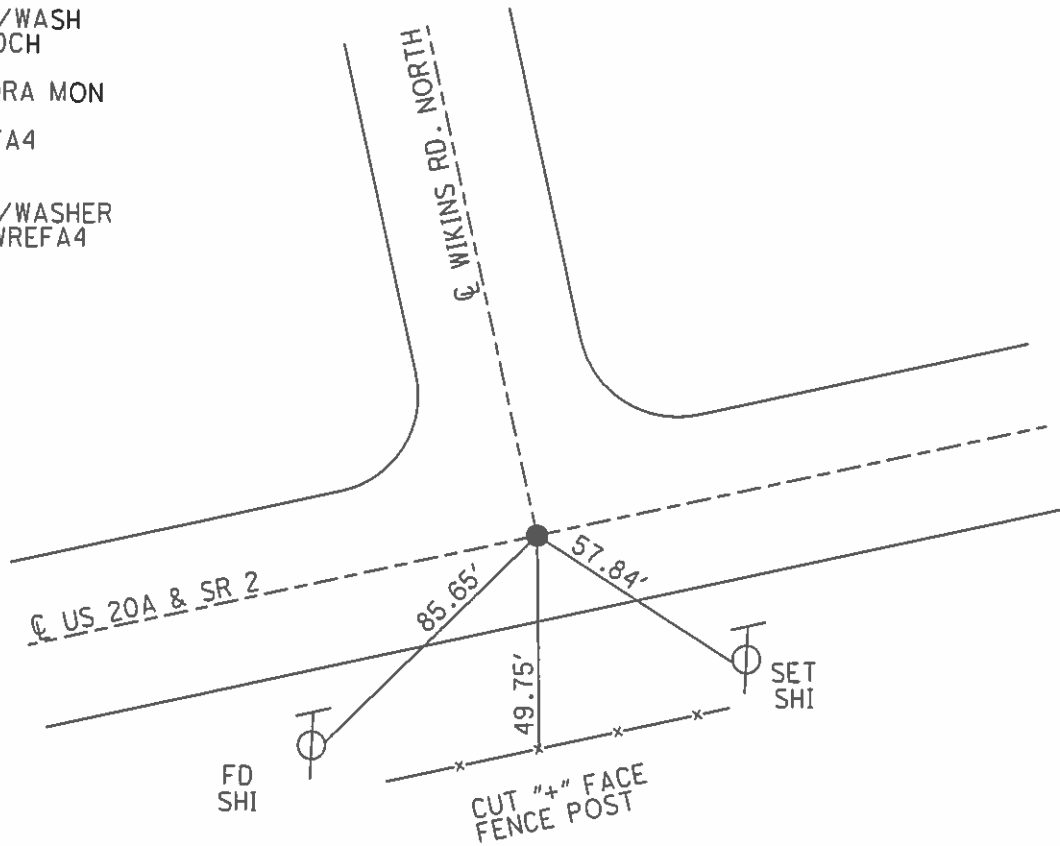


PERSONNEL	TITLE	PERSONNEL	TITLE	COUNTY	DATE
Tomsic					Dec. 14-64
Neuser				S. R.	WEATHER cloudy
Ando				SEC.	TEMP. 30°
Vanyo					


DESCRIPTION Short on S.R. #2 - 20A JOB NO. _____

Short #19 pipe at 33+03 - 24' Rt. is 8" F.T. and continues under surface to C.B. 36+09 Rt. This 8" F.T. is connected to 12" concrete pipe stub going West from C.B. at 36+09. Made check by digging down to pipe and found joint.

Short #20

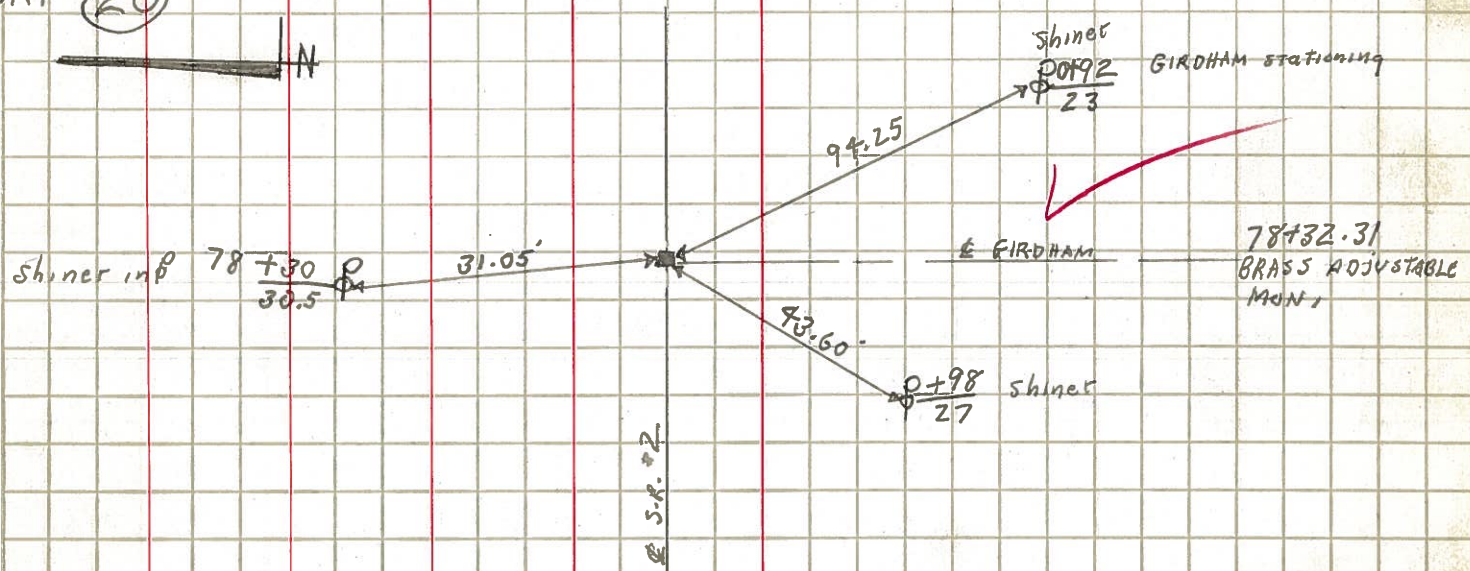

Short #22

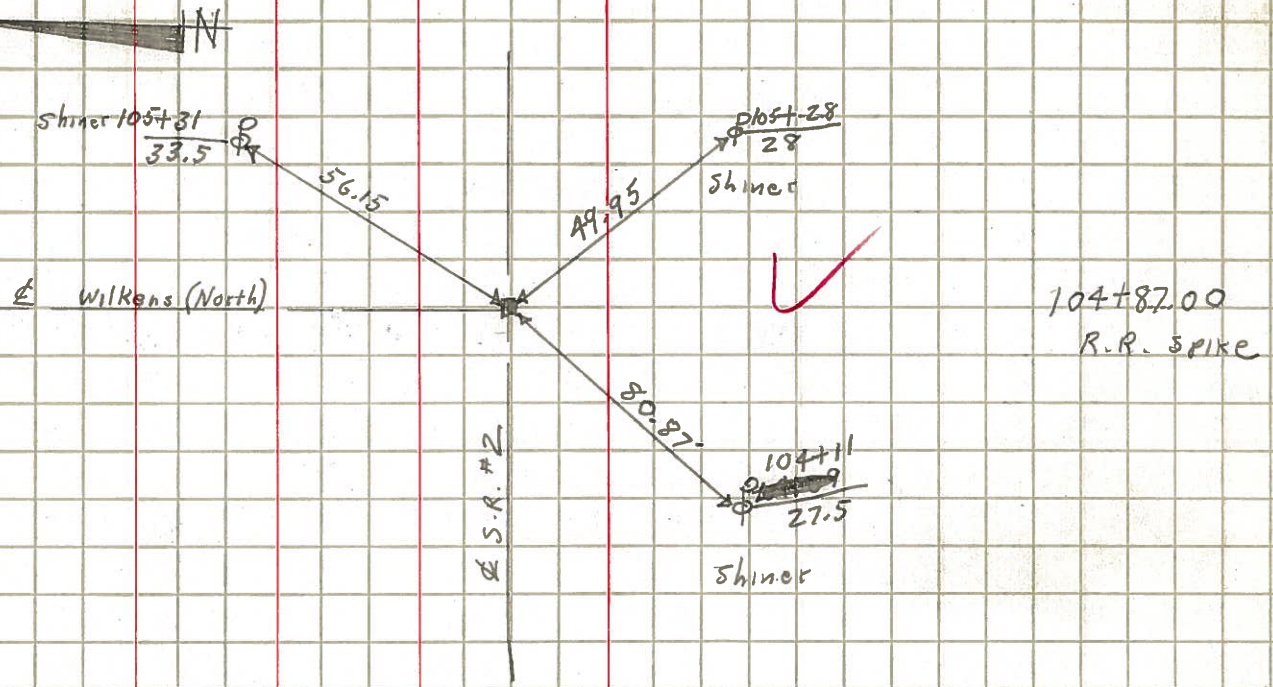

PERSONNEL TITLE PERSONNEL TITLE

COUNTY Lucas DATE 5 Nov. 64

Stang

f

Crow

S. R. #2-20A WEATHER Mild

SEC. TEMP. 60°

DESCRIPTION

References to Control Pts.

JOB NO.

LEFT

CENTER LINE

RIGHT

0+00 =	E Hallet Rd. Fd. Adj. Mon. 1" Below Surface	✓	27.73' S.S.W. to Shiner in ♂ 38.24' N.W. to Shiner in ♂ 95.45' N.E. to S.W. Cor. Mocombo
25+46.31 =	E S.R. #64 Fd. Adj. Mon. at Surface	✓	70.55' S.E. to N.W. Cor. Bldg. 38.58' N.W. to Shiner in ♂ 40.42' N.E. to Shiner in ♂ 78.33' S.S.W. to Shiner in ♂
54+94.93 =	E Scott Rd. Fd. Adj. Mon. at Surface	✓	194.10' S. to Brass Cop in Con. Mon. 72.42' S.E. to N.W. Cor. House 59.16' S.W. to Shiner in 28" Tree 72.16' N.E. to S.W. Cor. Porch 38.42' N.W. to Shiner in ♂
78+32.31 =	E Girdham Fd. Adj. Mon. at Surface		54.68' N.N.E. to S.W. Cor. Bldg, 1st. Block 94.24' S.S.E. to Shiner in ♂ 104.66' S.W. to N.E. Cor. Con. Wall 66.52' S.E. to N.W. Cor. Bldg. at sidewalk
100+10.86 =	P.I. Δ = 4952' Lt. Fd. Adj. Mon. at Surface	✓	82.98' N.E. to Shiner in ♂ 31.40' N.N.W. to Shiner in 32" Tree 76.44' S.W. to Shiner in 11" Tree 29.16' S.S.E. to Shiner in ♂
104+87.00 =	E Wilkens Rd. M. Fd. 1 1/2" I. Pin at Surface		56.15' N.E. to Shiner in ♂ 49.95' S.E. to Shiner in ♂ 37.76' S.W. to Ref. Mon. 80.88' W.S.W. to Shiner in ♂
118+04.01 =	E Wilkens Rd. S. Fd. R.R. Spt. to Surface	✓	65.30' N.E. to Shiner in 18" Tree 33.44' N.N.W. to Shiner in ♂ 86.16' S.S.W. to Shiner in ♂