


O.D.O.T. DISTRICT 2 SURVEY OFFICE (USE ONLY)


PERSONNEL _____ REFERENCE NO. 16 SHEET 16 OF 48

NOTES STONE DATE 7/16/71 ROUTE US 20A
 H.C. MICHALAK WEATHER WARM COUNTY LUCAS
 R.C. SCHRODER TEMP. 74° TOWNSHIP SWANTON
 _____ KEFFER _____ SECTION 10
 _____ T 7 N R 9 E

TYPE MONUMENT MONBOX, 1" IPIN
 ON SURFACE - ~~BELOW~~ ON _____
 LEFT - ☉ PAV'T - RIGHT - _____
 - _____ TO - _____ EDGE PAVEMENT
 S.L.M. 239+98.26

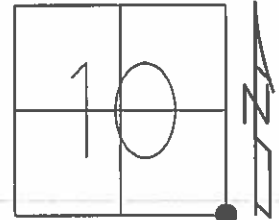

GRID: NORTHING: 697903.988 EASTING: 1611255.886

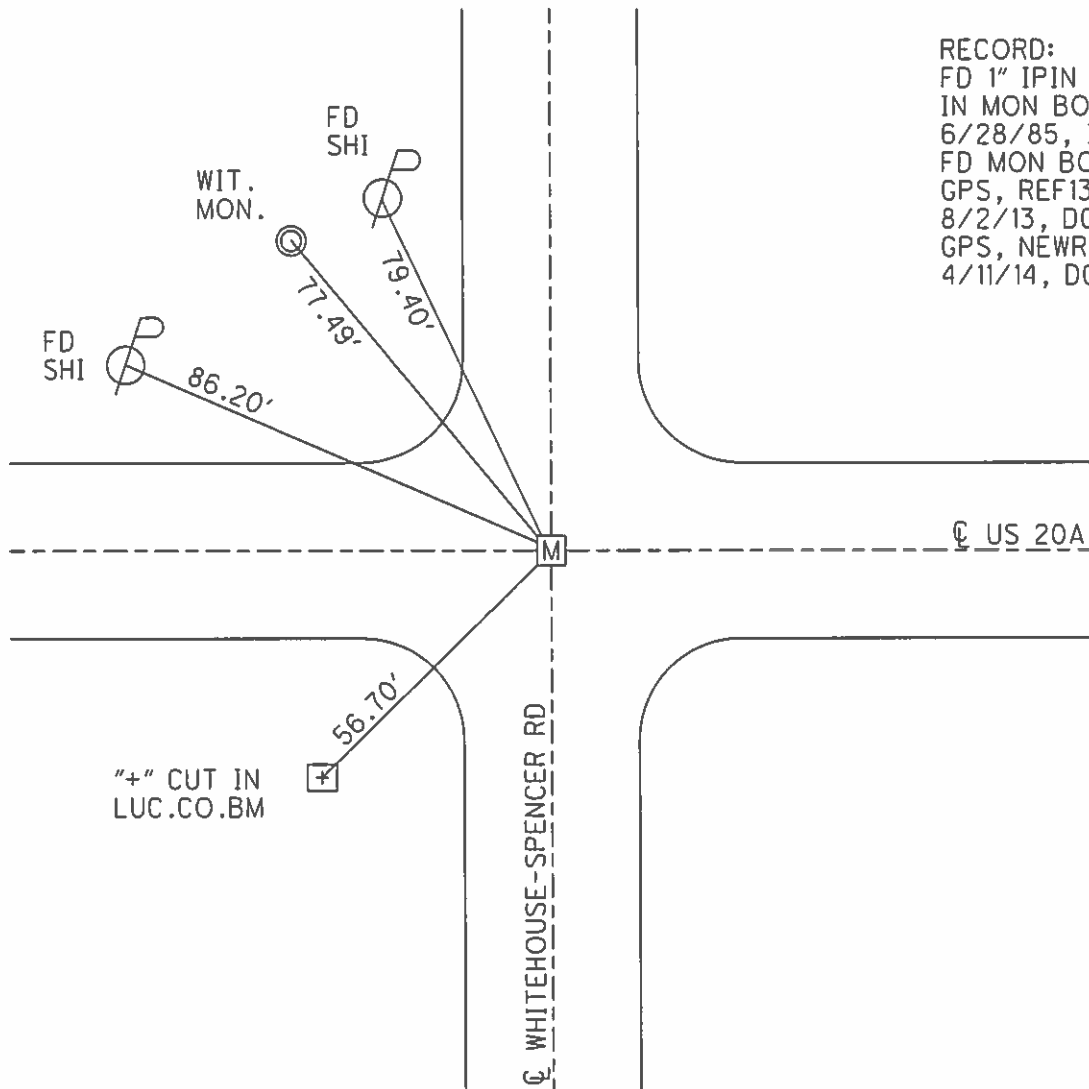

RECORD:
 FD 1" IPIN
 IN MON BOX
 6/28/85, IS
 FD MON BOX
 GPS, REF13
 8/2/13, DCH
 GPS, NEWREF13
 4/11/14, DCH



O.D.O.T. DISTRICT 2 SURVEY OFFICE (USE ONLY)

PERSONNEL _____ REFERENCE NO. 16 SHEET 10 OF 42

NOTES STONE DATE 7/16/71 ROUTE US 20A
 H.C. MICHALAK WEATHER WARM COUNTY LUCAS
 R.C. SCHRODER TEMP. 74° TOWNSHIP SWANTON
 SECTION 10
 T 7 N R 9 E

TYPE MONUMENT MONBOX, 1" IPIN
 ON SURFACE - ~~BELOW~~ ON
 LEFT - ☉ PAV'T - RIGHT - _____
 - TO - EDGE PAVEMENT
 S.L.M. 239+98.26

Grid: Northing: 697903.988 Easting: 1611255.886

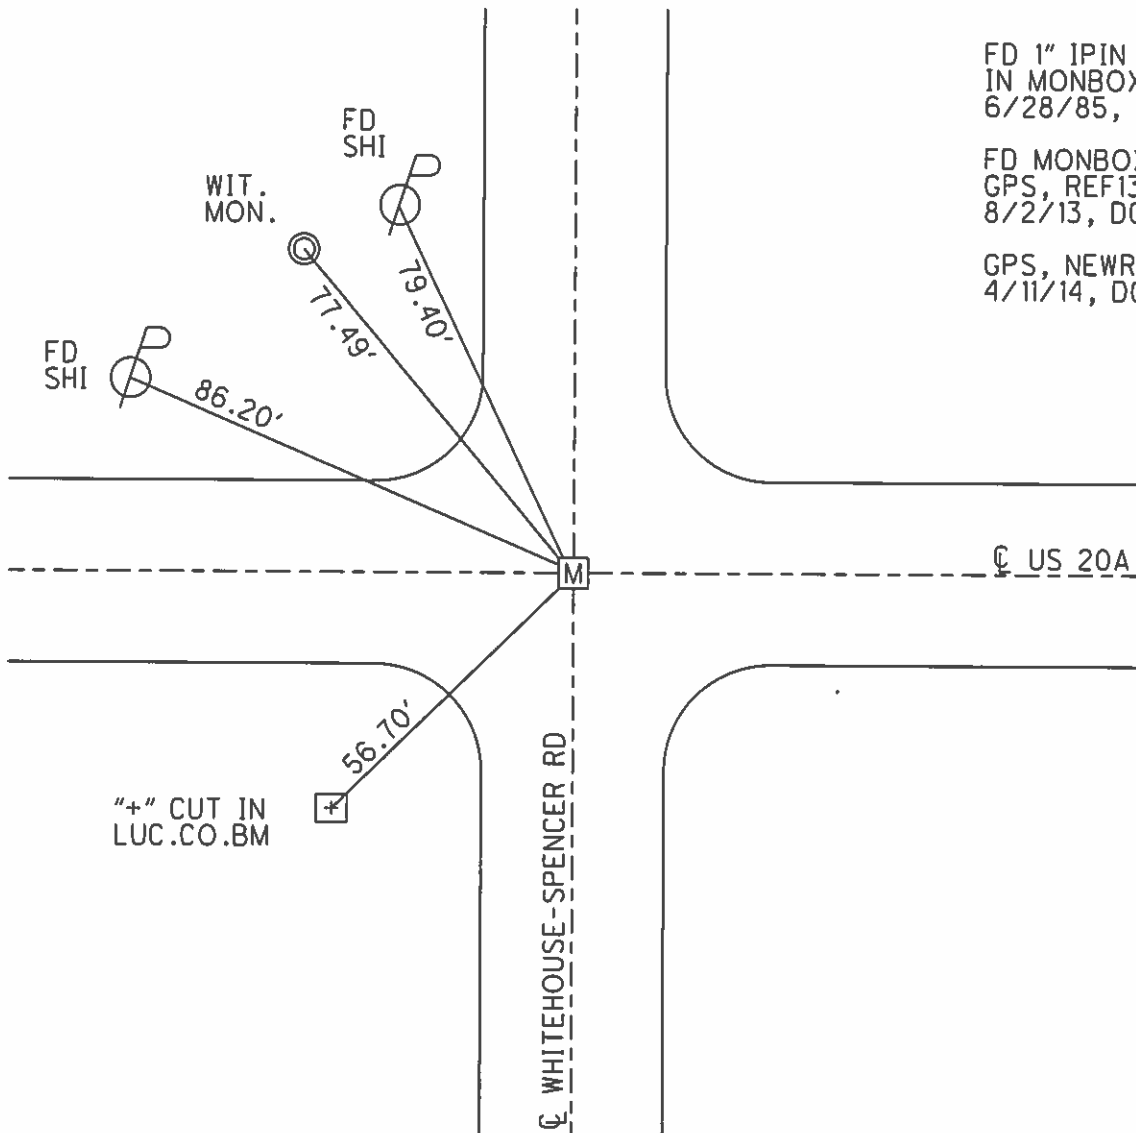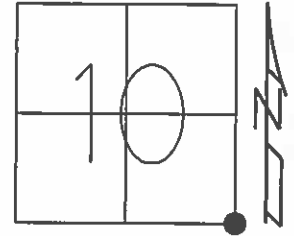

FD 1" IPIN
 IN MONBOX
 6/28/85, I.S.

FD MONBOX
 GPS, REF13
 8/2/13, DCH

GPS, NEWREF13
 4/11/14, DCH