



O.D.O.T. DISTRICT 2 SURVEY OFFICE (USE ONLY)

PERSONNEL _____ REFERENCE NO. 21 AB SHEET 19 OF 42
 NOTES WESTFALL DATE 8/5/13 ROUTE US 20A
 H.C. ROUSOS WEATHER SUNNY COUNTY LUCAS
 R.C. WESTFALL TEMP. 67° TOWNSHIP MONCLOVA
 _____ SECTION 13
 _____ T 7 N R 9 E

TYPE MONUMENT R.R.SPIKE
~~ON SURFACE~~ - BELOW 2"
 LEFT - ☉ PAV'T - RIGHT - _____
 - TO - EDGE PAVEMENT
 S.L.M. 306+67.27
 Grid: Northing: 697555.606 Easting: 1617872.992

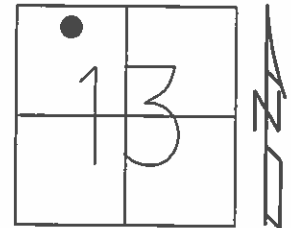

FD SHI
18"

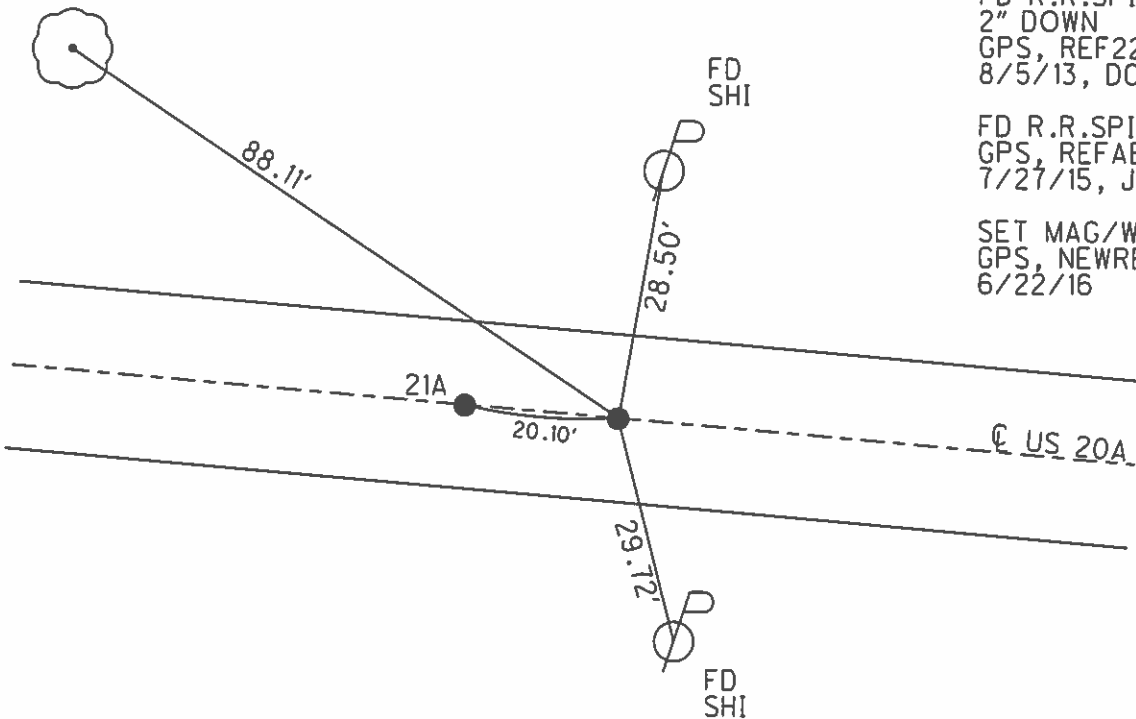

RECORD:
 FD R.R.SPIKE
 3" BELOW
 7/1/85, I.S.
 FD R.R.SPIKE
 2" DOWN
 GPS, REF22
 8/5/13, DCH
 FD R.R.SPIKE
 GPS, REFAB21
 7/27/15, JFO
 SET MAG/W
 GPS, NEWREFAB21
 6/22/16