


O.D.O.T. DISTRICT 2 SURVEY OFFICE (USE ONLY)


PERSONNEL \_\_\_\_\_ REFERENCE NO. 32 SHEET 37 OF 48  
 NOTES WESTFALL DATE 8/7/13 ROUTE US 20A  
 H.C. ROUSOS WEATHER FAIR COUNTY LUCAS  
 R.C. WESTFALL TEMP. 73° TOWNSHIP MONCLOVA  
 \_\_\_\_\_ KEFFER \_\_\_\_\_ SECTION 33  
 \_\_\_\_\_ T 2

TYPE MONUMENT P.K.SHANK  
 ON SURFACE - ~~BELOW~~ ON \_\_\_\_\_  
 LEFT - ☉ PAV'T - RIGHT - \_\_\_\_\_  
 - TO - EDGE PAVEMENT \_\_\_\_\_  
 S.L.M. 493+60.03

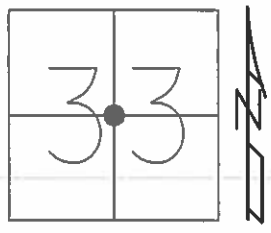

GRID: NORTHING: 697066.543 EASTING: 1636553.473

RECORD:  
 FD SM.RR SPIKE  
 3" DEEP  
 7/1/85, IS  
 FD P.K.SHANK  
 GPS, REF32  
 8/5/13, DCH  
 SET MAG/WASHER  
 GPS, NEWREF32  
 4/16/14, DCH

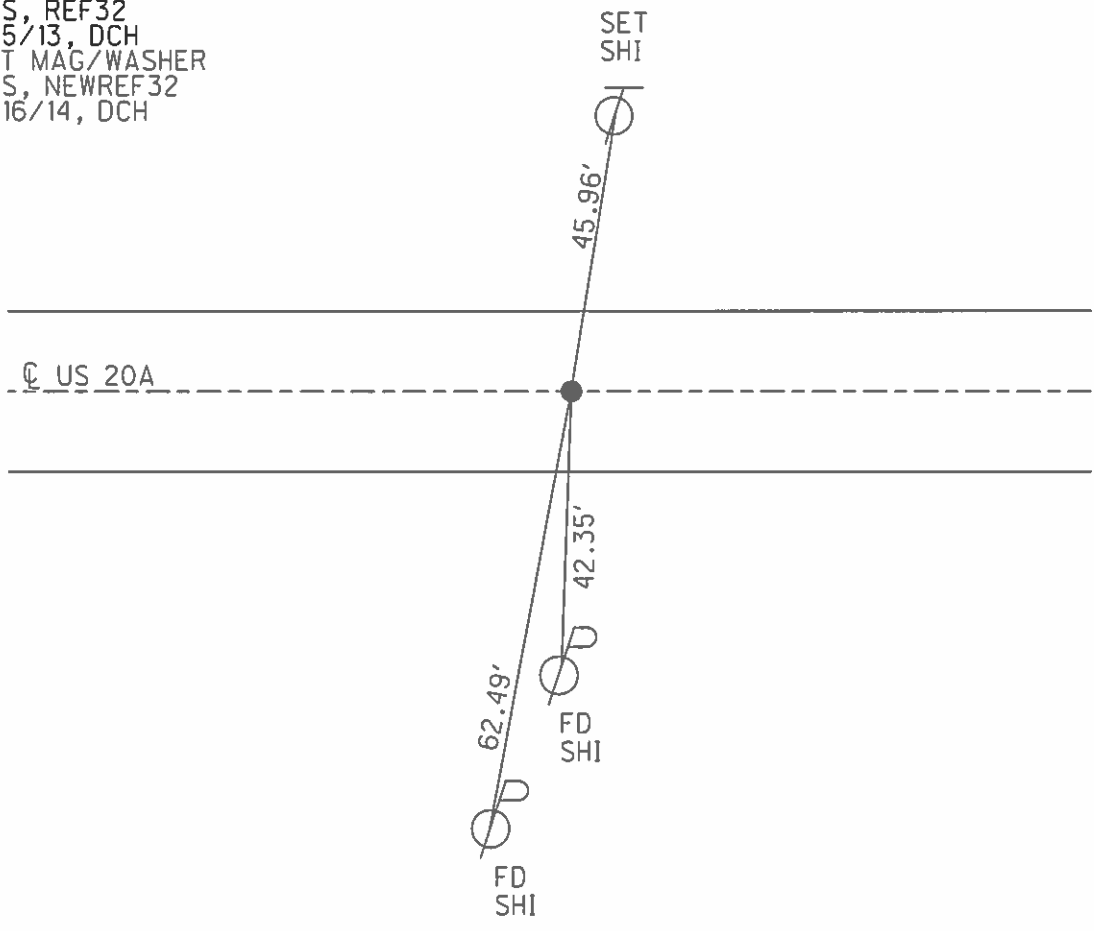


O.D.O.T. DISTRICT 2 SURVEY OFFICE (USE ONLY)

PERSONNEL \_\_\_\_\_ REFERENCE NO. 32 SHEET 31 OF 42

NOTES WESTFALL DATE 8/7/13 ROUTE US 20A  
 H.C. ROUSOS WEATHER FAIR COUNTY LUCAS  
 R.C. WESTFALL TEMP. 73° TOWNSHIP MONCLOVA  
 \_\_\_\_\_ SECTION 33  
 \_\_\_\_\_ T 2

TYPE MONUMENT P.K.SHANK  
 ON SURFACE - ~~BELOW~~ ON  
 LEFT - ☉ PAV'T - RIGHT -  
\_\_\_\_\_ TO \_\_\_\_\_ EDGE PAVEMENT  
 S.L.M. 493+60.03

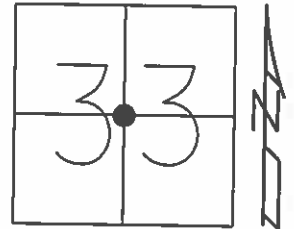


Grid: Northing: 697066.543 Easting: 1636553.473

RECORD:  
 FD SM.R.R.SPIKE  
 3" DEEP  
 7/1/85, I.S.

FD P.K.SHANK  
 GPS, REF32  
 8/5/13, DCH

SET MAG/WASHER  
 GPS, NEWREF32  
 4/16/14, DCH

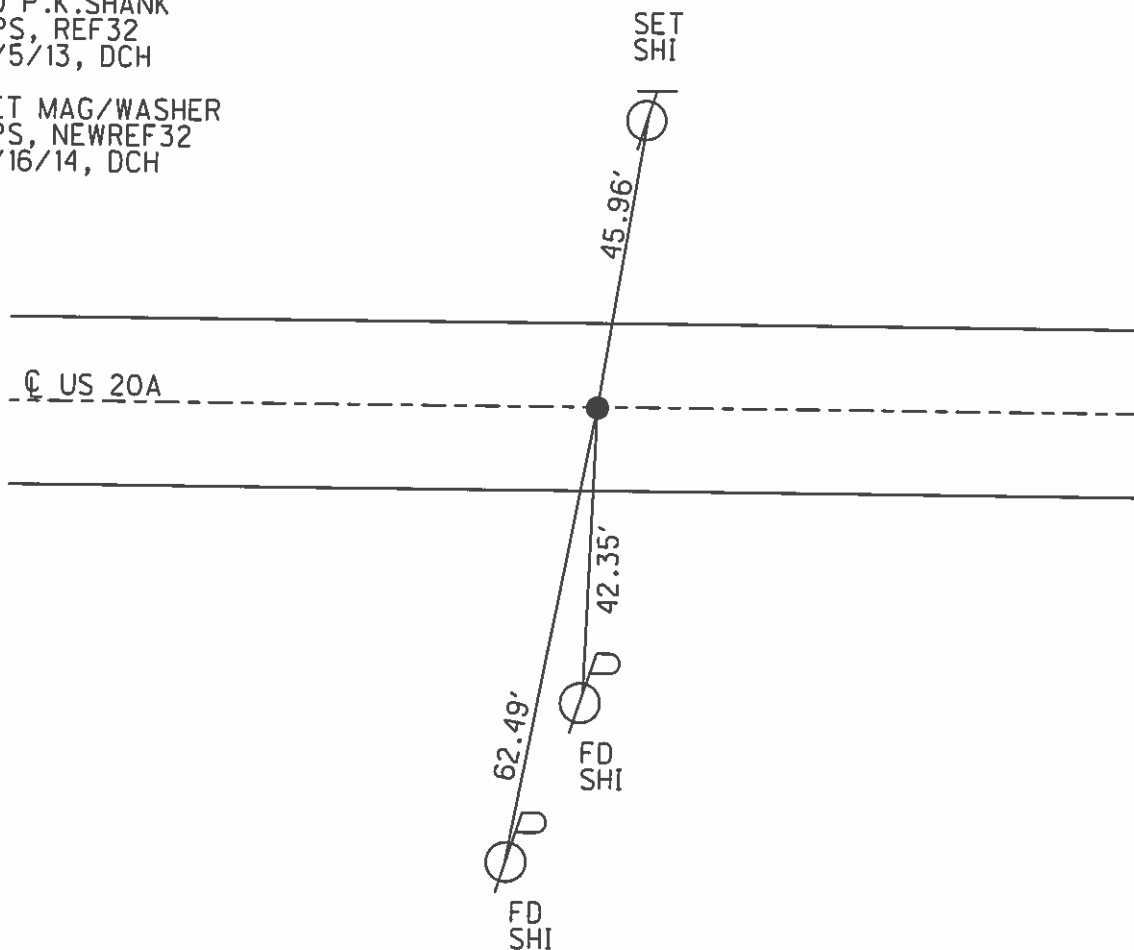

PERSONNEL	TITLE	PERSONNEL	TITLE
Stone	Notes		
Michalak	X		
Schroeder	H.C.		
Farr	FD		

COUNTY Lucas DATE 28 July 71  
 S. R. US-20-A WEATHER Fair  
 SEC. Alban Rd. - East TEMP. 75°

DESCRIPTION Alignment LEFT CENTER LINE RIGHT JOB NO.

