
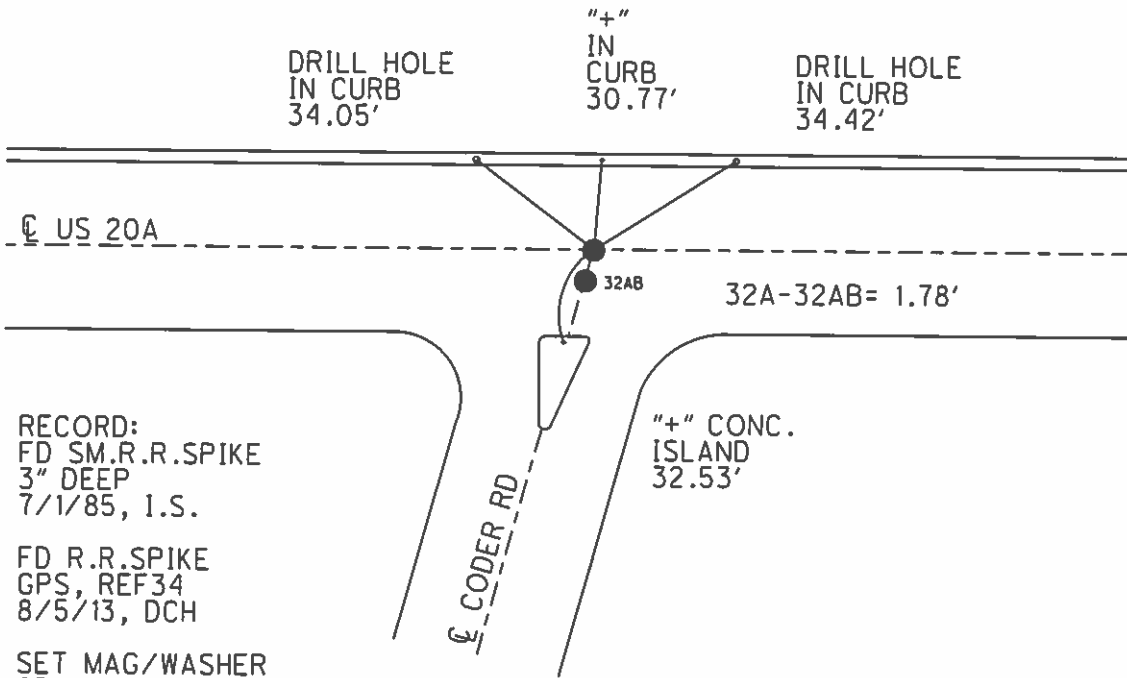


O.D.O.T. DISTRICT 2 SURVEY OFFICE (USE ONLY)

PERSONNEL _____ REFERENCE NO. 32 A SHEET 32 OF 42
 NOTES WESTFALL DATE 8/6/13 ROUTE US 20A
 H.C. ROUSOS WEATHER FAIR COUNTY LUCAS
 R.C. WESTFALL TEMP. 71° TOWNSHIP MONCLOVA
 _____ SECTION 33
 _____ T 2

TYPE MONUMENT R.R.SPIKE
~~ON SURFACE~~ - BELOW 1 1/2"
 LEFT - ☉ PAV'T - RIGHT - _____
 - _____ TO _____ EDGE PAVEMENT
 S.L.M. 505+78.35
 Grid: Northing: 697049.227 Easting: 1637771.935

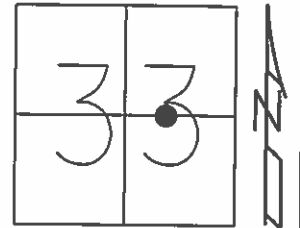

RECORD:
 FD SM.R.R.SPIKE
 3" DEEP
 7/1/85, I.S.
 FD R.R.SPIKE
 GPS, REF34
 8/5/13, DCH
 SET MAG/WASHER
 GPS, NEWREF33
 4/16/14, DCH

PERSONNEL	TITLE	PERSONNEL	TITLE	COUNTY	DATE	S. R.	WEATHER	TEMP.
Stone	Notes			Lucas	20 July 71	US-20-A	Fair	75°
Michalek	π							
Schroder	H.C.							
Farr	RR					Alton Rd. - East		

DESCRIPTION: Alignment LEFT CENTER LINE RIGHT JOB NO.

