


O.D.O.T. DISTRICT 2 SURVEY OFFICE (USE ONLY)


PERSONNEL \_\_\_\_\_ REFERENCE NO. 32 B SHEET 40 OF 48  
 NOTES WESTFALL DATE 8/6/13 ROUTE US 20A  
 H.C. ROUSOS WEATHER FAIR COUNTY LUCAS  
 R.C. WESTFALL TEMP. 71° TOWNSHIP MONCLOVA  
 \_\_\_\_\_ KEFFER \_\_\_\_\_ SECTION 33  
 \_\_\_\_\_ T 2

TYPE MONUMENT P.K.NAIL  
 ON SURFACE - ~~BELOW~~ \_\_\_\_\_ ON \_\_\_\_\_  
 LEFT - ☉ PAV'T - RIGHT - \_\_\_\_\_  
 \_\_\_\_\_ TO \_\_\_\_\_ EDGE PAVEMENT  
 S.L.M. 506+73.53

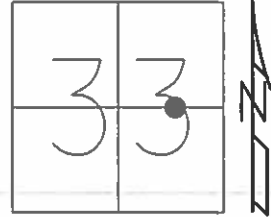

GRID: NORTHING: 697048.800 EASTING: 1637866.916


RECORD:  
 SET P.K.NAIL  
 5/1/85, IS  
 FD P.K.NAIL  
 GPS, REF35  
 8/6/13, DCH  
 SET MAG/WASHER  
 GPS, NEWREF35  
 4/16/14, DCH

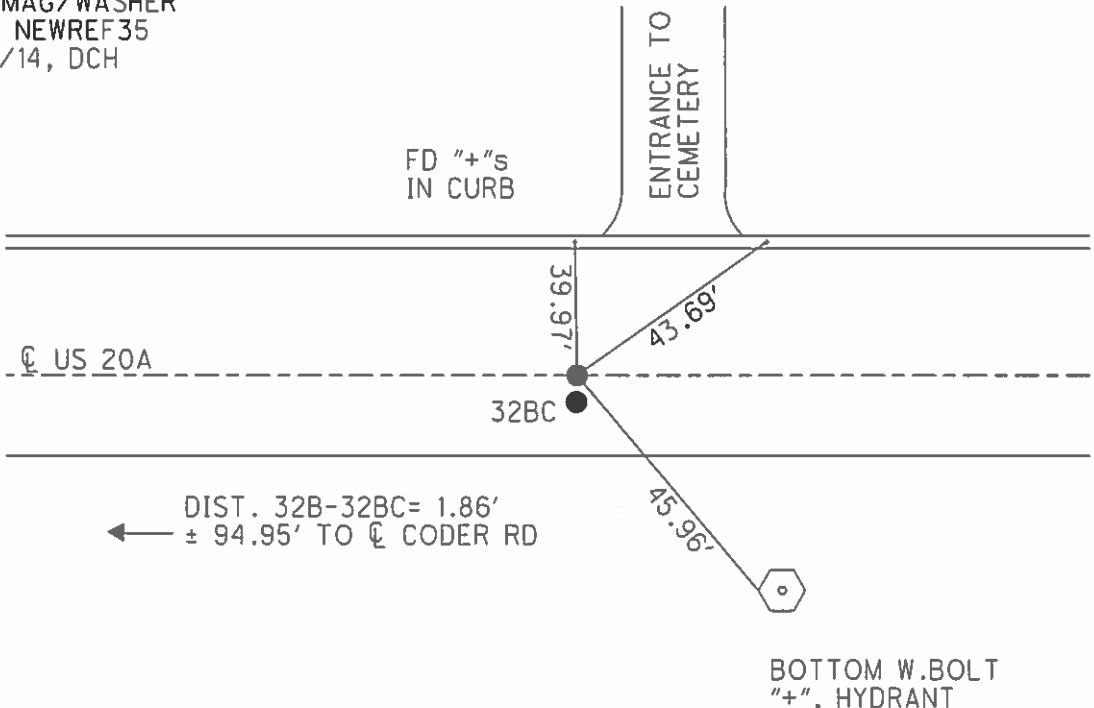

O.D.O.T. DISTRICT 2 SURVEY OFFICE (USE ONLY)

PERSONNEL \_\_\_\_\_ REFERENCE NO. 32 B SHEET 34 OF 42  
 NOTES WESTFALL DATE 8/6/13 ROUTE US 20A  
 H.C. ROUSOS WEATHER FAIR COUNTY LUCAS  
 R.C. WESTFALL TEMP. 71° TOWNSHIP MONCLOVA  
 \_\_\_\_\_ SECTION 33  
 \_\_\_\_\_ T 2


TYPE MONUMENT P.K.NAIL  
 ON SURFACE - ~~BELOW~~ ON \_\_\_\_\_  
 LEFT - ☉ PAV'T - RIGHT - \_\_\_\_\_  
 \_\_\_\_\_ TO \_\_\_\_\_ EDGE PAVEMENT  
 S.L.M. 506+73.53  
 Grid: Northing: 697048.800 Easting: 1637866.916

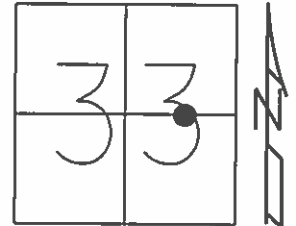

RECORD:  
 SET P.K.NAIL  
 5/1/85, I.S.

FD P.K.NAIL  
 GPS, REF35  
 8/6/13, DCH

SET MAG/WASHER  
 GPS, NEWREF35  
 4/16/14, DCH

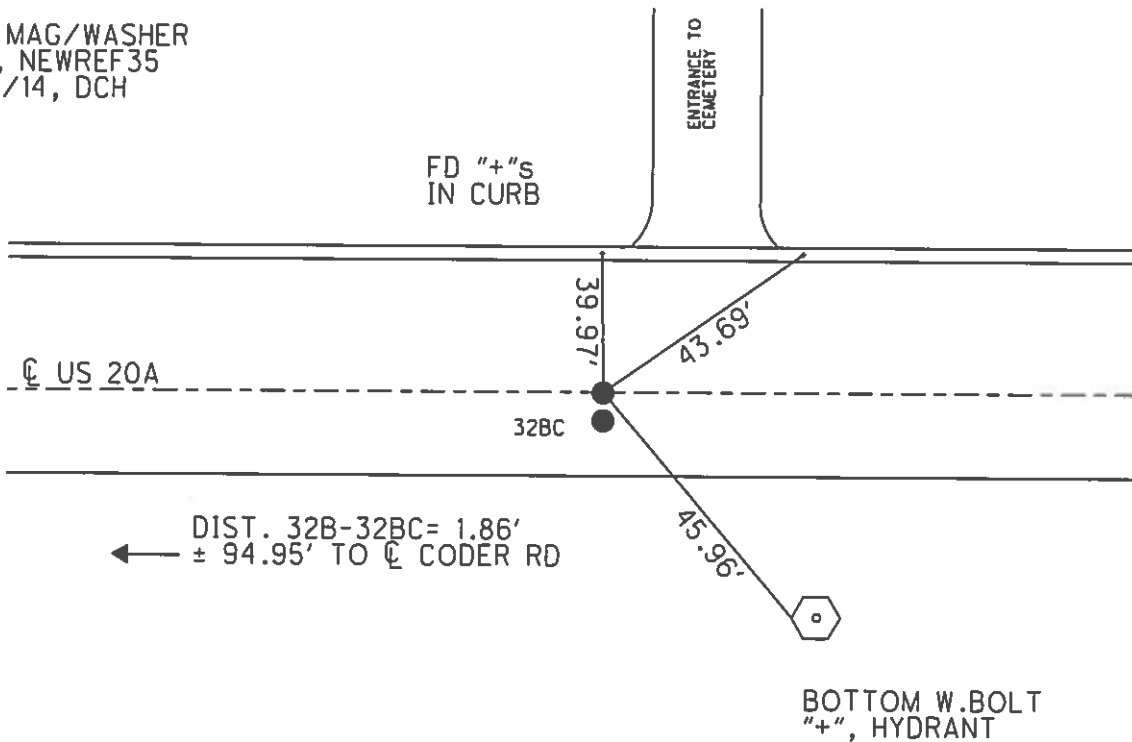

PERSONNEL	TITLE	PERSONNEL	TITLE	COUNTY	DATE
Stone	Notes			Lucas	20 July 71
Michalek	π			U.S. 20-A	Weather Fair
Schroeder	H.C.			SEC. Alton Rd. - East	TEMP. 75°
Farr	RS				

DESCRIPTION: Alignment LEFT CENTER LINE RIGHT JOB NO.

