


O.D.O.T. DISTRICT 2 SURVEY OFFICE (USE ONLY)


PERSONNEL _____ REFERENCE NO. 33 SHEET 43 OF 48
NOTES WESTFALL DATE 8/6/13 ROUTE US 20A
H.C. ROUSOS WEATHER FAIR COUNTY LUCAS
R.C. WESTFALL TEMP. 71° TOWNSHIP MONCLOVA
KEFFER SECTION 33
T 2

TYPE MONUMENT R.R.SPIKE
~~ON SURFACE~~ - BELOW 1 1/2"
LEFT - ☉ PAV'T - RIGHT -
- TO - EDGE PAVEMENT
S.L.M. 519+76.72

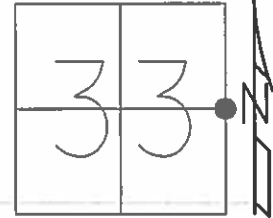

GRID: NORTHING: 696926.462 EASTING: 1639159.64



RECORD:
FD SM. RR SPIKE
3" DEEP
6/28/85, IS
FD R.R.SPIKE
1 1/2" DOWN
GPS, REF38
8/6/13, DCH
SET MAG/WASHER
GPS, NEWREF38
4/17/14, DCH

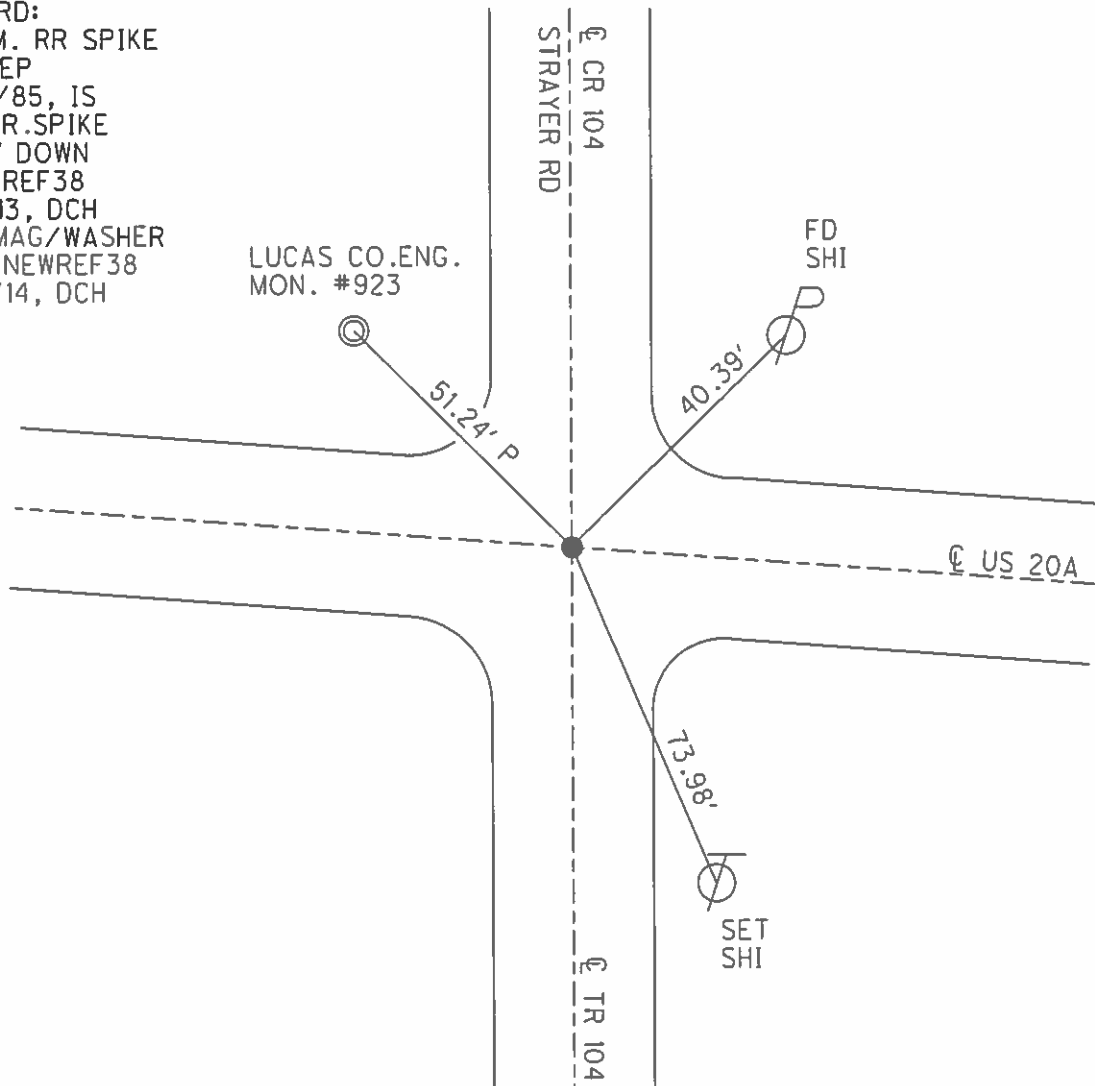

O.D.O.T. DISTRICT 2 SURVEY OFFICE (USE ONLY)

PERSONNEL _____ REFERENCE NO. 33 SHEET 37 OF 42
 NOTES WESTFALL DATE 8/6/13 ROUTE US 20A
 H.C. ROUSOS WEATHER FAIR COUNTY LUCAS
 R.C. WESTFALL TEMP. 71° TOWNSHIP MONCLOVA
 _____ SECTION 33
 _____ T 2

TYPE MONUMENT R.R.SPIKE
~~ON SURFACE~~ - BELOW 1 1/2"
 LEFT - ☉ PAV'T - RIGHT - _____
 - TO - EDGE PAVEMENT
 S.L.M. 519+76.72
 Grid: Northing: 696926.462 Easting: 1639159.64

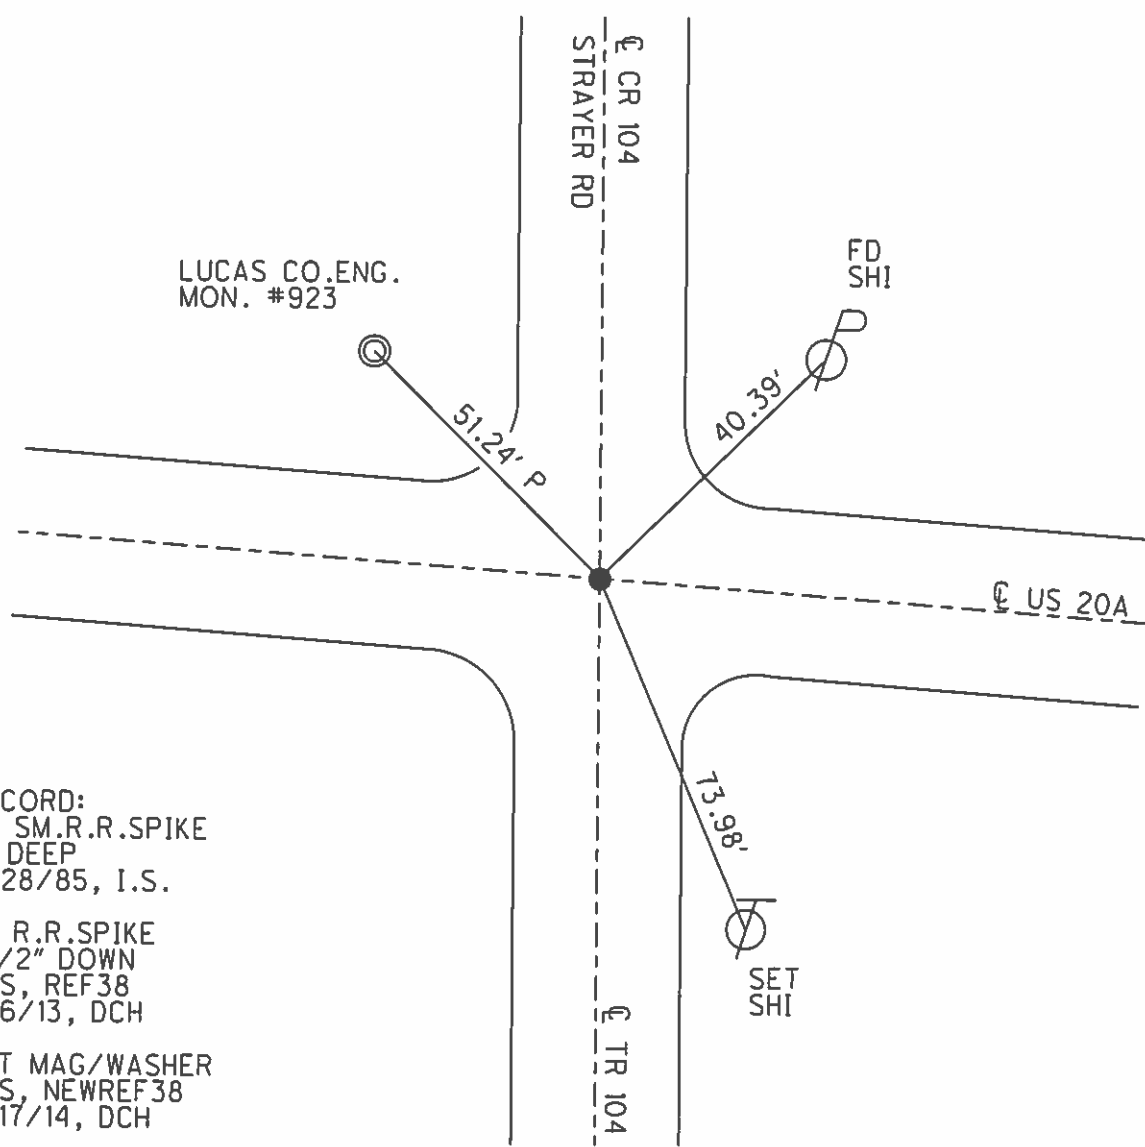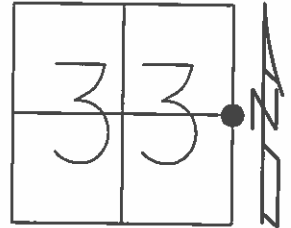


RECORD:
 FD SM.R.R.SPIKE
 3" DEEP
 6/28/85, I.S.

 FD R.R.SPIKE
 1 1/2" DOWN
 GPS, REF38
 8/6/13, DCH

 SET MAG/WASHER
 GPS, NEWREF38
 4/17/14, DCH

PERSONNEL	TITLE	PERSONNEL	TITLE	COUNTY	DATE	WEATHER	TEMP.
S. Jane	Notes			Lucas	28 July 71	Fair	75°
Michalake	π			S. R. U.S. 20-A			
Schroder	H.S.						
Farr	PH			SEC. ALBON RDI - East			

DESCRIPTION	LEFT	CENTER LINE	RIGHT	JOB NO.
-------------	------	-------------	-------	---------

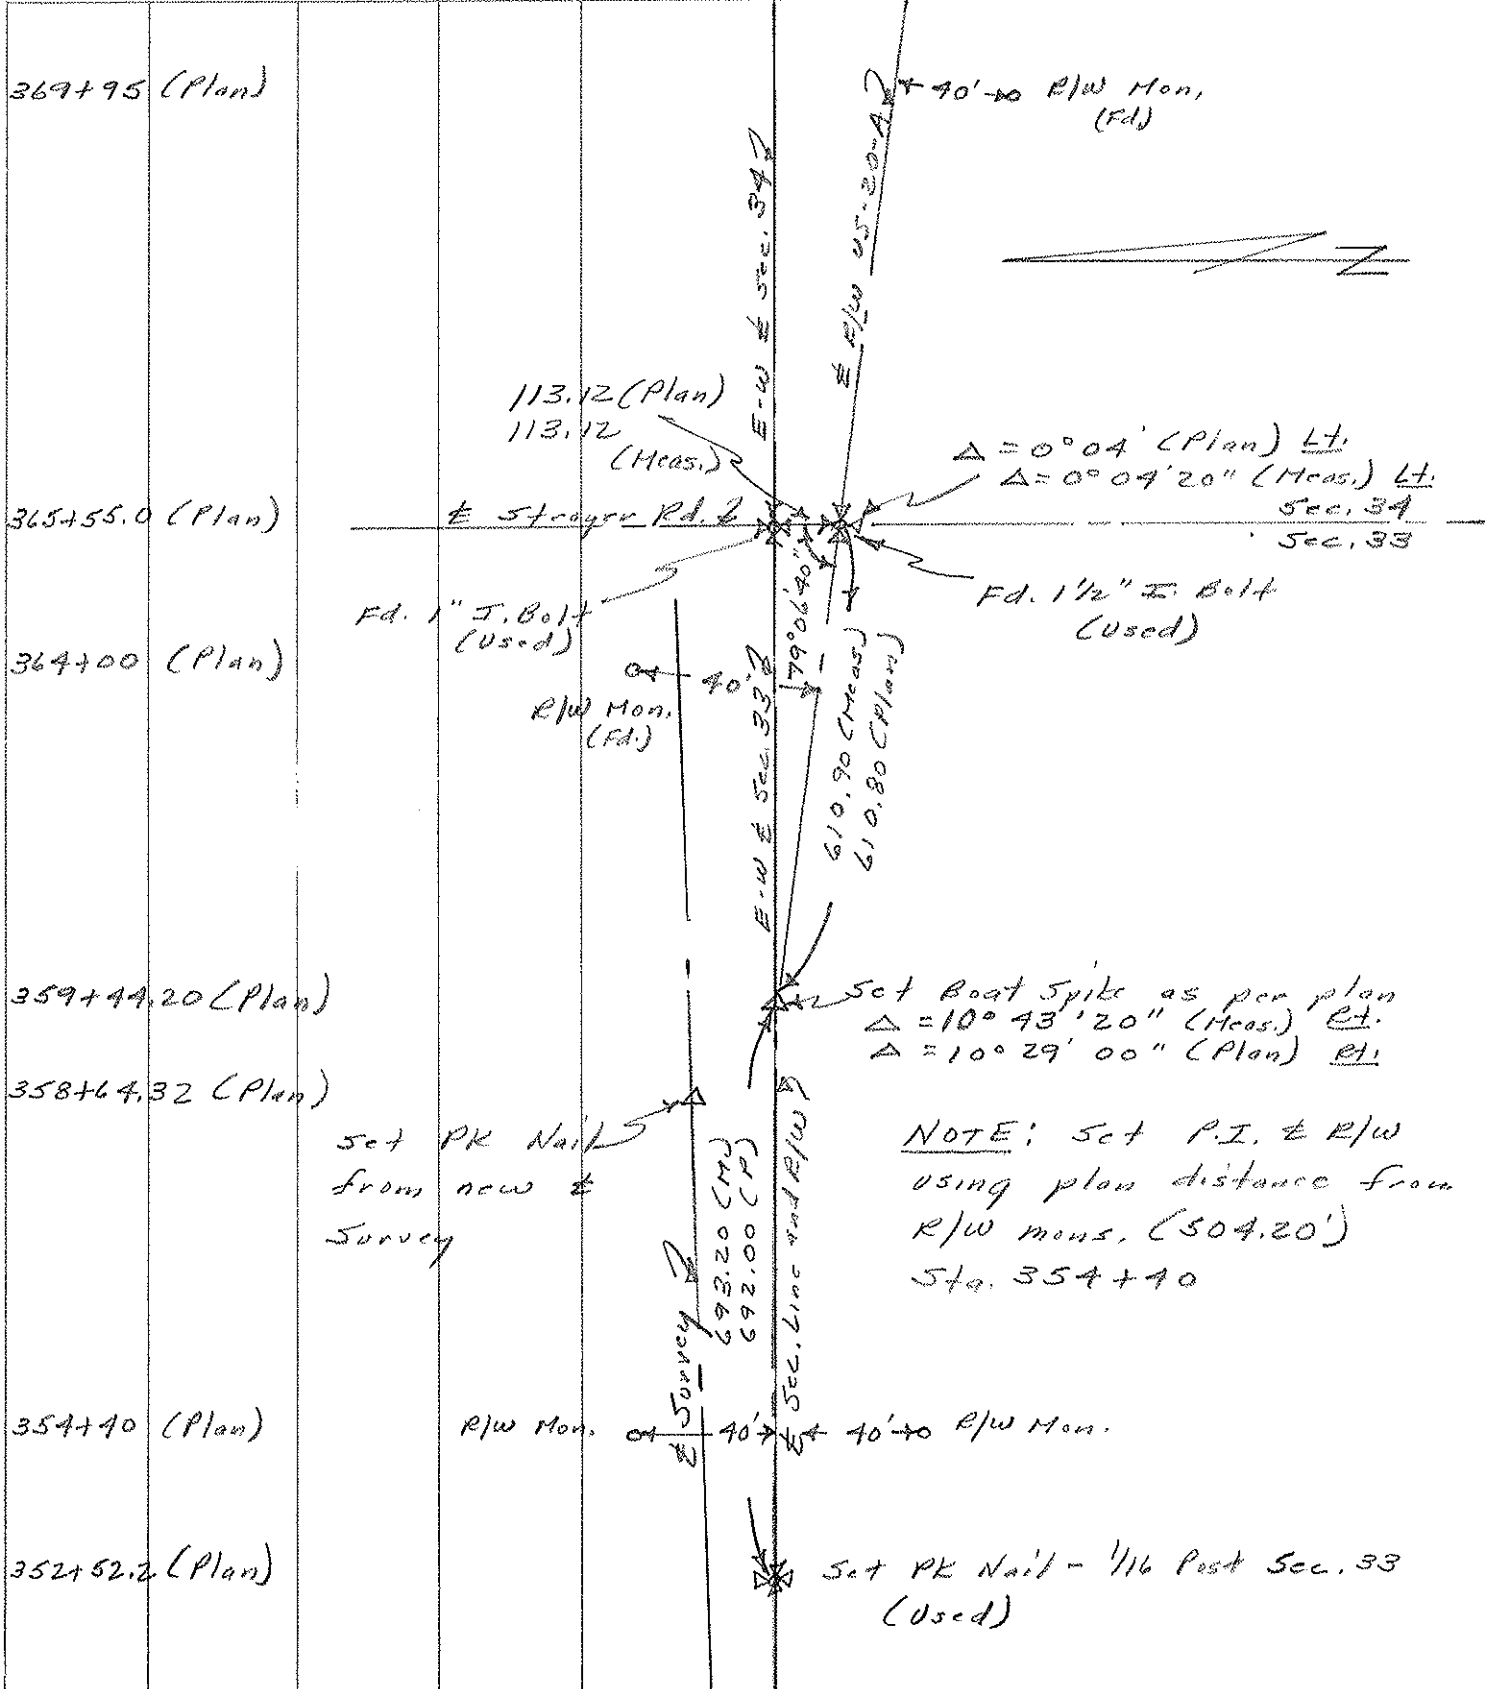

PERSONNEL	TITLE	PERSONNEL	TITLE
Stone	Notes		
Michalak	T		
Schroeder	H.C.		
Farr	RA		

COUNTY Lucas DATE 28 July 71

S. R. US-20-A WEATHER Fair

SEC. STRAYER RD. - EAST TEMP. 75°

DESCRIPTION _____ LEFT _____ CENTER LINE _____ RIGHT _____ JOB NO. _____

