



O.D.O.T. DISTRICT 2 SURVEY OFFICE (USE ONLY)

PERSONNEL _____ REFERENCE NO. 34 SHEET 45 OF 48
 NOTES WESTFALL DATE 8/7/13 ROUTE US 20A
 H.C. ROUSOS WEATHER FAIR COUNTY LUCAS
 R.C. WESTFALL TEMP. 73° TOWNSHIP MONCLOVA
 _____ KEFFER _____ SECTION 34
 _____ T 2

TYPE MONUMENT RR SPIKE
~~ON SURFACE~~ - BELOW 1 1/2"
 LEFT - ☉ PAV'T - RIGHT - _____
 _____ TO _____ EDGE PAVEMENT
 S.L.M. 546+91.95

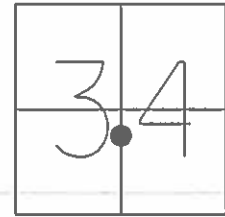

GRID: NORTHING: 696411.731 EASTING: 1641825.509

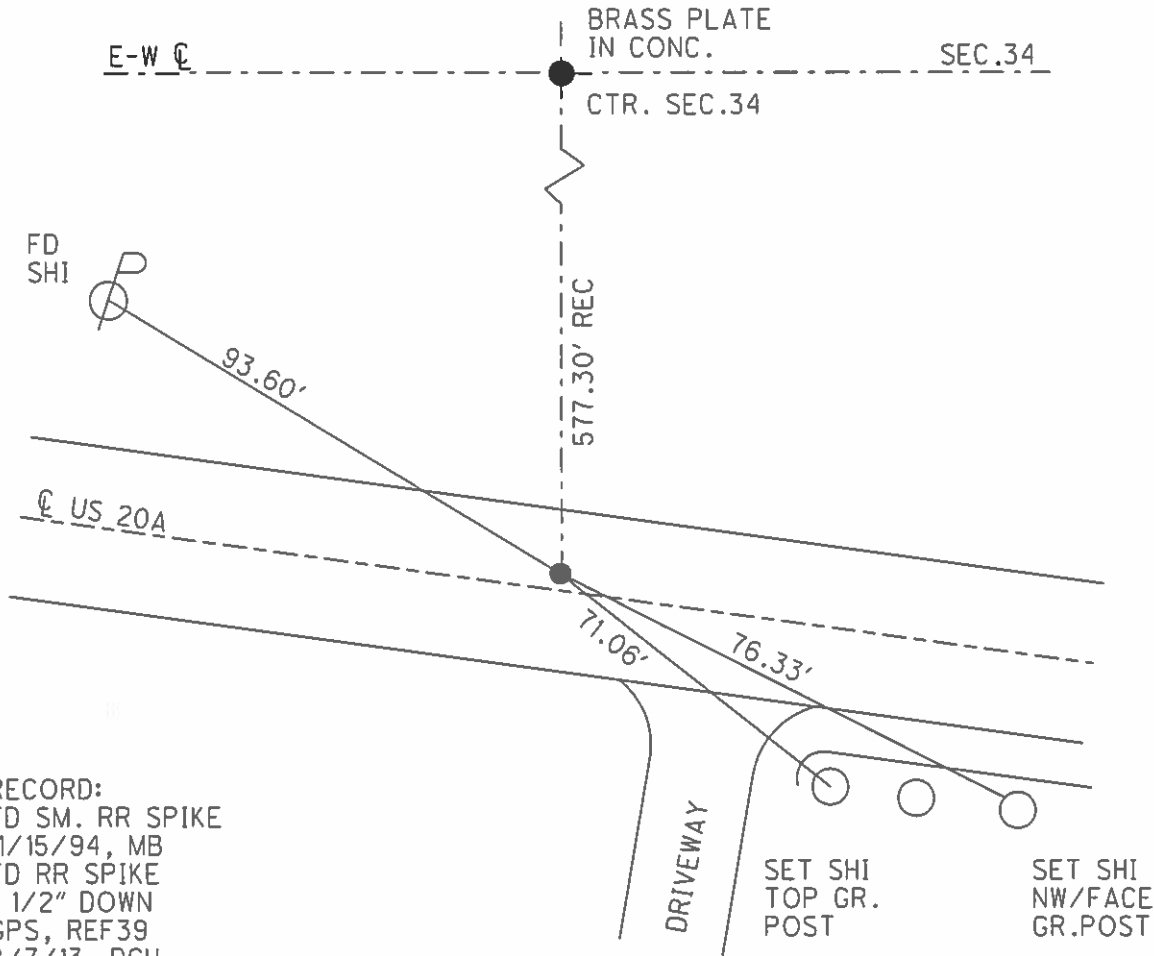



RECORD:
 FD SM. RR SPIKE
 11/15/94, MB
 FD RR SPIKE
 1 1/2" DOWN
 GPS, REF39
 8/7/13, DCH
 SET MAG/WASHER
 GPS, NEWREF39
 4/17/14, DCH

O.D.O.T. DISTRICT 2 SURVEY OFFICE (USE ONLY)

PERSONNEL _____ REFERENCE NO. 34 SHEET 39 OF 42
 NOTES WESTFALL DATE 8/7/13 ROUTE US 20A
 H.C. ROUSOS WEATHER FAIR COUNTY LUCAS
 R.C. WESTFALL TEMP. 73° TOWNSHIP MONCLOVA
 _____ SECTION 34
 _____ T 2

TYPE MONUMENT R.R.SPIKE
~~ON SURFACE~~ - BELOW 1 1/2"
 LEFT - ☉ PAV'T - RIGHT -
- TO - EDGE PAVEMENT
 S.L.M. 546+91.95

Grid: Northing: 696411.731 Easting: 1641825.509

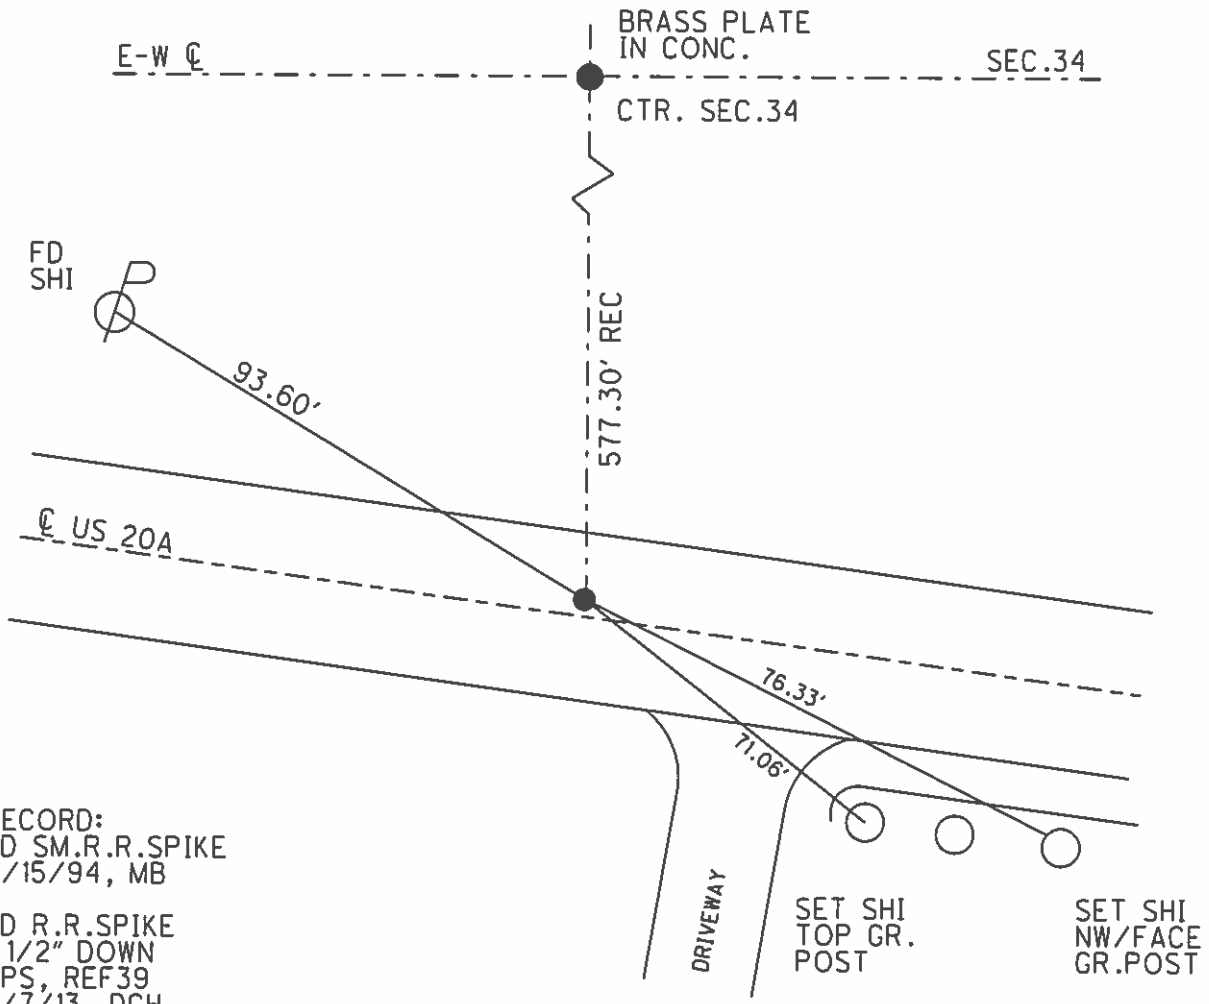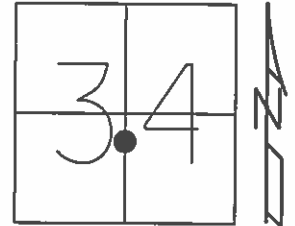

RECORD:
 FD SM.R.R.SPIKE
 11/15/94, MB
 FD R.R.SPIKE
 1 1/2" DOWN
 GPS, REF39
 8/7/13, DCH
 SET MAG/WASHER
 GPS, NEWREF39
 4/17/14, DCH

PERSONNEL	TITLE	PERSONNEL	TITLE
Stone	Notes		
Michalak	T		
Schroeder	H.C.		
Farr	RA		

COUNTY Lucas DATE 28 July 71

S. R. US-20-A WEATHER Fair

SEC. STRAYER RD. - EAST TEMP. 75°

DESCRIPTION _____ LEFT _____ CENTER LINE _____ RIGHT _____ JOB NO. _____

