
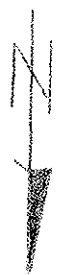


PERSONNEL	TITLE	PERSONNEL	TITLE
BLAS	NOTES		
Dewitt			
Bundros			
Ambrose			

COUNTY LUCAS DATE 6/5/62
 S. R. _____ WEATHER CLEAR
 SEC. _____ TEMP. 75°

DESCRIPTION TIES TO MON - SECOR RD

JOB NO. _____

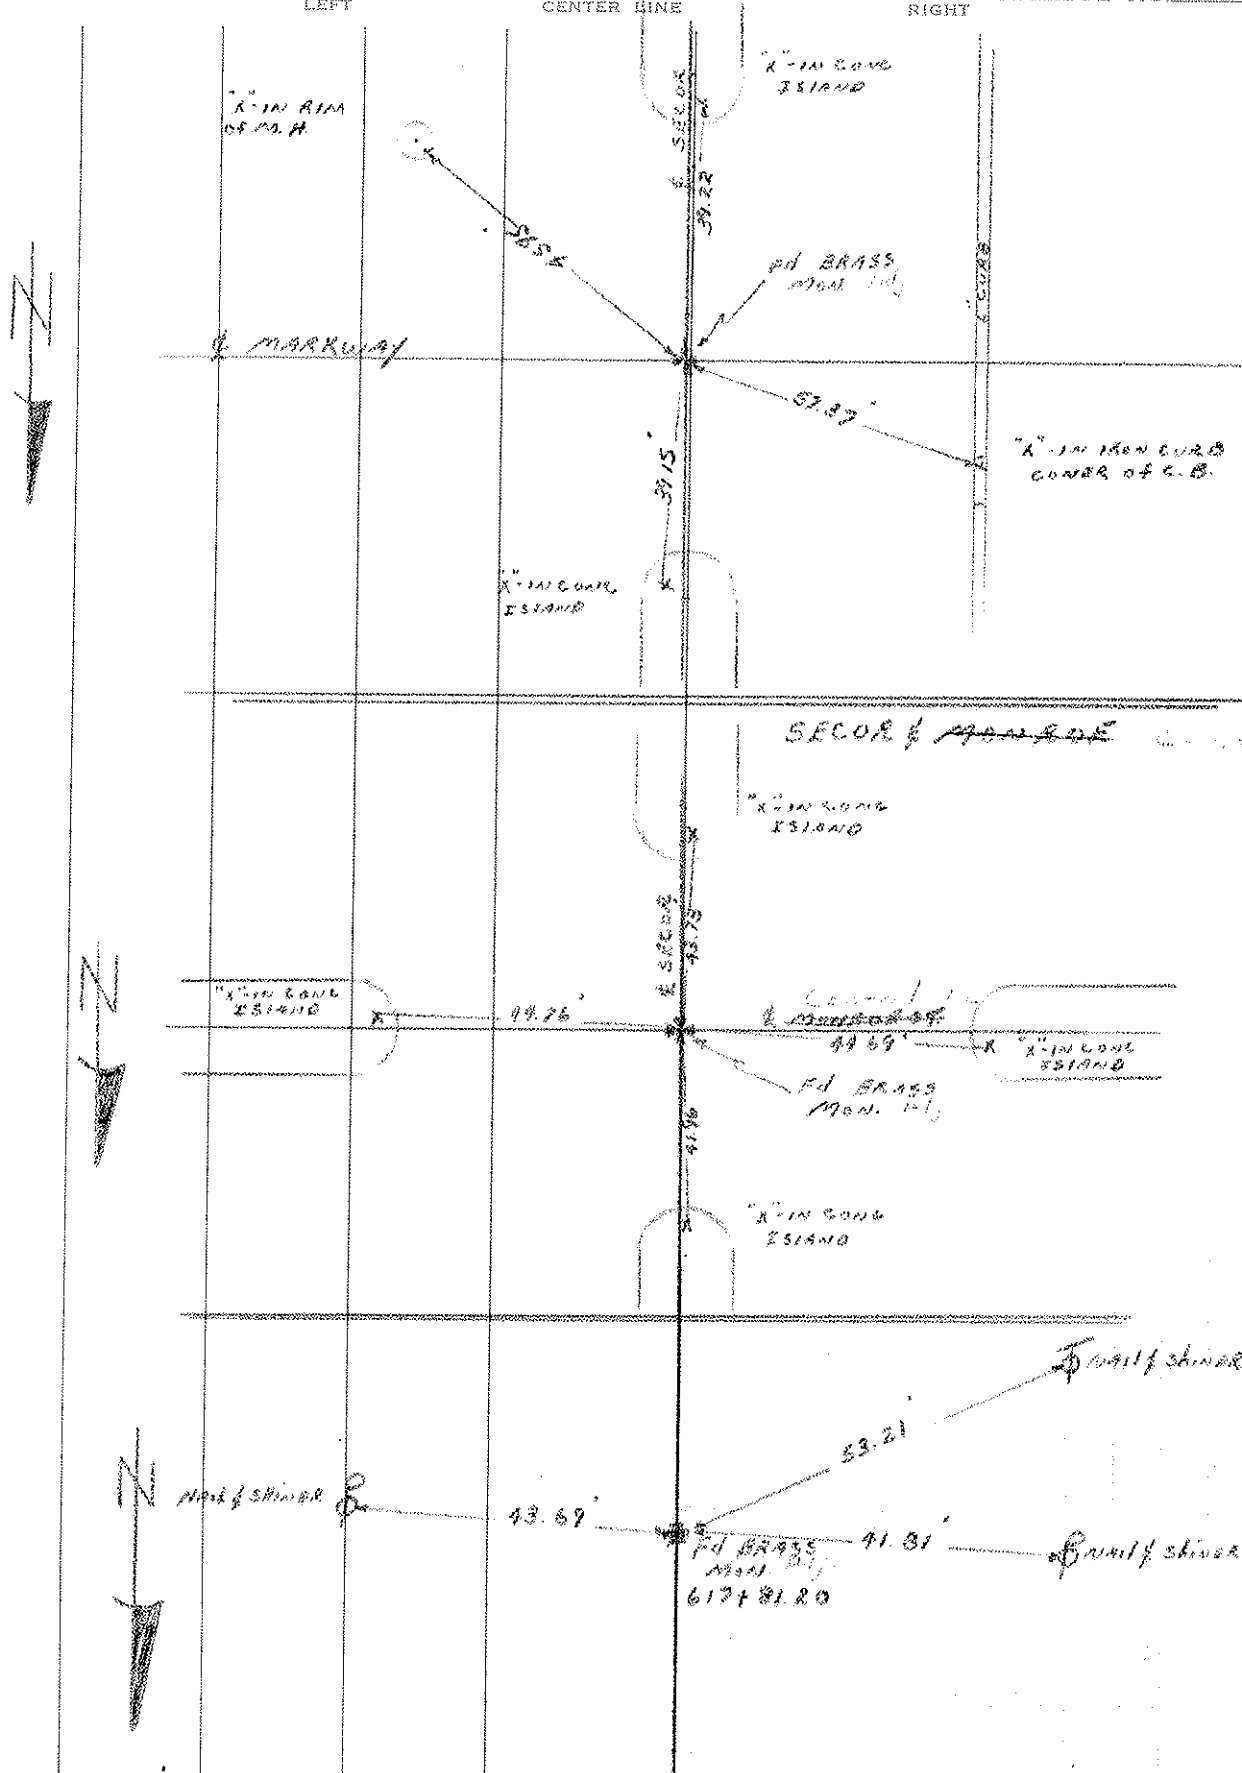

Monif Shiner

Monif Shiner

Monif Shiner

617481.20