

PERSONNEL TITLE PERSONNEL TITLE

COUNTY Lucas DATE May 4, 1966

Danna \_\_\_\_\_

S. R. 282 WEATHER Sunny

Curtis \_\_\_\_\_

Gracia \_\_\_\_\_

SEC. \_\_\_\_\_ TEMP. 50'


Obey \_\_\_\_\_

DESCRIPTION Monroe St Monument Reference JOB NO. \_\_\_\_\_


LEFT

CENTER LINE

RIGHT

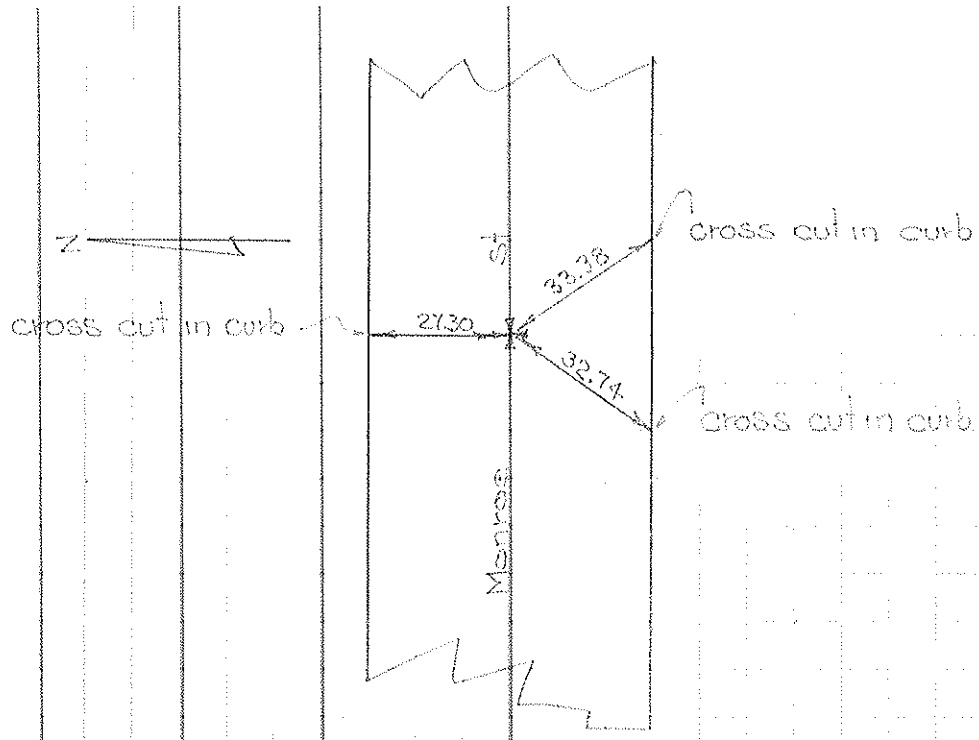

Mon. No 21 1/4 mile East of Holland-Sylvania Rd.  
in box flush with pavement

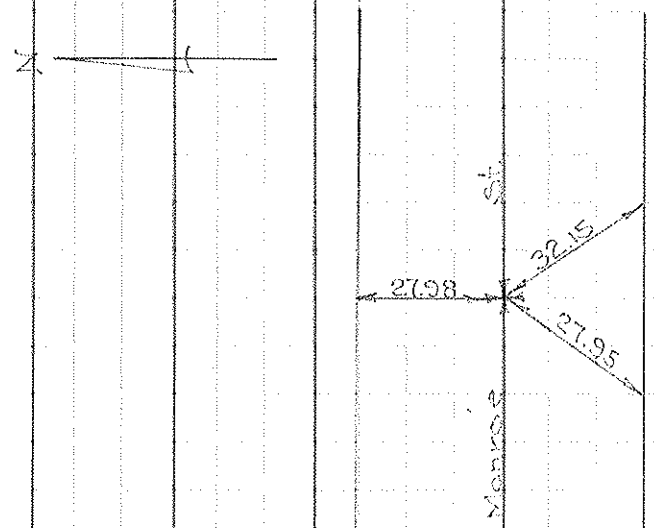

Mon. No 22 in box flush with pavement  
1/2 mile East of Holland-Sylvania Rd