


COMPUTATION SHEET

STATE OF OHIO — DEPARTMENT OF HIGHWAYS — BUREAU OF LOCATION AND DESIGN ————— COLUMBUS, OHIO
 BY Dennis Curtis-Grandjean-Oney DATE June 2, 1966 NO. OF SHEETS
 COUNTY Lucas SECTION
 I. NO. S. R. US 223 U. S. R. I. R.
 SUBJECT OF THIS SHEET Monument Ref. Monroe St

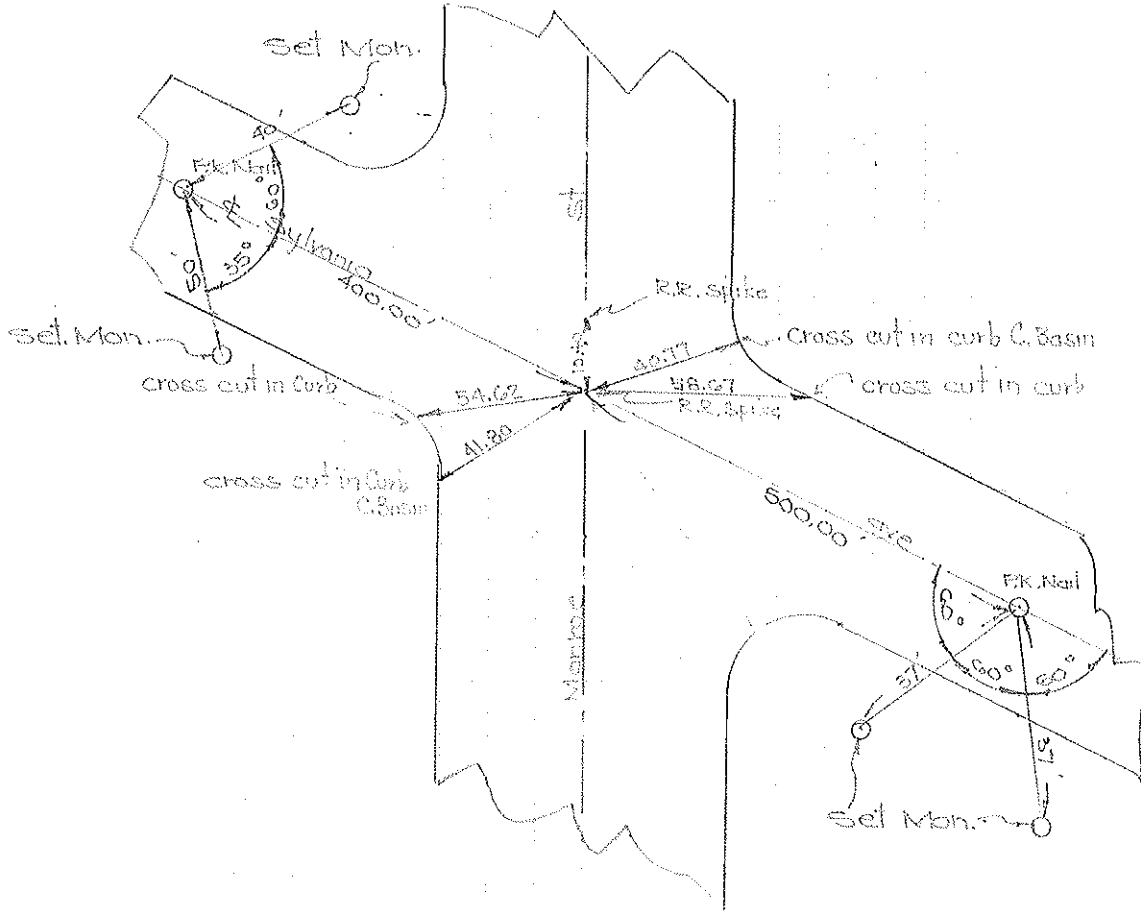

$11^{\circ} 38'$ R.R. spike Monroe & Sylvania Sta 221+49.92

