

County Lucas S.R. 223

Date 10 MAY 1979

Township Sylvania


Weather Warm

Section 0.00


Temp. 77°

T N, R E

Personnel L. Stone
R. Michelak
P. Neuser
D. Curtis
D. Grunat

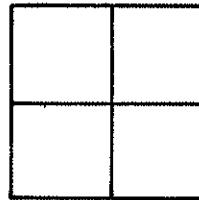

REF. No. 1

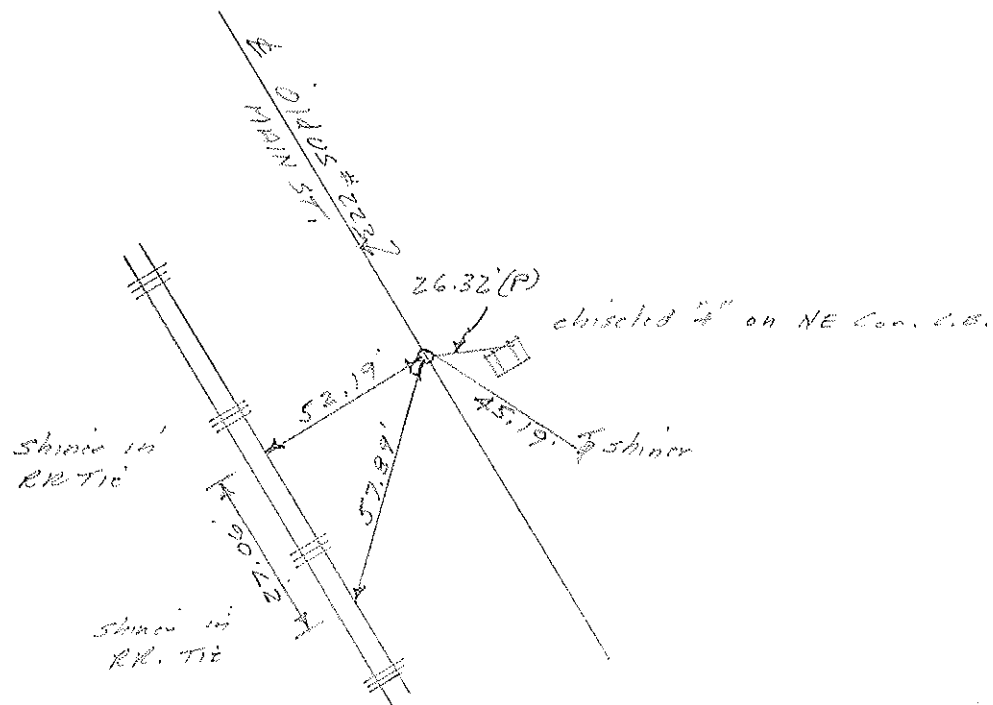

Ed. 1/2" I, Red 1. Surface
 12.5' to E. edge put.
 10.7' to W. edge put.