

County Lucas S.R. 223

Date 10 May 1979

Township Sylvania


Weather Windy

Section 0.00


Temp. 74°

T N, R E

Personnel A. Stone
B. Michalak
C. Neuser
D. Curtis
D. Grando

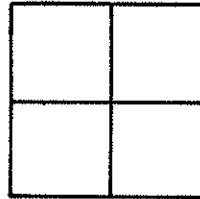

REF. NO. 2

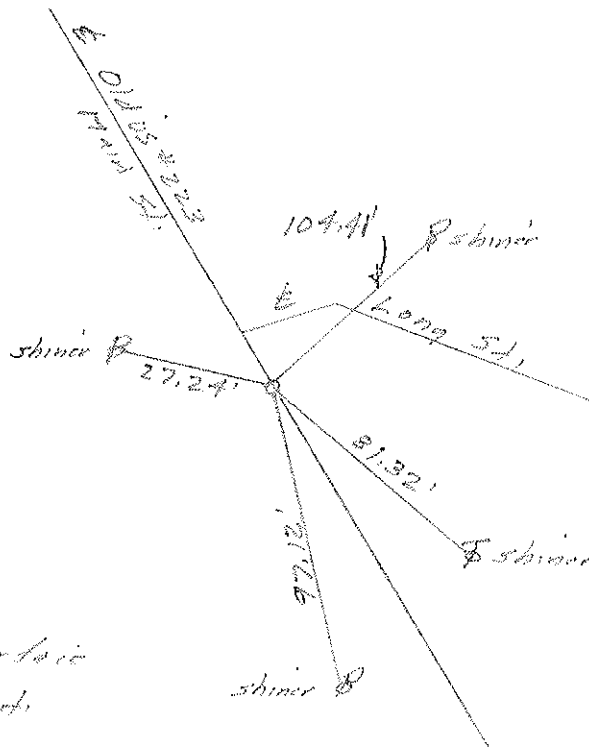

Fd. PK No. 1 to Surtovic
 11.5' to W. edge post