

County Lucas S.R. 05 #223

Date 10 May 79

Township Sylvania


Weather Warm

Section 0.00


Temp. 75°

T_N, R_E

Personnel L. Schuman
R. Michalak
P. Nausen
D. Curtis
D. Grunsky

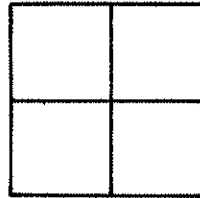

REF. NO. 5

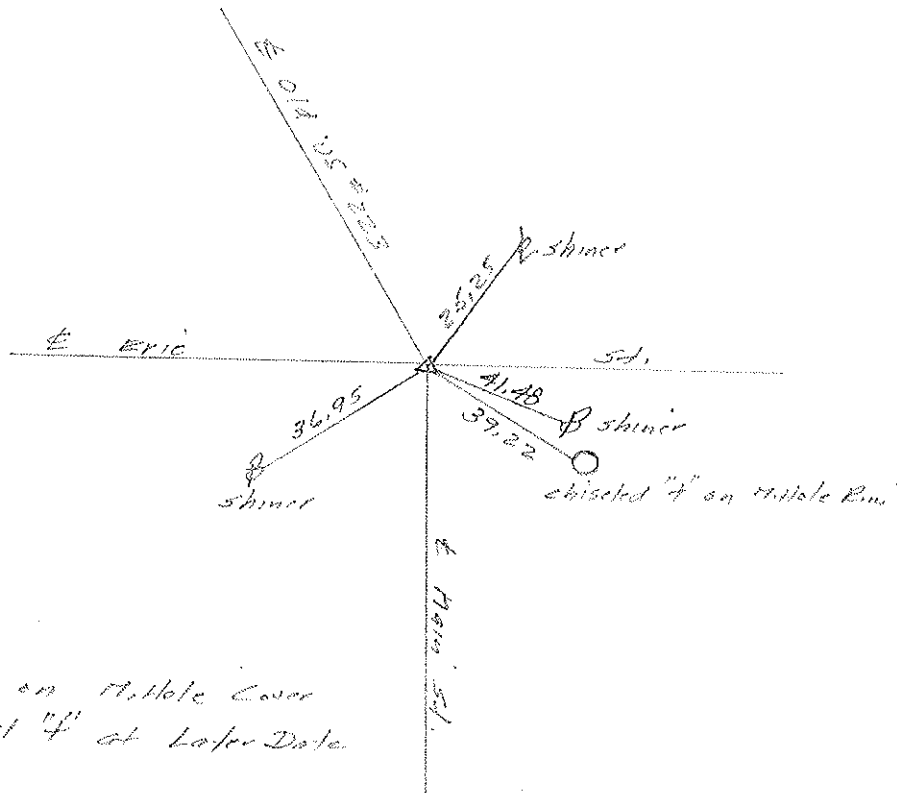

P.I. Falls on Mitole Cover
 will chisel 4 at Later Date