

County Lucas S.R. 05<sup>th</sup> 222

Date 10 May 1979

Township Sylvania


Weather Windy

Section 1.00


Temp. 79°

T.N, R.E

Personnel L. Stone  
R. Michalek  
P. Newcom  
D. Curtis  
D. Grunets

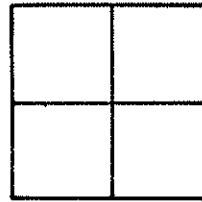

REF. No. 8

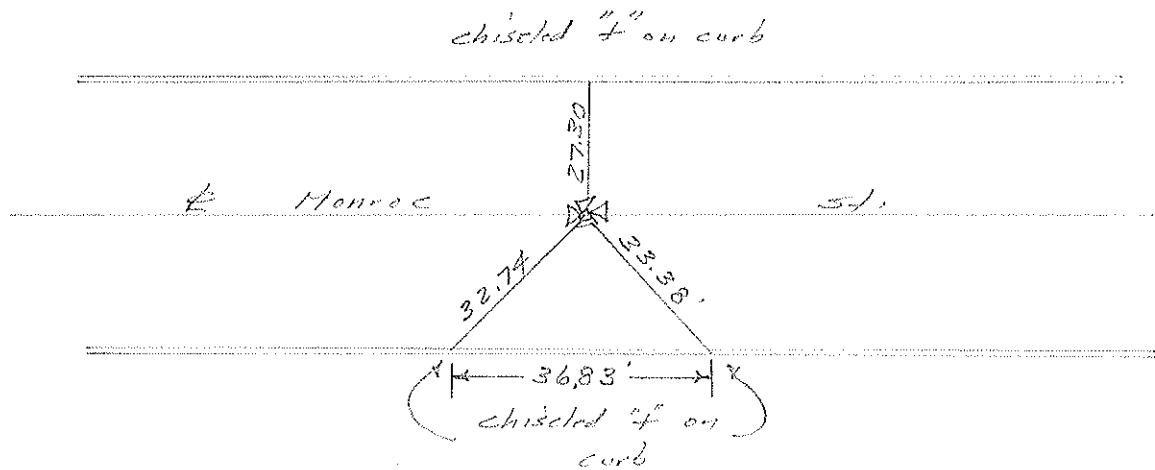

Ed. Mon. Box - No Lid  
 AT East edge Res.  
 # 6367 Monroe St.