

County Lucas S.R. 05<sup>th</sup> 223

Date 10 May 1979

Township Sylvania


Weather Warm

Section 1.00


Temp. 79°

T\_N, R\_E

Personnel L. Stone  
E. Michalak  
P. Nooser  
D. Curtis  
D. Grawley

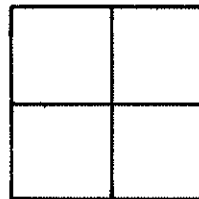

REF. NO. 10

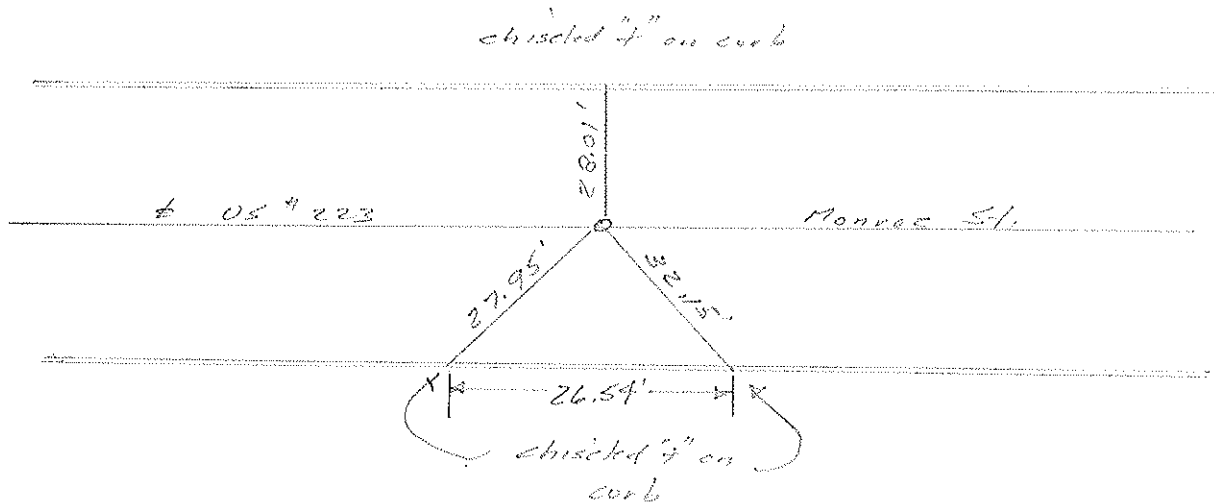

Fd. Mon. Box

PERSONNEL	TITLE	PERSONNEL	TITLE	COUNTY	DATE
<u>W. DENNO</u>				<u>LUCAS</u>	<u>25 AUGUST 71</u>
<u>D. CURTIS</u>				<u>U.S. 223</u>	<u>WEATHER CLOUDY</u>
<u>D. STEVENS</u>					<u>TEMP. 60±</u>

DESCRIPTION REFERENCES TO CONTROL POINTS JOB NO. \_\_\_\_\_

