

PERSONNEL	TITLE	PERSONNEL	TITLE
W. DENNO			
D. CURTIS			
D. STEVENS			
R. BRANNAN			


COUNTY LUCAS DATE 7 SEPT. 71

S. R. U.S. 223 WEATHER FAIR

SEC. TOLEDO TEMP. 75 ±

DESCRIPTION \_\_\_\_\_ REFERENCES TO CONTROL POINTS \_\_\_\_\_ JOB NO. \_\_\_\_\_

LEFT CENTER LINE RIGHT

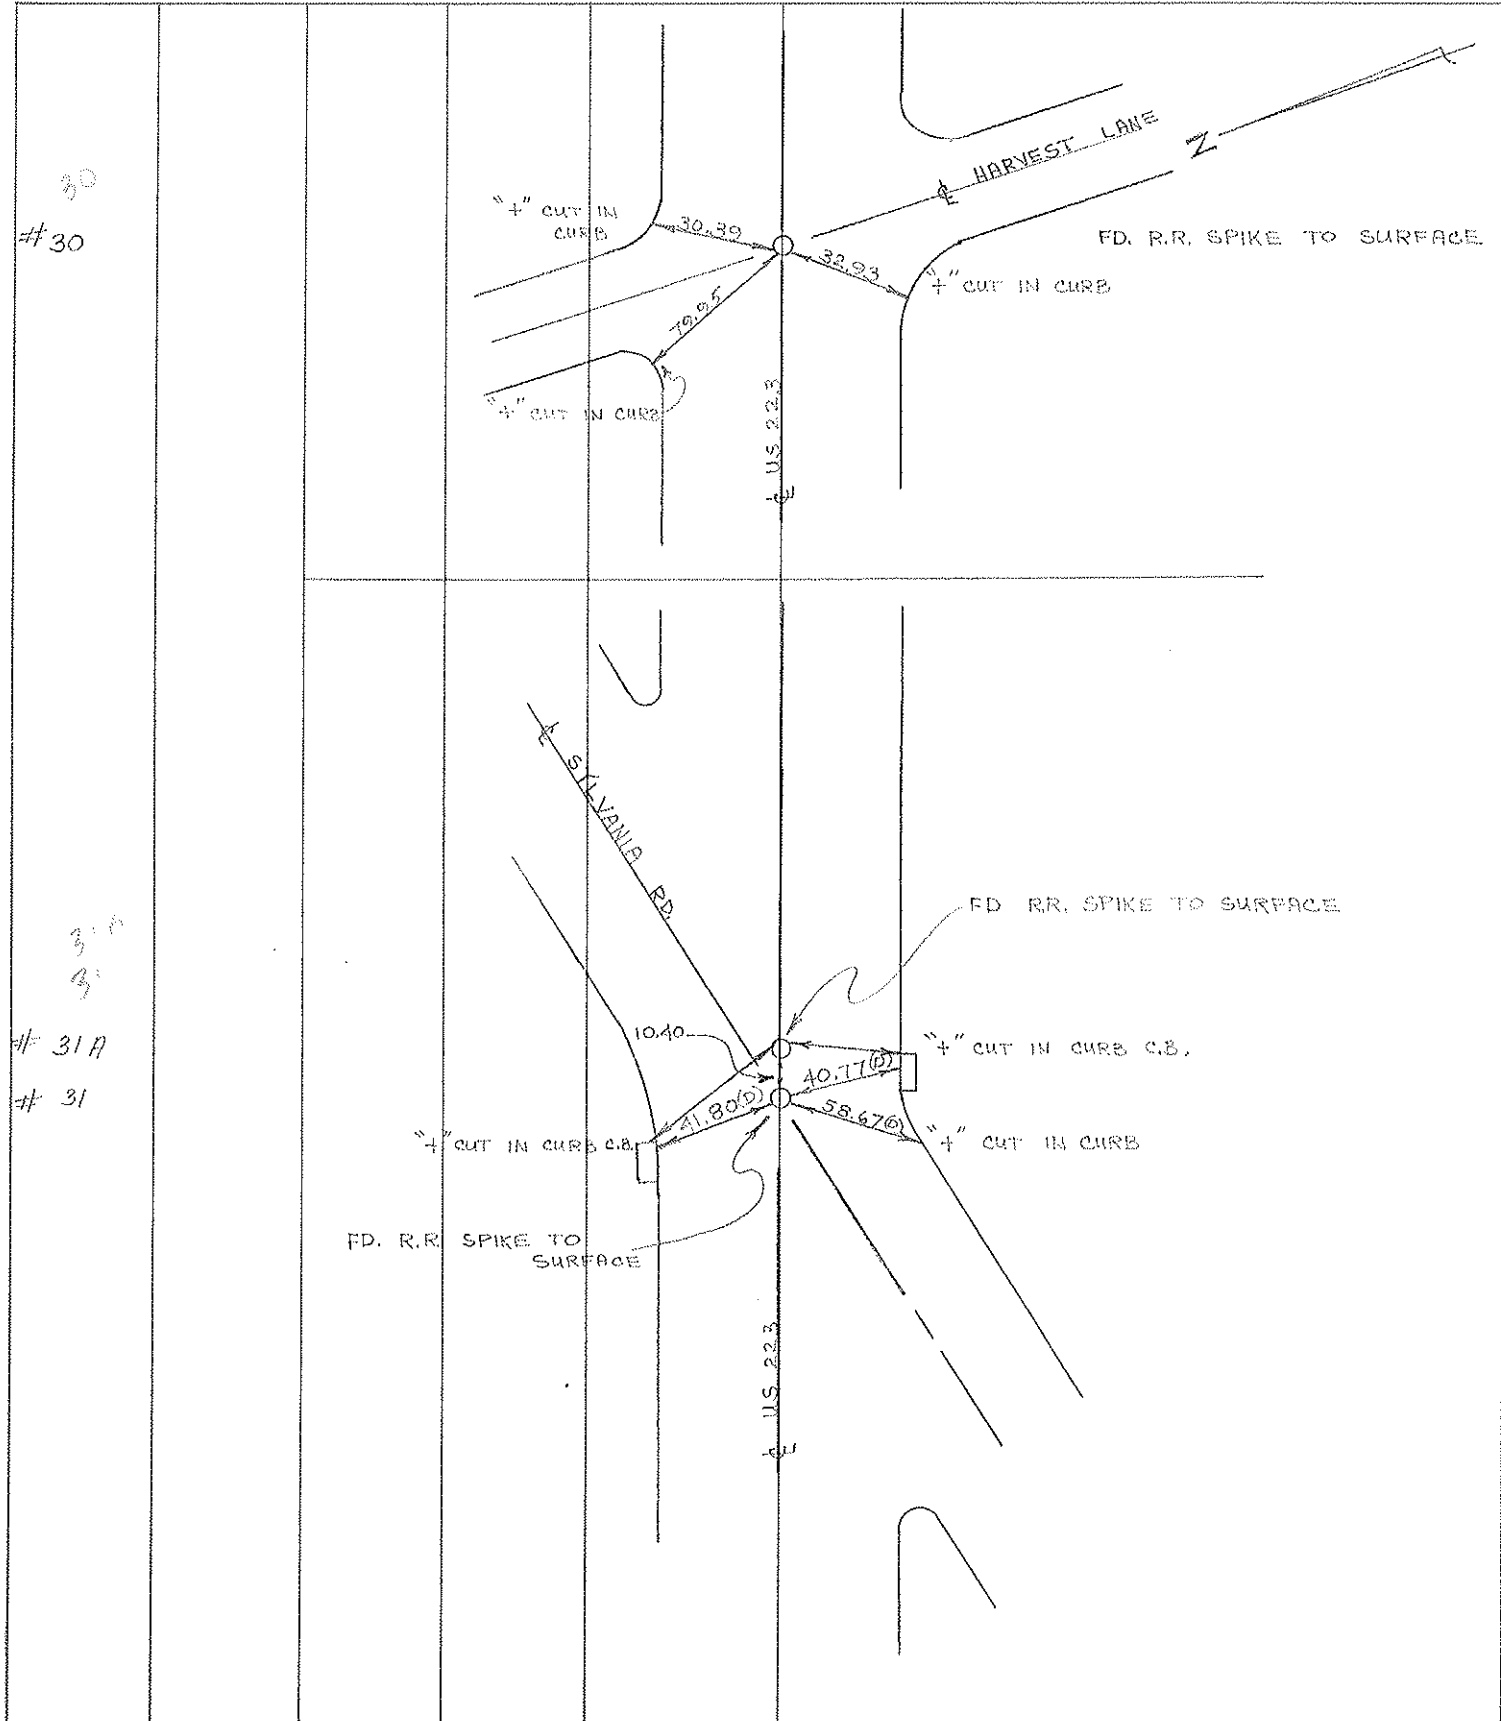

#30

#31A  
#31