


PERSONNEL	TITLE	PERSONNEL	TITLE
W. DENNO			
D. CURTIS			
D. STEVENS			

COUNTY LUCAS DATE 13 SEPT. 71
 S. R. U.S. 223 WEATHER FAIR
 SEC. TOLCOO TEMP. 60°

DESCRIPTION REFERENCES TO CONTROL POINTS JOB NO. _____
 LEFT CENTER LINE RIGHT

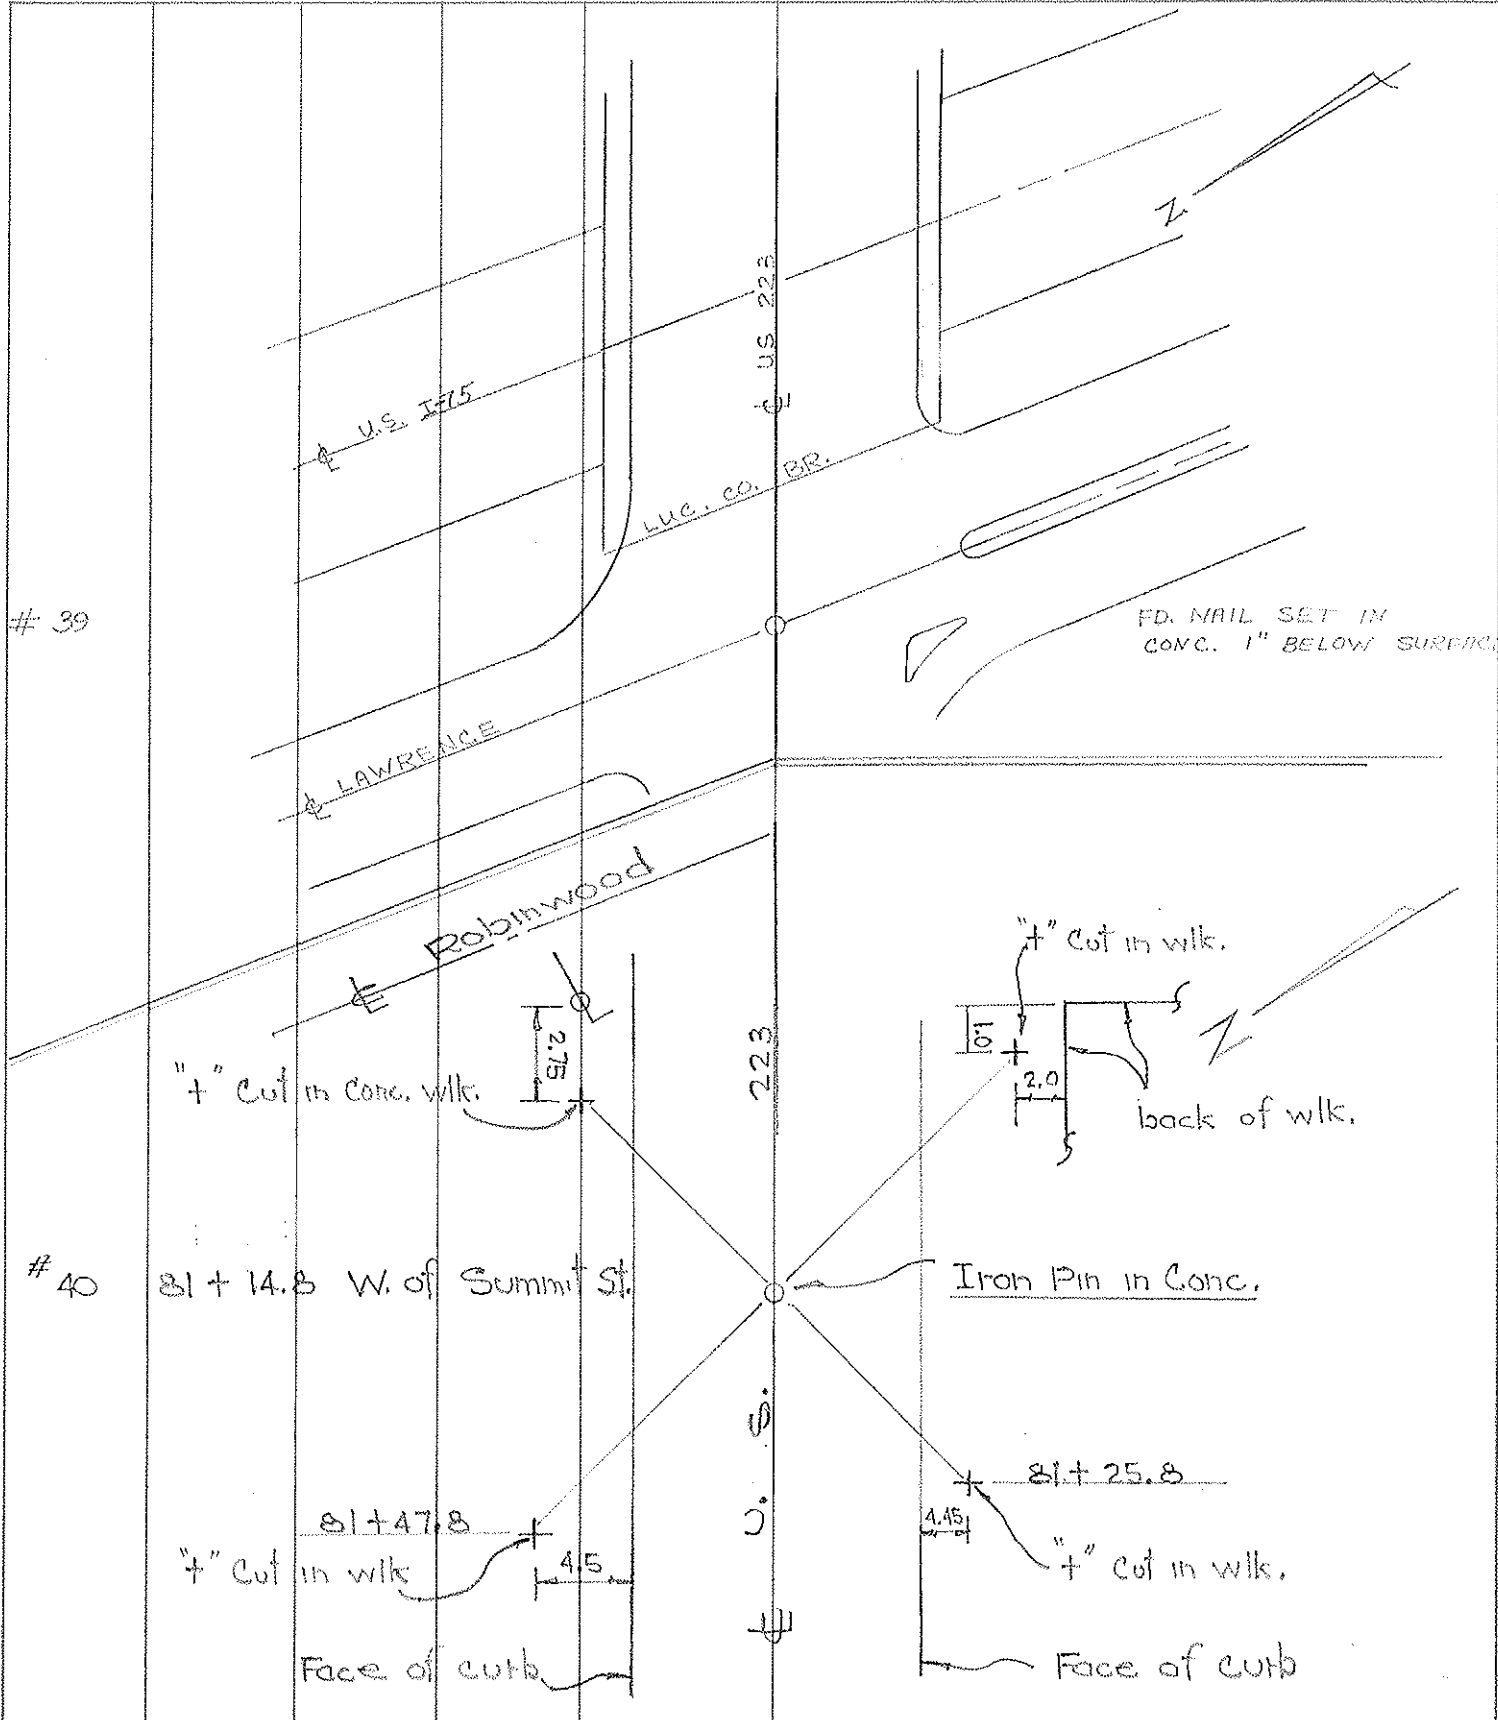

39

40

81 + 14.8 W. of Summit St.

81 + 47.8

Iron Pin in Conc.

81 + 25.8

Face of curb

Face of curb