


PERSONNEL TITLE PERSONNEL TITLE
 W. Denno _____
 D. Curtis _____
 D. Stevens _____

COUNTY Lucas DATE Sept. 14, 1971
 S. R. 223 WEATHER Sunny-mild
 SEC. TOLEDO TEMP. 75°f

DESCRIPTION References To Control Points JOB NO. 02994(0)

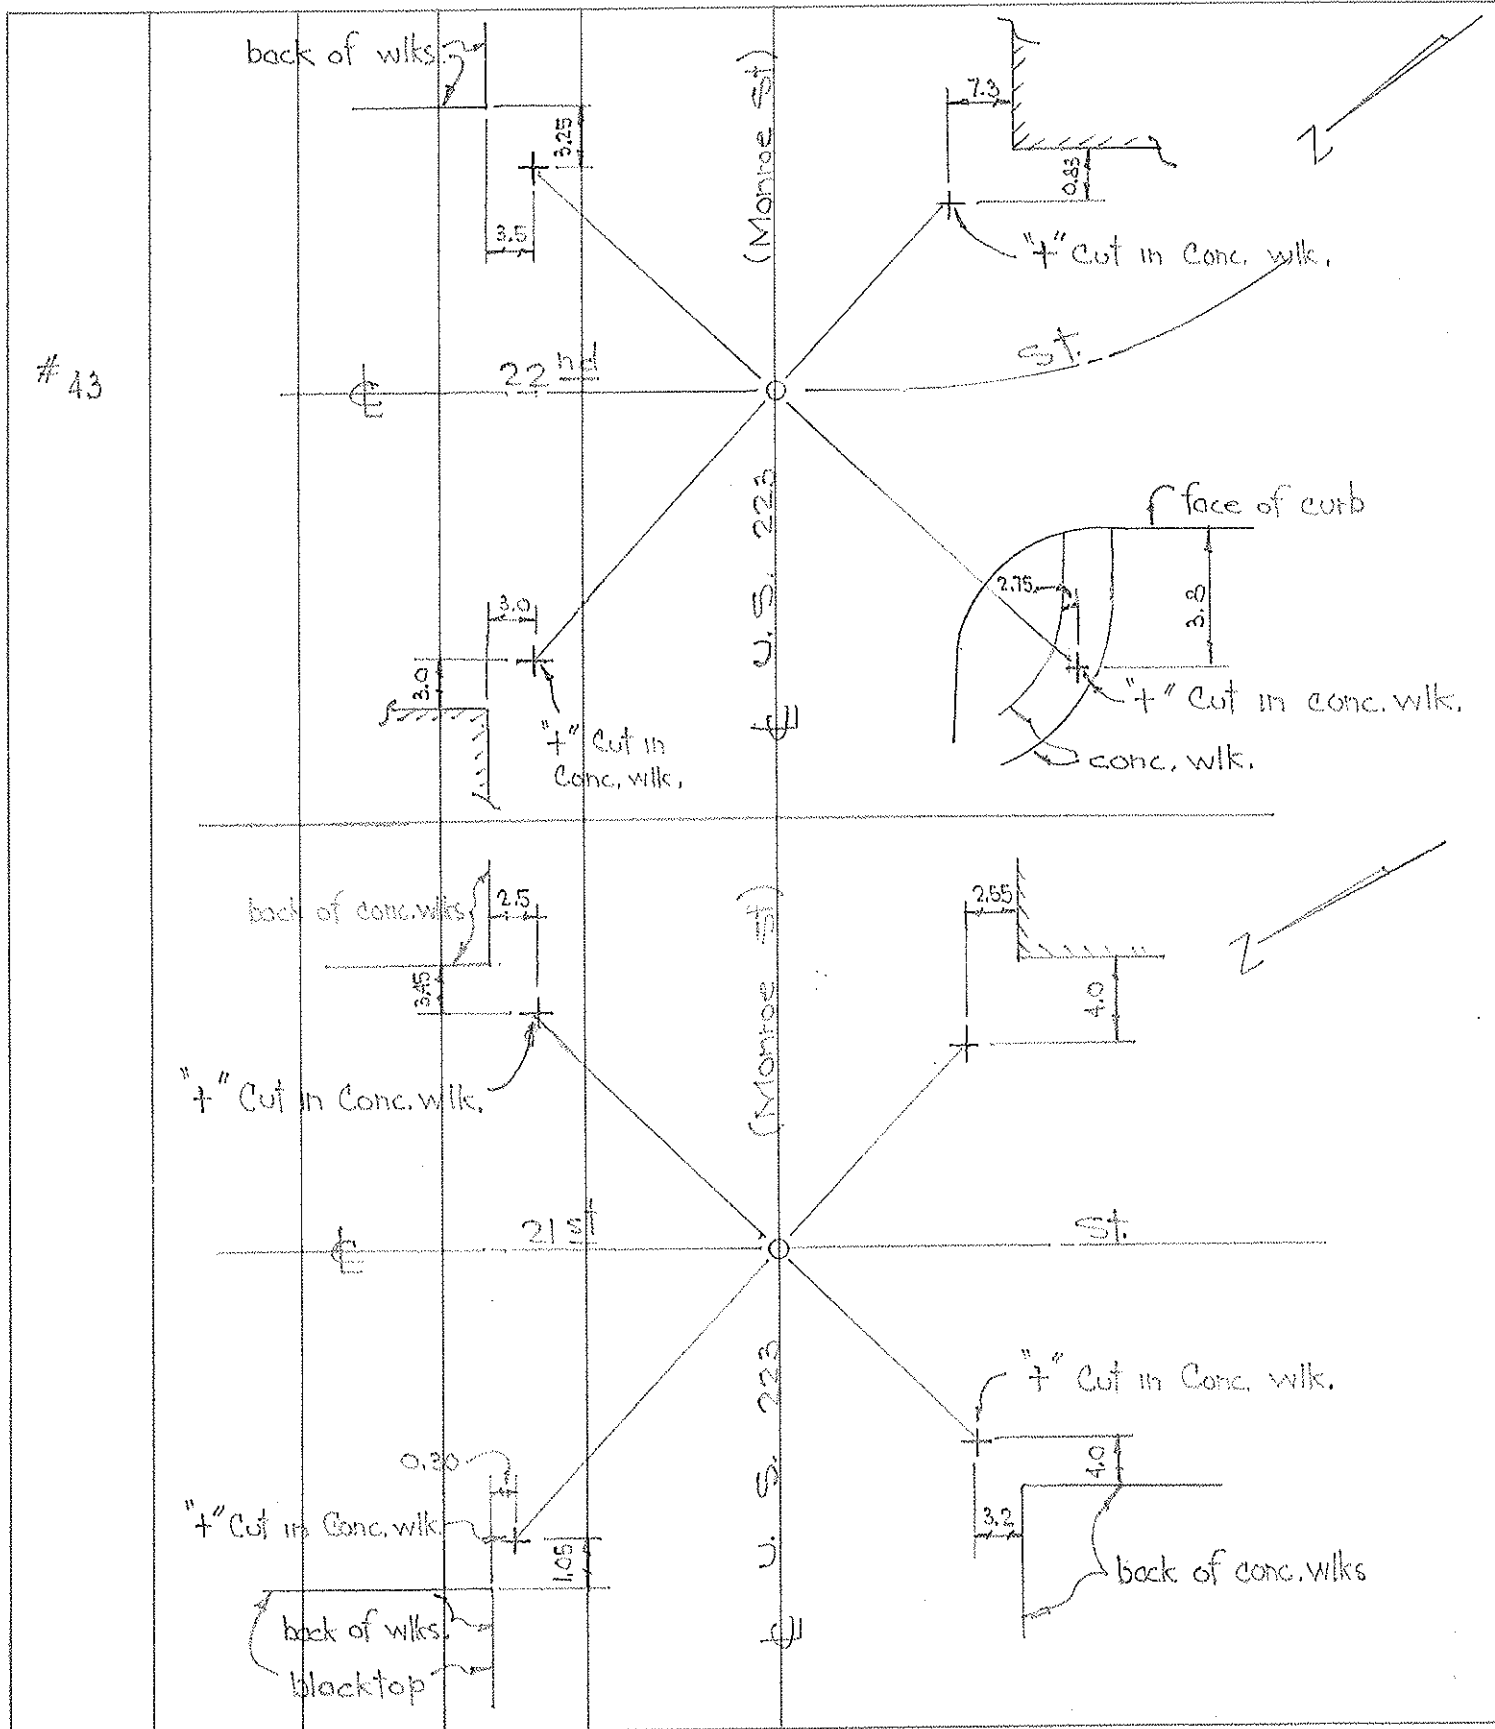

43