



O.D.O.T. DISTRICT 2 SURVEY OFFICE (USE ONLY)

PERSONNEL _____ REFERENCE NO. A SHEET 1 OF 32
 NOTES LUCAS CO. DATE 11/8/07 ROUTE CR 47
 H.C. CORNELL WEATHER _____ COUNTY LUCAS
 R.C. _____ TEMP. _____ TOWNSHIP SPENCER
 DWG BY RHOADES PID _____ SECTION 34
 T 9 S R 5 E

TYPE MONUMENT MONBOX W/CMON
 ON SURFACE - ~~BELOW~~ ON _____
 OFFSET \varnothing PAVEMENT _____ LT : RT _____
 TO _____ EDGE PAVEMENT _____
 STATION: _____
 HORZ. DATUM: _____ GEOID: _____
 GRID: NORTHING: 723013.958 EASTING: 1608265.422

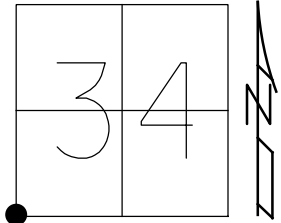

RECORD:
 FD MONBOX
 W/ CMON
 1' DOWN
 8/28/07
 11/8/07, CORNELL

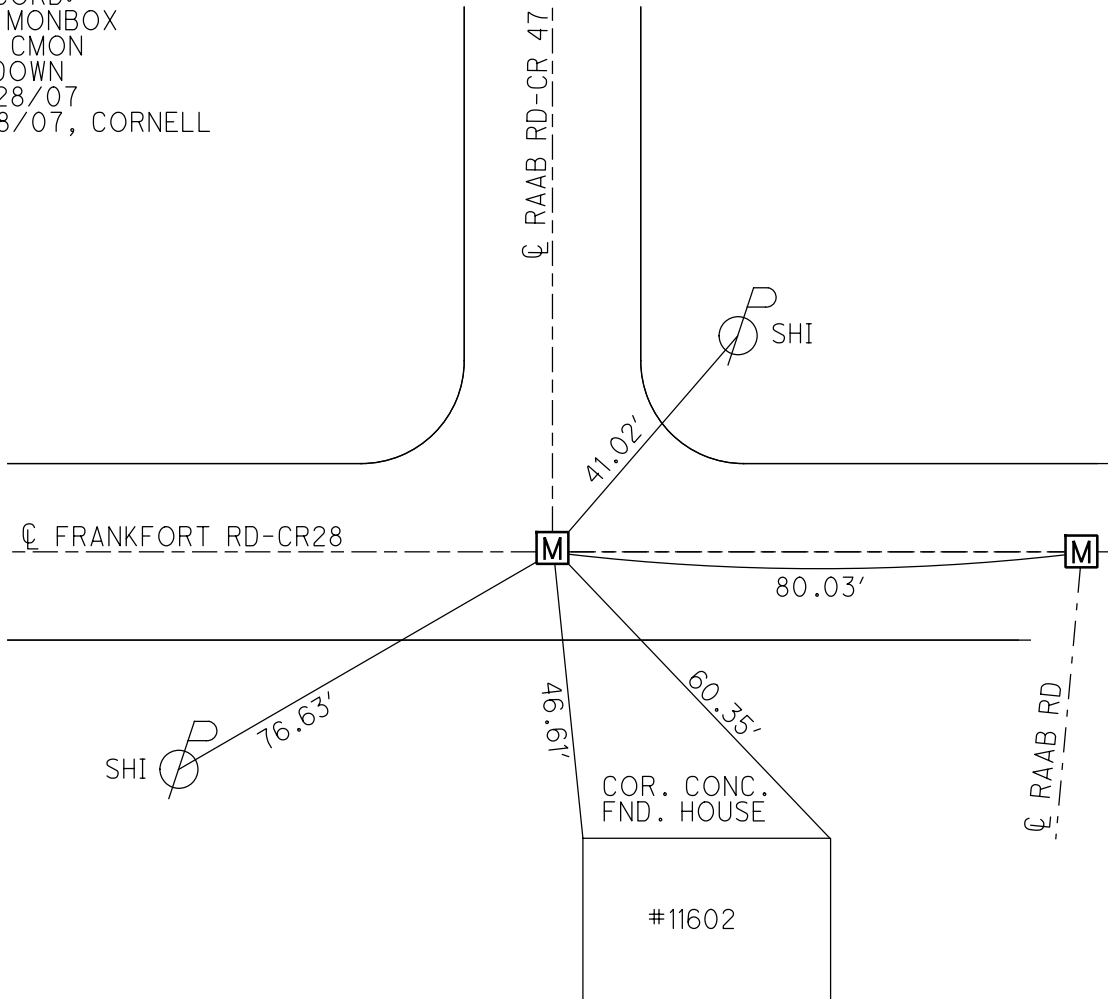

O.D.O.T. DISTRICT 2 SURVEY OFFICE (USE ONLY)

PERSONNEL _____

REFERENCE NO. B

SHEET 2 OF 32

NOTES LUCAS CO.

DATE 11/5/07

ROUTE CR 47

H.C. KAUFMAN

WEATHER _____

COUNTY LUCAS

R.C. _____

TEMP. _____

TOWNSHIP SPENCER

SECTION 34

DWG BY RHOADES

PID _____

T 9 S R 5 E

TYPE MONUMENT IRON BOLT ATOP STONE

~~ON SURFACE~~ - BELOW 0.2'

OFFSET \varnothing PAVEMENT _____ LT : RT

_____ TO _____ EDGE PAVEMENT


STATION: _____

HORZ.DATUM: _____


GEOID: _____

GRID: NORTHING: 724316.672

EASTING: 1608249.521

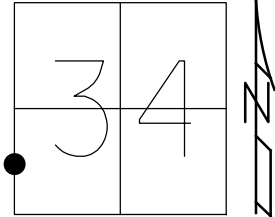

RECORD:
FD IRON BOLT
ATOP STONE
0.2' DOWN
11/12/07, KAUFMAN

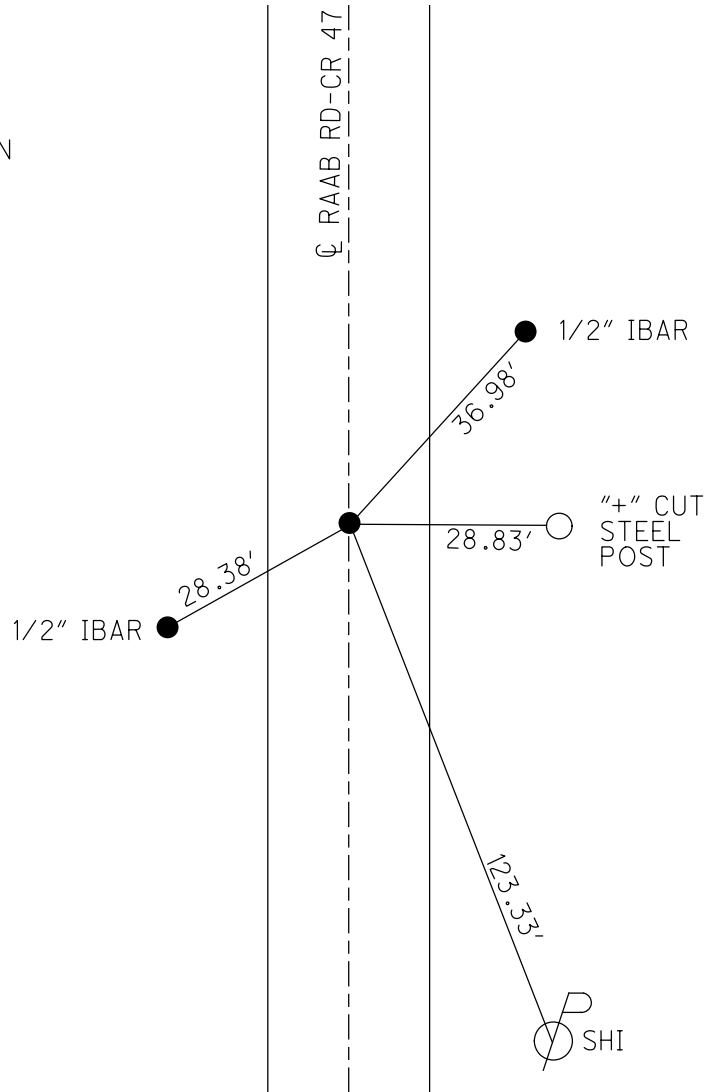

O.D.O.T. DISTRICT 2 SURVEY OFFICE (USE ONLY)

PERSONNEL _____ REFERENCE NO. C SHEET 3 OF 32

NOTES LUCAS CO. DATE 11/5/07 ROUTE CR 24

H.C. KAUFMAN WEATHER _____ COUNTY LUCAS

R.C. _____ TEMP. _____ TOWNSHIP SPENCER

DWG BY RHOADES PID _____ SECTION 34

T 9 S R 5 E

TYPE MONUMENT MONBOX W/ CMON

ON SURFACE - ~~BELOW~~ ON _____


OFFSET \odot PAVEMENT _____ LT : RT

_____ TO _____ EDGE PAVEMENT


STATION: _____

HORIZ.DATUM: _____ GEOID: _____

GRID: NORTHING: 725619.688 EASTING: 1608233.916

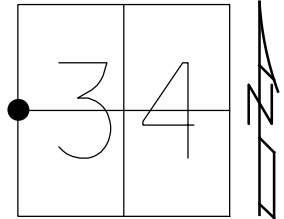

RECORD:
FD MONBOX
W/ CMON
11/13/07, KAUFMAN

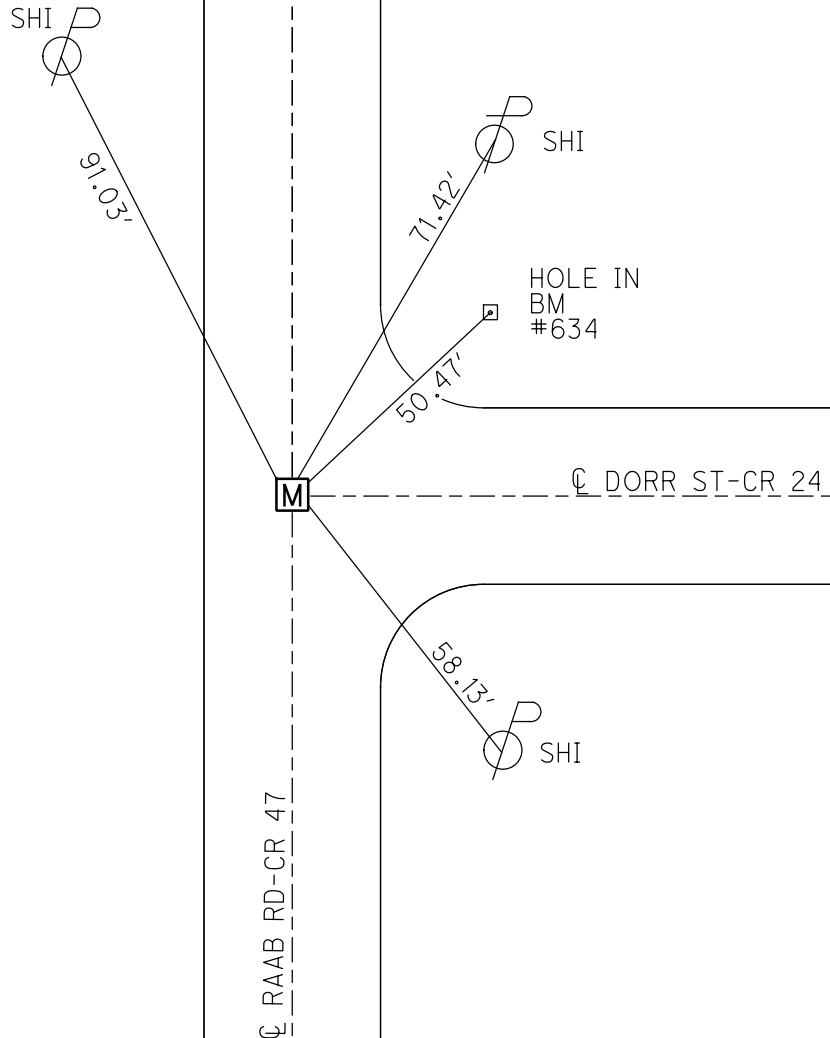

O.D.O.T. DISTRICT 2 SURVEY OFFICE (USE ONLY)

PERSONNEL _____ REFERENCE NO. D SHEET 4 OF 32

NOTES LUCAS CO. DATE 3/31/15 ROUTE CR 24

H.C. KAUFMAN WEATHER _____ COUNTY LUCAS

R.C. _____ TEMP. _____ TOWNSHIP SPENCER

DWG BY RHOADES PID _____ SECTION 34

T 9 S R 5 E

TYPE MONUMENT MONBOX W/ IPID

ON SURFACE - ~~BELOW~~ ON _____


OFFSET \varnothing PAVEMENT _____ LT : RT

_____ TO _____ EDGE PAVEMENT


STATION: _____

HORZ.DATUM: _____ GEOID: _____

GRID: NORTHING: 725559.540 EASTING: 1610856.723

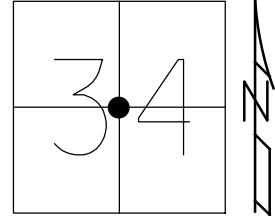


RECORD:
 FD IRON BOLT
 0.2' DOWN
 5/8" DIA, KAUFMAN
 FD MONBOX
 W/ IPID
 5/8" IPIN W/ALUM CAP
 3/31/15, KAUFMAN

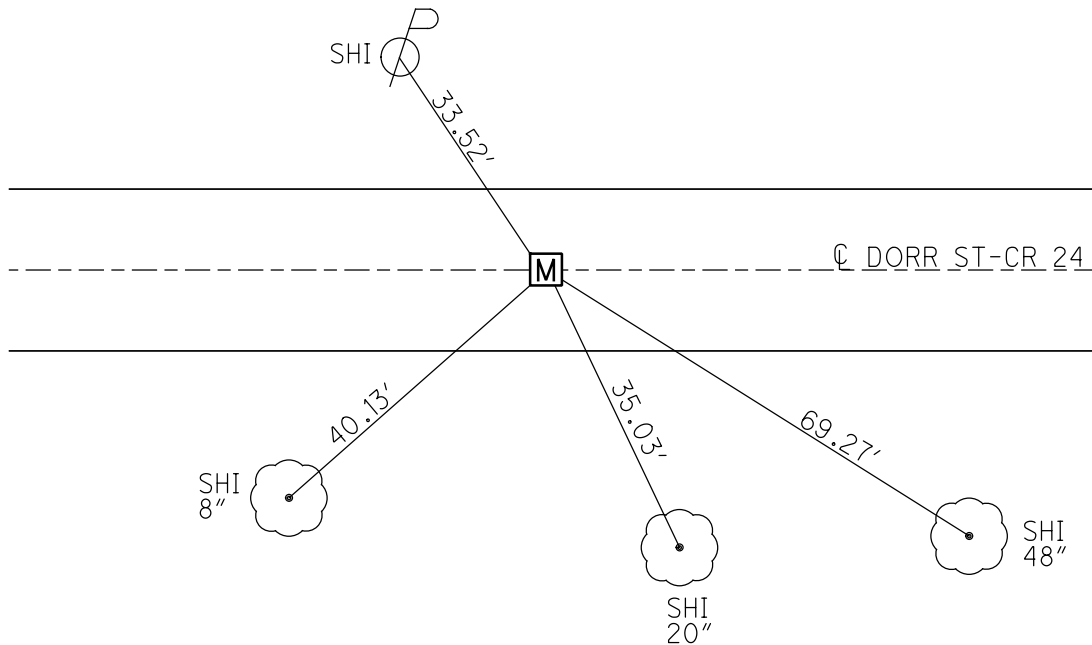

O.D.O.T. DISTRICT 2 SURVEY OFFICE (USE ONLY)


PERSONNEL _____ REFERENCE NO. E SHEET 5 OF 32
 NOTES LUCAS CO. DATE 11/30/98 ROUTE CR 24
 H.C. KAUFMAN WEATHER _____ COUNTY LUCAS
 R.C. _____ TEMP. _____ TOWNSHIP SPENCER
 DWG BY RHOADES PID _____ SECTION 35
 T 9 S R 5 E

TYPE MONUMENT MONBOX W/ GRANITE STONE
~~ON SURFACE~~ - BELOW 2'
 OFFSET \odot PAVEMENT _____ LT : RT
 _____ TO _____ EDGE PAVEMENT
 STATION: _____

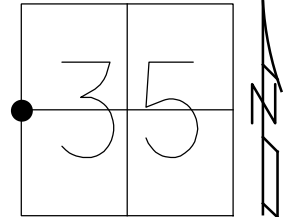

HORZ. DATUM: _____ GEOID: _____
 GRID: NORTHING: 725502.371 EASTING: 1613447.709

RECORD:
 FD MONBOX
 W/ GRANITE STONE
 W/ DRILLH
 2' DOWN
 11/30/98, KAUFMAN

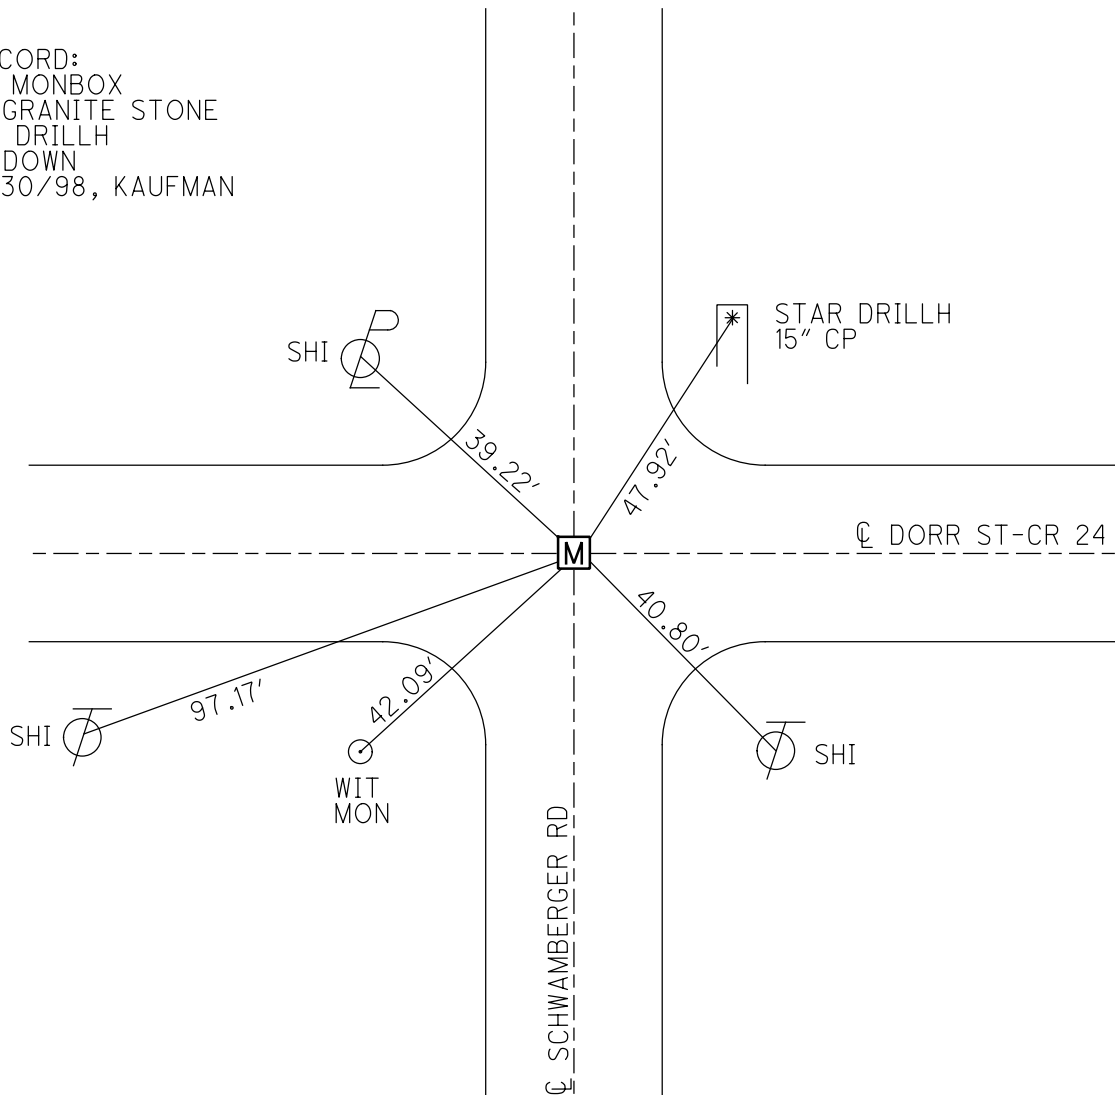

O.D.O.T. DISTRICT 2 SURVEY OFFICE (USE ONLY)

PERSONNEL

REFERENCE NO. F

SHEET 6 OF 32

NOTES LUCAS CO. DATE 9/10/98
H.C. KAUFMAN WEATHER _____
R.C. _____ TEMP. _____

ROUTE CR 24
COUNTY LUCAS
TOWNSHIP SPENCER
SECTION 35

DWG BY RHOADES PID _____

T 9 S R 5 E

TYPE MONUMENT MONBOX W/ CMON

ON SURFACE - ~~BELOW~~ ON _____

OFFSET $\text{\textcircled{C}}$ PAVEMENT _____ LT : RT

_____ TO _____ EDGE PAVEMENT


STATION: _____

HORIZ.DATUM: _____


GEOID: _____

GRID: NORTHING: 725543.698

EASTING: 1616114.304

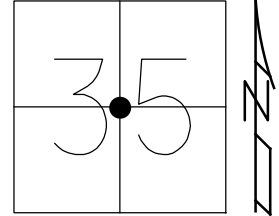

RECORD:
SET MONBOX
W/ CMON
11/30/98, KAUFMAN

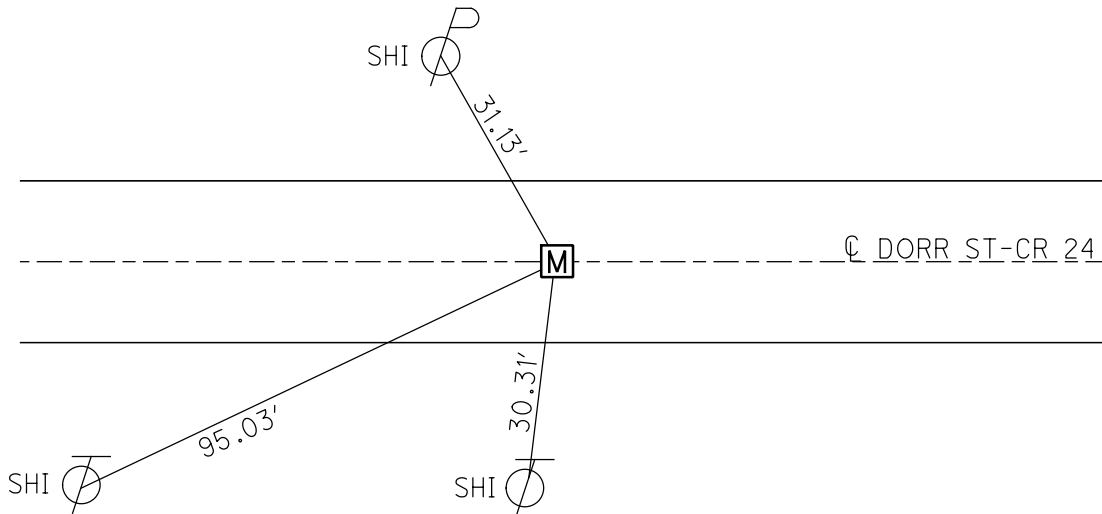

O.D.O.T. DISTRICT 2 SURVEY OFFICE (USE ONLY)

PERSONNEL

REFERENCE NO. G

SHEET 7 OF 32

NOTES LUCAS CO.

DATE 12/1/98

ROUTE CR 24

H.C. KAUFMAN

WEATHER

COUNTY LUCAS

R.C.

TEMP.

TOWNSHIP SPENCER

SECTION 36

DWG BY RHOADES

PID

T 9 S R 5 E

TYPE MONUMENT MONBOX W/ CMON

ON SURFACE - ~~BELOW~~ ON

OFFSET ☉ PAVEMENT _____ LT : RT

_____ TO _____ EDGE PAVEMENT


STATION: _____

HORIZ.DATUM: _____


GEOID: _____

GRID: NORTHING: 725585.634

EASTING: 1618822.536

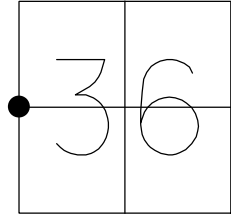


RECORD:
FD MONBOX
W/ CMON
12/1/98, KAUFMAN

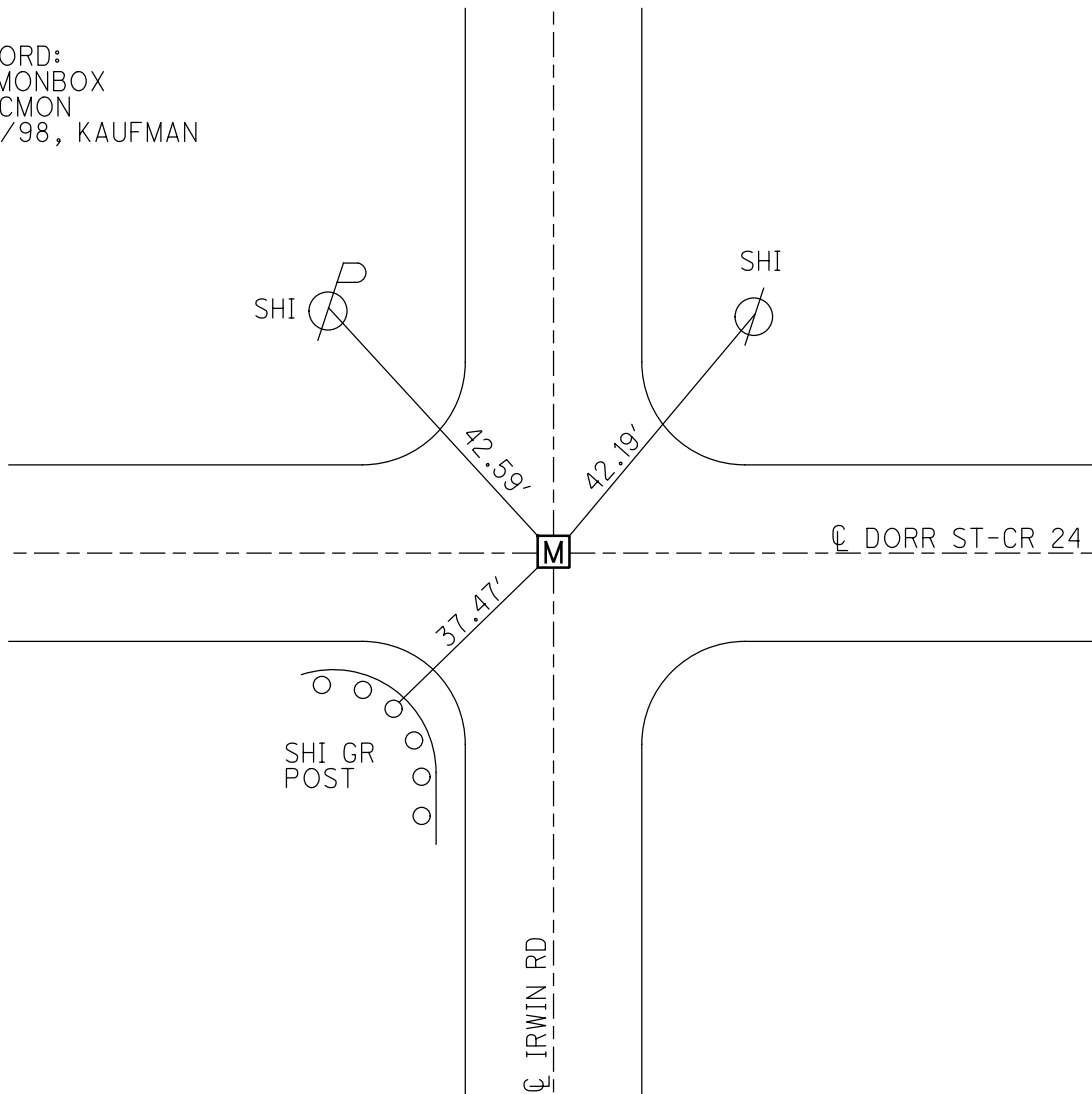

O.D.O.T. DISTRICT 2 SURVEY OFFICE (USE ONLY)


PERSONNEL _____ REFERENCE NO. H SHEET 8 OF 32
 NOTES LUCAS CO. DATE 2/1/12 ROUTE CR 24
 H.C. CORNELL WEATHER _____ COUNTY LUCAS
 R.C. _____ TEMP. _____ TOWNSHIP SPENCER
 DWG BY RHOADES PID _____ SECTION 36
 T 9 S R 5 E

TYPE MONUMENT MONBOX W/CMON
 ON SURFACE - ~~BELOW~~ ON _____
 OFFSET ☉ PAVEMENT _____ LT : RT
 _____ TO _____ EDGE PAVEMENT
 STATION: _____

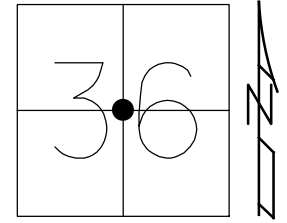

HORZ. DATUM: _____ GEOID: _____
 GRID: NORTHING: 725609.449 EASTING: 1621468.564

RECORD:
 FD R.R.SPIKE
 W/DIMPLE
 8/30/11
 FD MONBOX
 W/ CMON
 2/1/12, CORNELL

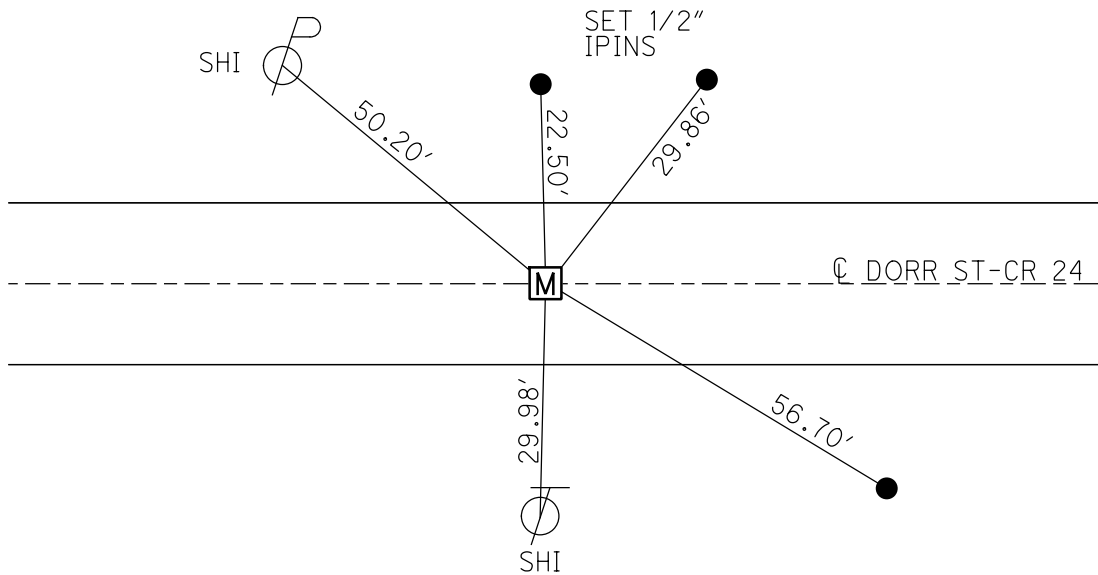

O.D.O.T. DISTRICT 2 SURVEY OFFICE (USE ONLY)

PERSONNEL _____

REFERENCE NO. 1

SHEET 9 OF 32

NOTES LUCAS CO.

DATE 6/26/02

ROUTE CR 24

H.C. CORNELL

WEATHER _____

COUNTY LUCAS

R.C. _____

TEMP. _____

TOWNSHIP SPENCER

SECTION 36

DWG BY RHOADES

PID _____

T 9 S R 5 E

TYPE MONUMENT MONBOX W/CMON W/DIMPLE

ON SURFACE - ~~BELOW~~ ON _____

OFFSET \varnothing PAVEMENT _____ LT : RT

_____ TO _____ EDGE PAVEMENT


STATION: _____

HORZ.DATUM: _____


GEOID: _____

GRID: NORTHING: 725630.088

EASTING: 1623632.788

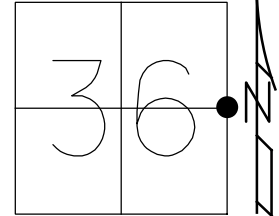

RECORD:
FD MONBOX
W/CMON
W/DIMPLE
6/26/02, CORNELL

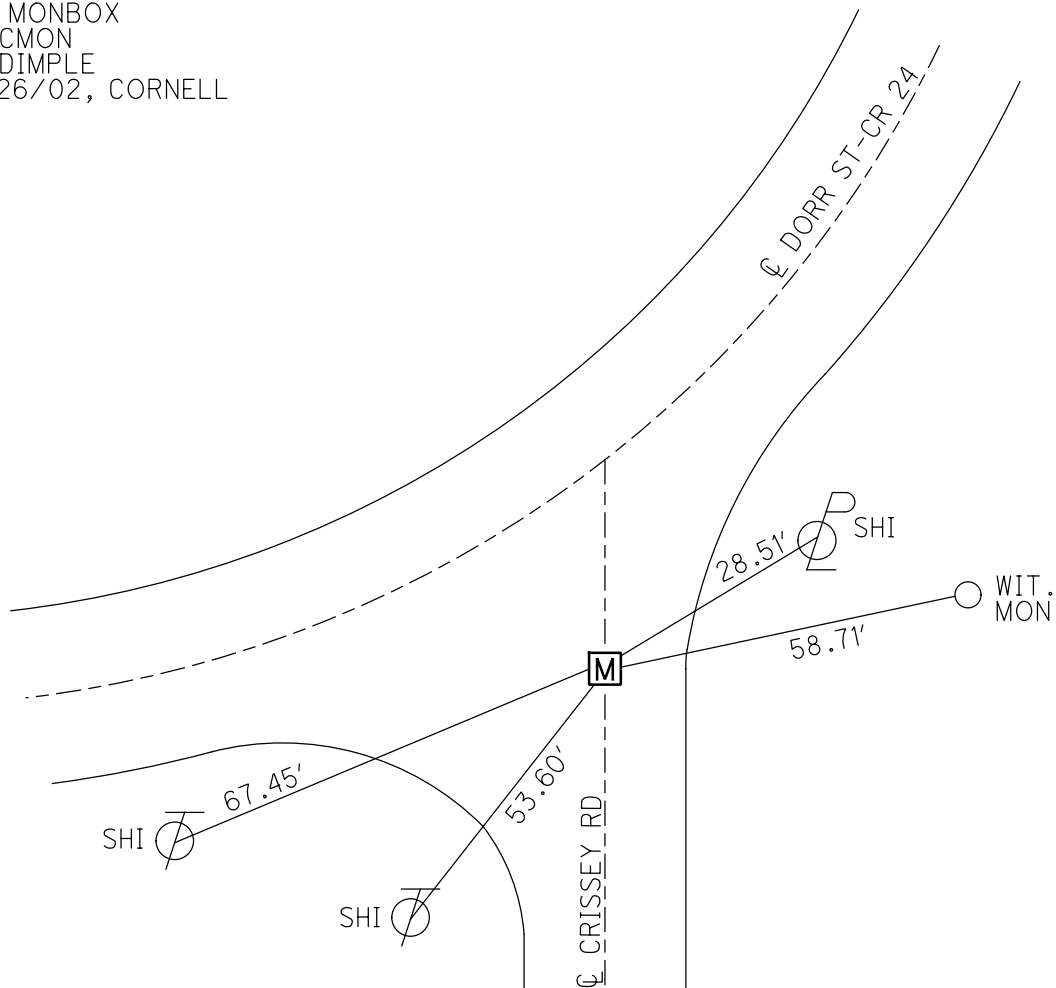

O.D.O.T. DISTRICT 2 SURVEY OFFICE (USE ONLY)

PERSONNEL _____

REFERENCE NO. J

SHEET 10 OF 32

NOTES LUCAS CO.

DATE 6/26/02

ROUTE CR 24

H.C. CORNELL

WEATHER _____

COUNTY LUCAS

R.C. _____

TEMP. _____

TOWNSHIP SPRINGFIELD

DWG BY RHOADES

PID _____

SECTION 6

T 2 USR

TYPE MONUMENT LIMESTONE MON.W/DRILLH

ON SURFACE - ~~BELOW~~ ON _____

OFFSET \odot PAVEMENT _____ LT : RT

_____ TO _____ EDGE PAVEMENT



STATION: _____

HORIZ.DATUM: _____

GEOID: _____

GRID: NORTHING: 726359.481



EASTING: 1623631.751

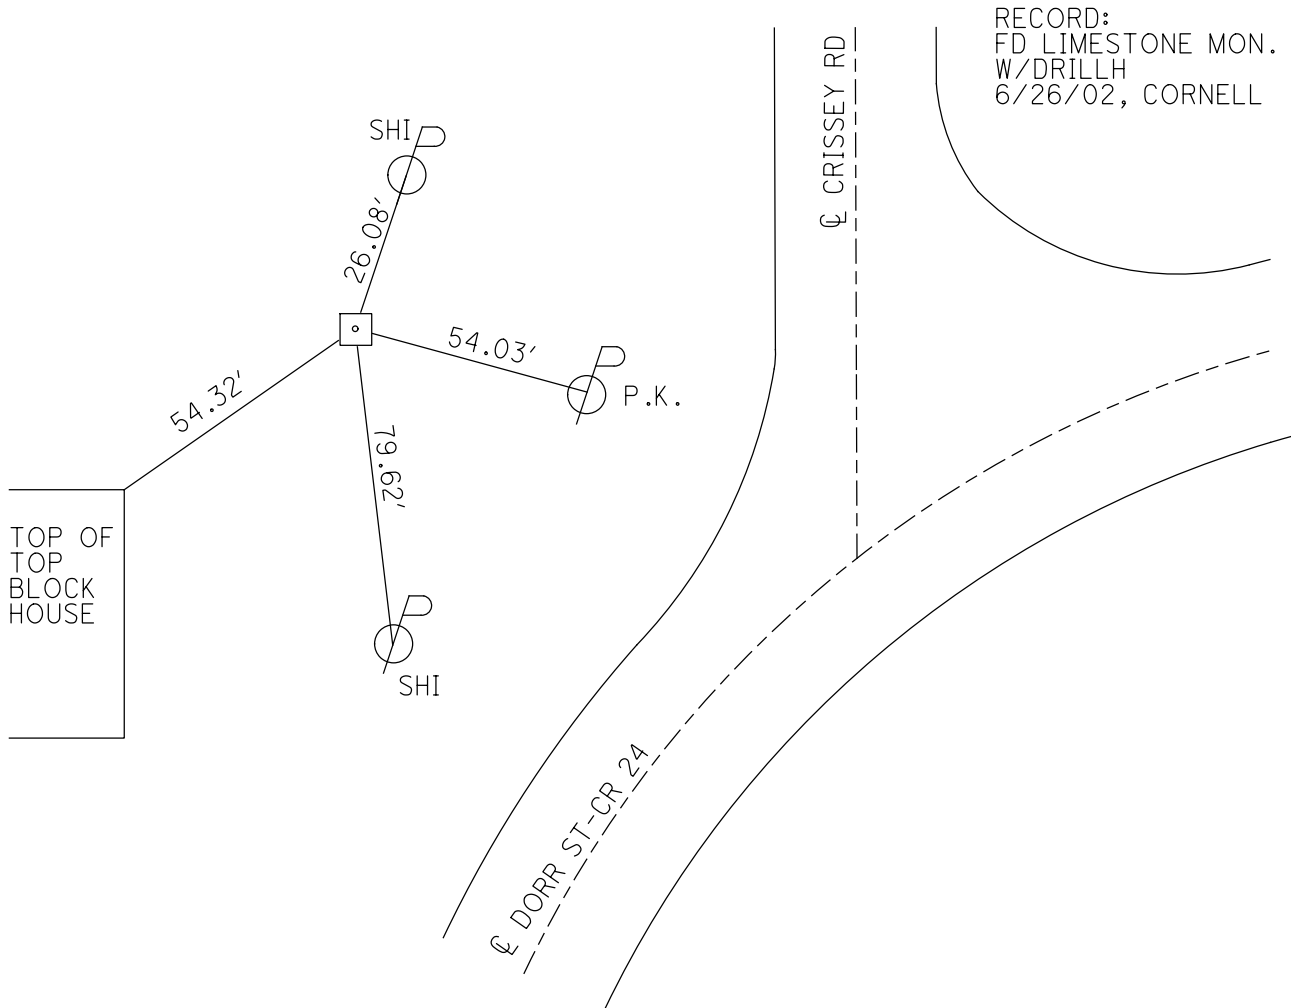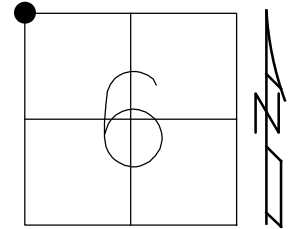

O.D.O.T. DISTRICT 2 SURVEY OFFICE (USE ONLY)


PERSONNEL _____ REFERENCE NO. K SHEET 11 OF 32
 NOTES LUCAS CO. DATE 7/10/18 ROUTE CR 24
 H.C. KAUFMAN WEATHER _____ COUNTY LUCAS
 R.C. _____ TEMP. _____ TOWNSHIP SPRINGFIELD
 _____ SECTION 31
 DWG BY RHOADES PID _____ T 9 S 6 E

TYPE MONUMENT MONBOX W/CMON
 ON SURFACE - ~~BELOW~~ ON _____
 OFFSET $\text{\textcircled{C}}$ PAVEMENT _____ LT : RT _____
 _____ TO _____ EDGE PAVEMENT _____
 STATION: _____

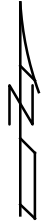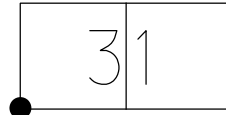

HORZ.DATUM: _____ GEOID: _____
 GRID: NORTHING: 726356.314 EASTING: 1624093.220

RECORD:
 FD MONBOX
 W/CMON
 7/10/18, KAUFMAN

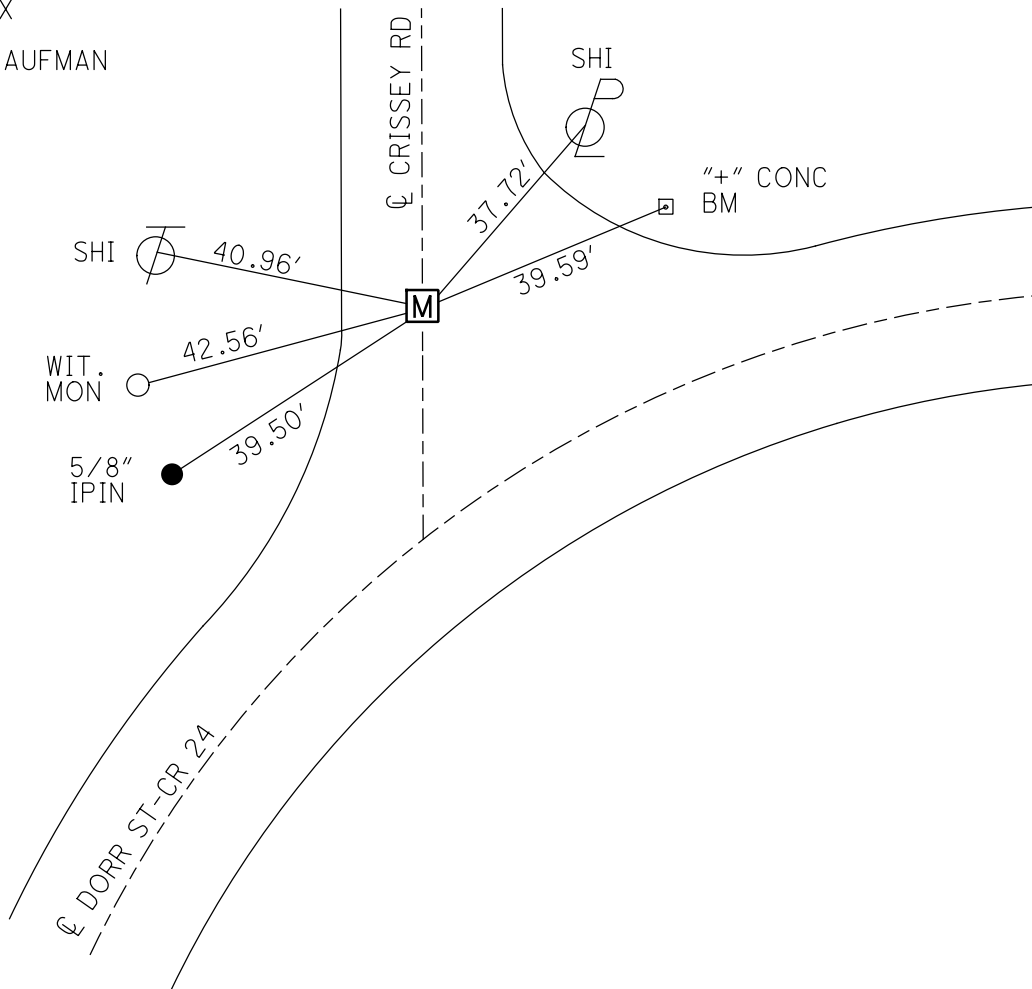

O.D.O.T. DISTRICT 2 SURVEY OFFICE (USE ONLY)

PERSONNEL _____ REFERENCE NO. L SHEET 12 OF 32

NOTES LUCAS CO. DATE 9/10/08 ROUTE CR 24

H.C. CORNELL WEATHER _____ COUNTY LUCAS

R.C. _____ TEMP. _____ TOWNSHIP SPRINGFIELD

SECTION 6

DWG BY RHOADES PID _____

T 2 USR

TYPE MONUMENT IRON BOLT

ON SURFACE - ~~BELOW~~ ON _____


OFFSET \odot PAVEMENT _____ LT : RT

_____ TO _____ EDGE PAVEMENT


STATION: _____

HORZ. DATUM: _____ GEOID: _____

GRID: NORTHING: 726341.218 EASTING: 1626298.025

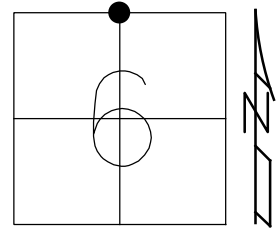

RECORD:
FD IRON BOLT
9/10/08, CORNELL

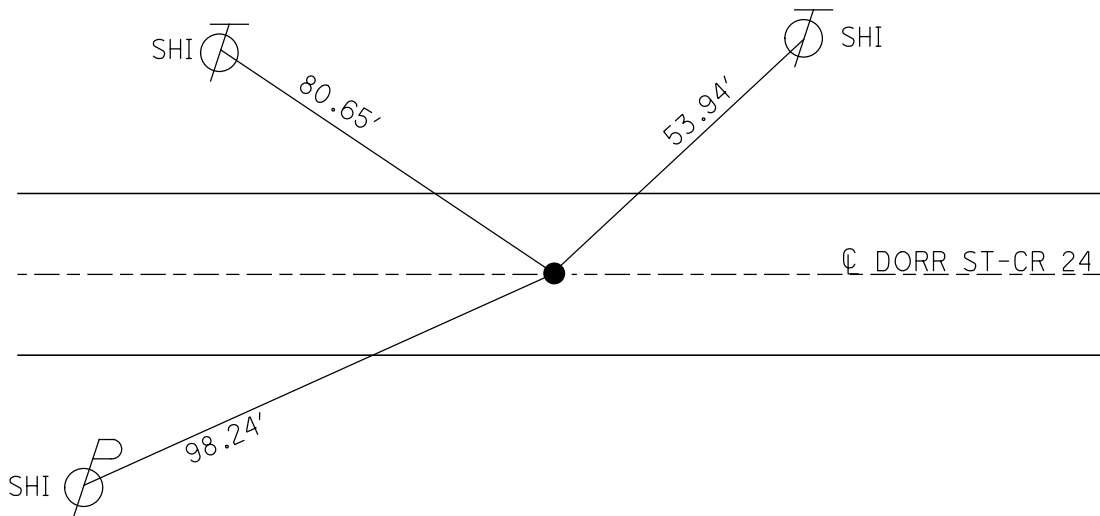

O.D.O.T. DISTRICT 2 SURVEY OFFICE (USE ONLY)

PERSONNEL _____ REFERENCE NO. M SHEET 13 OF 32

NOTES LUCAS CO. DATE 2/19/09 ROUTE CR 24

H.C. KAUFMAN WEATHER _____ COUNTY LUCAS

R.C. _____ TEMP. _____ TOWNSHIP SPRINGFIELD

DWG BY RHOADES PID _____ SECTION 31

TYPE MONUMENT R.R.SPIKE T 9 S R 6 E

ON SURFACE - ~~BELOW~~ ON _____


OFFSET \odot PAVEMENT _____ LT : RT

_____ TO _____ EDGE PAVEMENT


STATION: _____

HORIZ.DATUM: _____ GEOID: _____

GRID: NORTHING: 726338.980 EASTING: 1626625.160

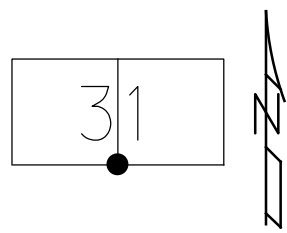

RECORD:
FD R.R.SPIKE
2/19/09, KAUFMAN

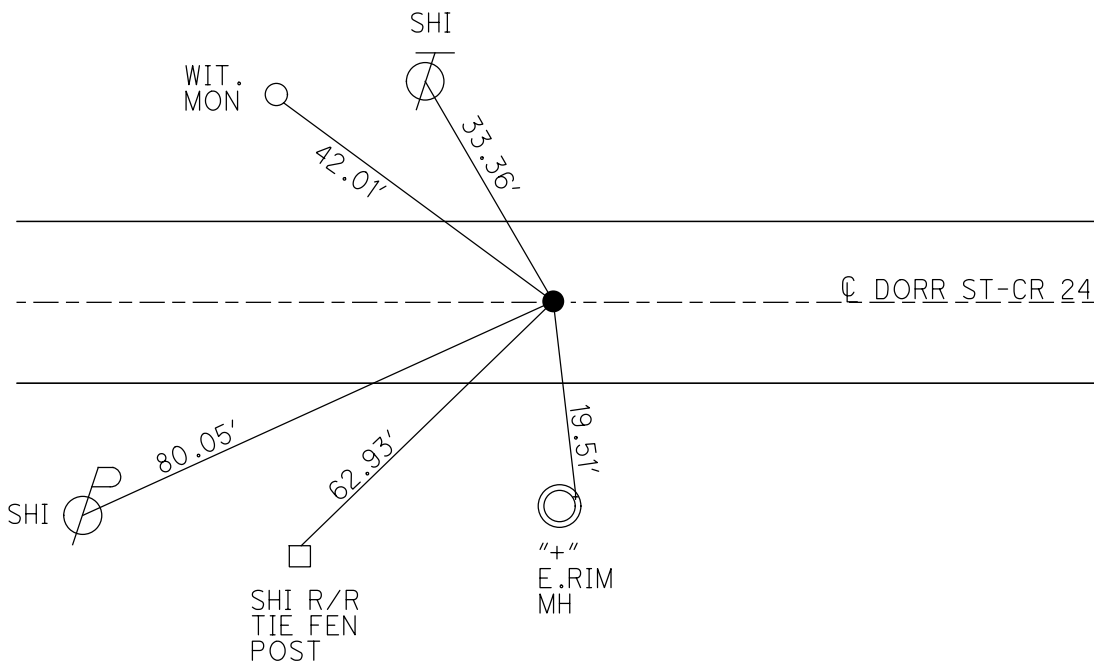

O.D.O.T. DISTRICT 2 SURVEY OFFICE (USE ONLY)

PERSONNEL _____

REFERENCE NO. N

SHEET 14 OF 32

NOTES LUCAS CO.

DATE 11/21/14

ROUTE CR 24

H.C. CORNELL

WEATHER _____

COUNTY LUCAS

R.C. _____

TEMP. _____

TOWNSHIP SPRINGFIELD

DWG BY RHOADES PID _____

SECTION 5

T 2 USR

TYPE MONUMENT 12" CMON W/2" ALUM.PLATE

ON SURFACE - ~~BELOW~~ ON _____

OFFSET \odot PAVEMENT _____ LT : RT

_____ TO _____ EDGE PAVEMENT


STATION: _____

HORZ.DATUM: _____


GEOID: _____

GRID: NORTHING: 726322.687

EASTING: 1628954.138

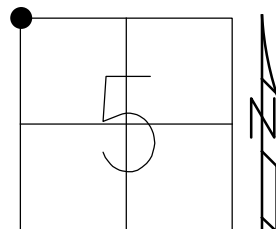

RECORD:
FD 12" CMON
W/2" ALUM.PLATE
11/21/14, CORNELL

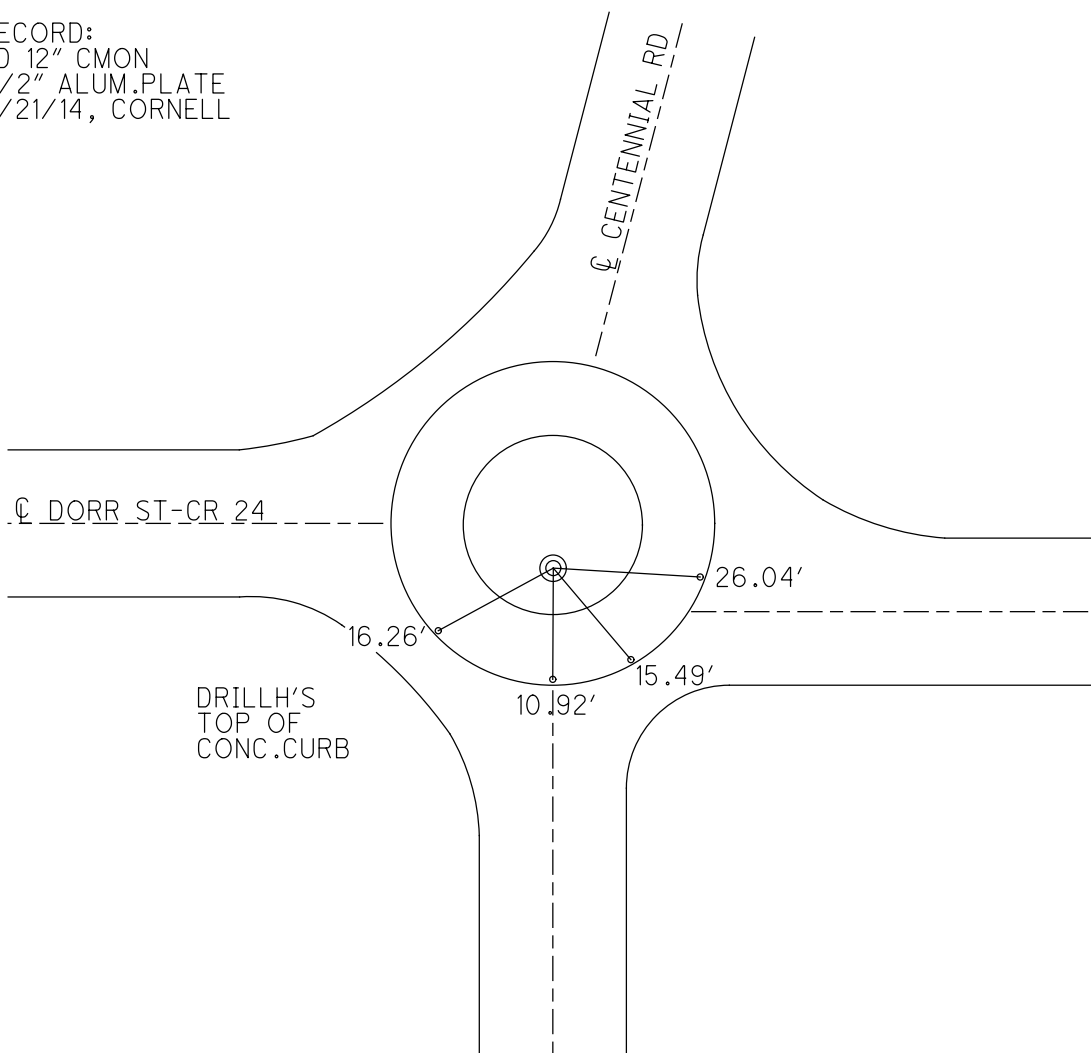

O.D.O.T. DISTRICT 2 SURVEY OFFICE (USE ONLY)

PERSONNEL _____

REFERENCE NO. "0"

SHEET 15 OF 32

NOTES LUCAS CO.

DATE 2/19/09

ROUTE CR 24

H.C. KAUFMAN

WEATHER _____

COUNTY LUCAS

R.C. _____

TEMP. _____

TOWNSHIP SPRINGFIELD

SECTION 32

DWG BY RHOADES

PID _____

T 9 S R 6 E

TYPE MONUMENT MONBOX W/ CMON

ON SURFACE - ~~BELOW~~ ON _____

OFFSET \varnothing PAVEMENT _____ LT : RT

_____ TO _____ EDGE PAVEMENT


STATION: _____

HORZ.DATUM: _____


GEOID: _____

GRID: NORTHING: 726320.781

EASTING: 1629231.985

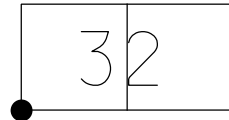

RECORD:
FD MONBOX
W/CMON
9/15/08, KAUFMAN

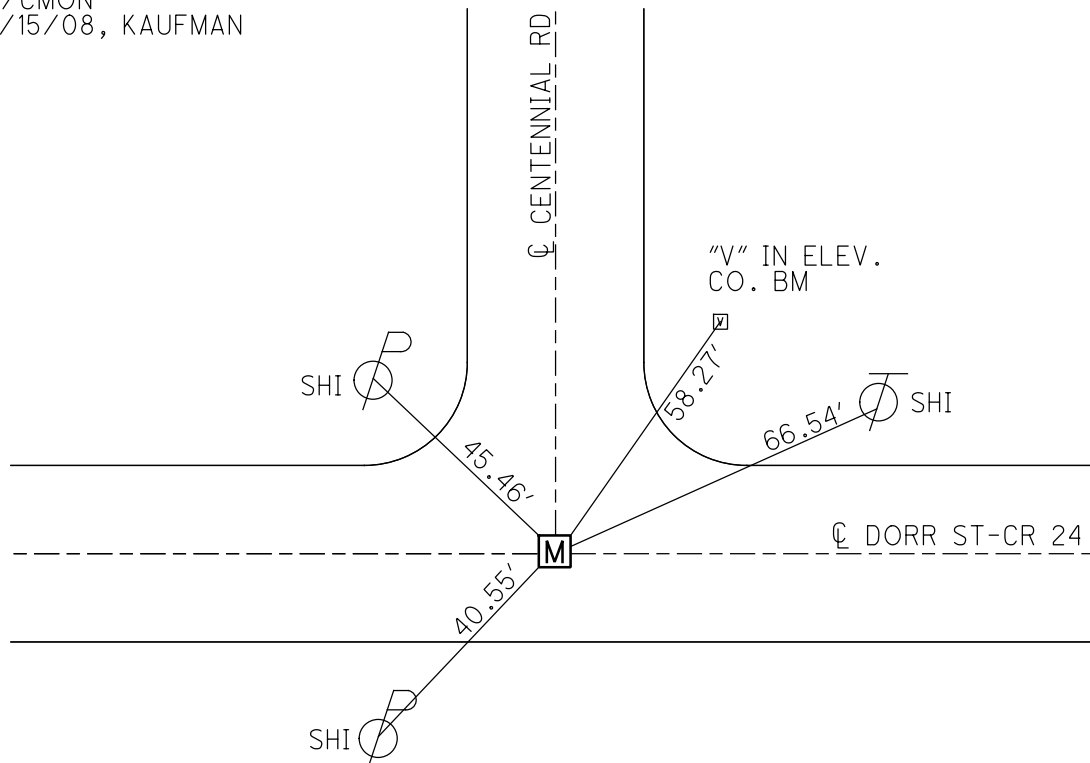

O.D.O.T. DISTRICT 2 SURVEY OFFICE (USE ONLY)

PERSONNEL _____

REFERENCE NO. P

SHEET 16 OF 32

NOTES LUCAS CO.

DATE 9/15/08

ROUTE CR 24

H.C. BURNWORTH

WEATHER _____

COUNTY LUCAS

R.C. _____

TEMP. _____

TOWNSHIP SPRINGFIELD

SECTION 5

DWG BY RHOADES

PID _____

T 2

USR _____

TYPE MONUMENT MONBOX W/CMON

ON SURFACE - ~~BELOW~~ ON _____

OFFSET C PAVEMENT _____ LT : RT _____

_____ TO _____ EDGE PAVEMENT


STATION: _____

HORIZ.DATUM: _____


GEOID: _____

GRID: NORTHING: 726321.315

EASTING: 1629962.202

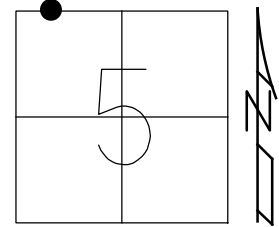

RECORD:
 FD MONBOX
 W/CMON
 9/15/08, BURNWORTH
 6/18/19, BEERS

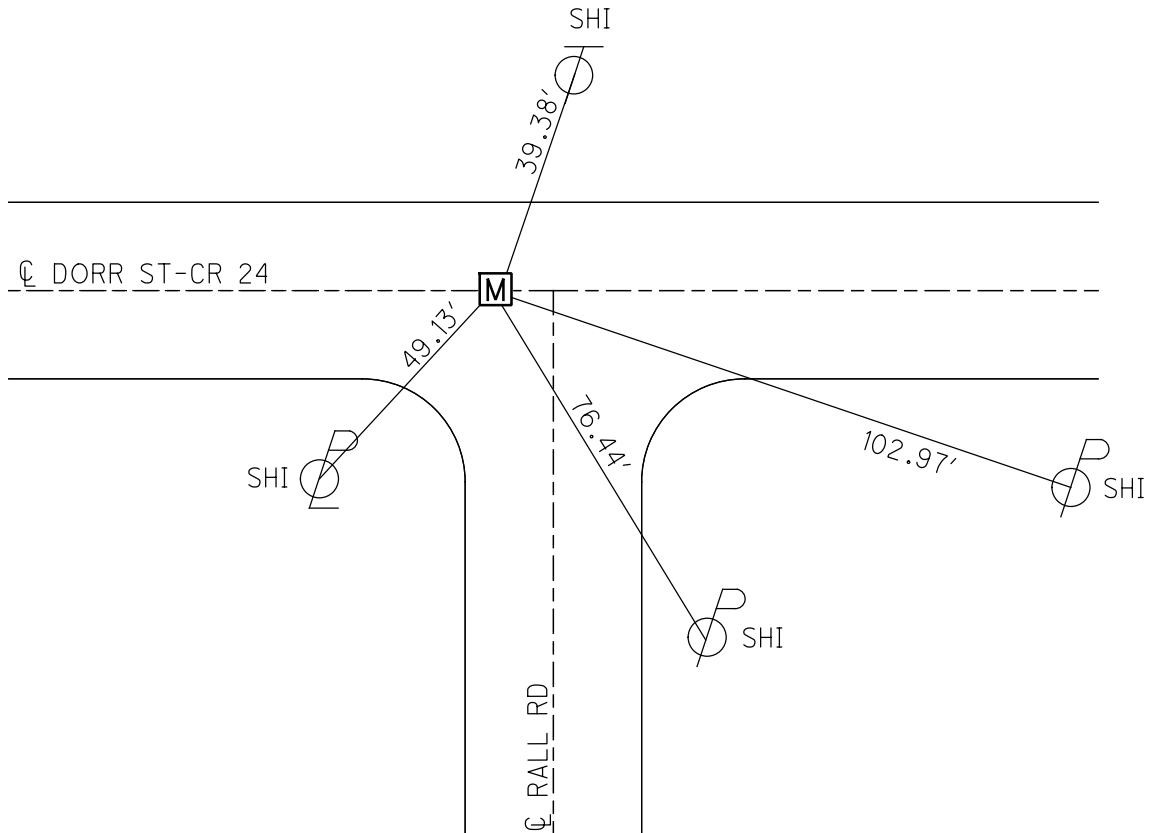

O.D.O.T. DISTRICT 2 SURVEY OFFICE (USE ONLY)

PERSONNEL _____

REFERENCE NO. Q

SHEET 17 OF 32

NOTES LUCAS CO. DATE 9/15/08

ROUTE CR 24

H.C. BURNWORTH WEATHER _____

COUNTY LUCAS

R.C. _____ TEMP. _____

TOWNSHIP SPRINGFIELD

SECTION 5

DWG BY RHOADES PID _____

T 2 USR

TYPE MONUMENT MONBOX W/CMON

ON SURFACE - ~~BELOW~~ ON

OFFSET \odot PAVEMENT _____ LT : RT

_____ TO _____ EDGE PAVEMENT


STATION: _____

HORZ.DATUM: _____


GEOID: _____

GRID: NORTHING: 726319.002

EASTING: 1631617.372

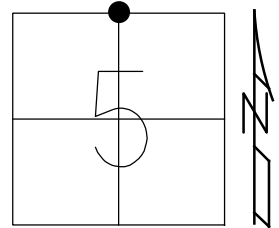

RECORD:
FD MONBOX
W/CMON
9/15/08, BURNWORTH

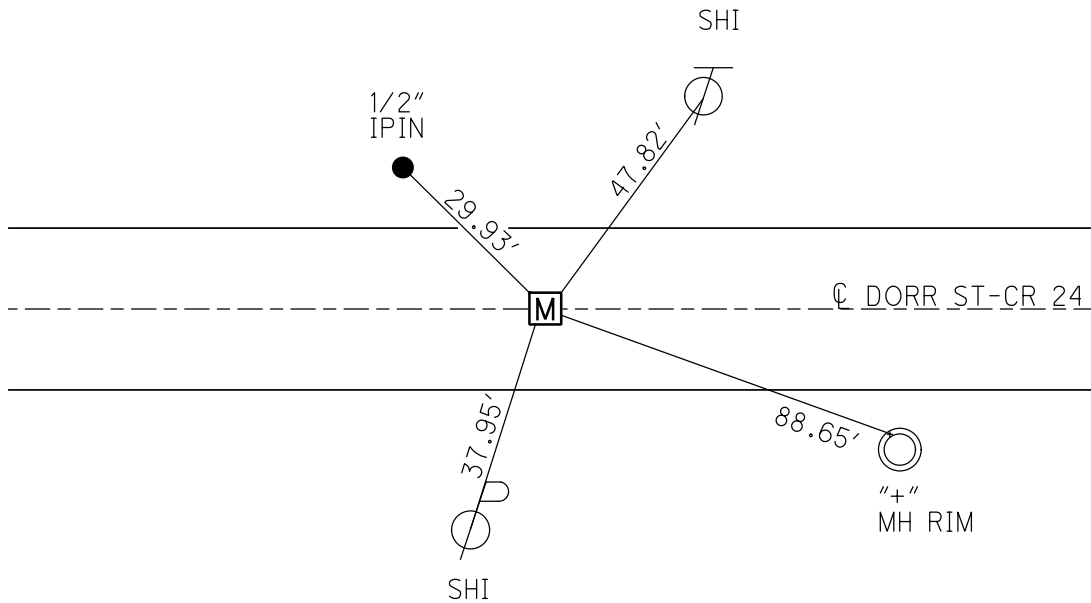

O.D.O.T. DISTRICT 2 SURVEY OFFICE (USE ONLY)

PERSONNEL

REFERENCE NO. R

SHEET 18 OF 32

NOTES LUCAS CO.

DATE 9/19/08

ROUTE CR 24

H.C. KAUFMAN

WEATHER

COUNTY LUCAS

R.C.

TEMP.

TOWNSHIP SPRINGFIELD

SECTION 32

DWG BY RHOADES

PID

T 9 S R 6 E

TYPE MONUMENT MONBOX W/ CMON

ON SURFACE - ~~BELOW~~ ON

OFFSET C PAVEMENT LT : RT

 TO EDGE PAVEMENT


STATION:

HORZ. DATUM:


GEOID:

GRID: NORTHING: 726319.087

EASTING: 1632012.360

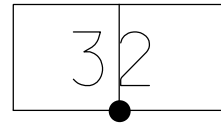

RECORD:
FD MONBOX
W/CMON
9/19/08, KAUFMAN

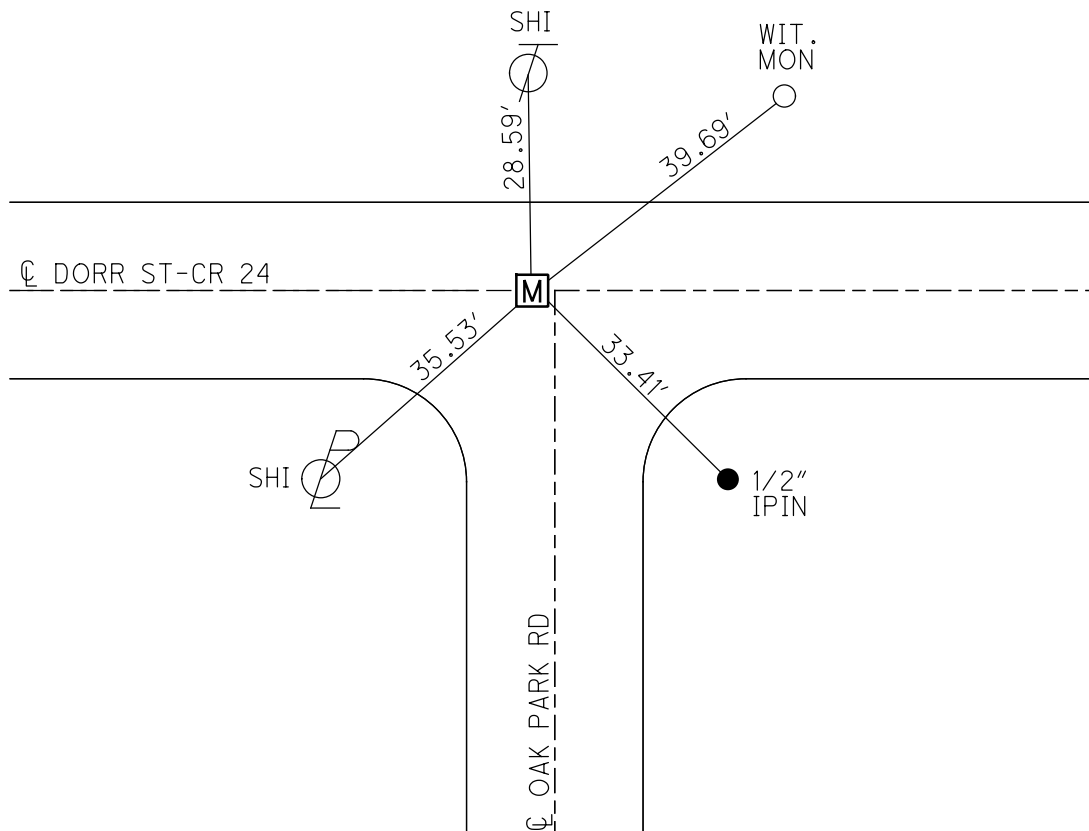

O.D.O.T. DISTRICT 2 SURVEY OFFICE (USE ONLY)

PERSONNEL

REFERENCE NO. S

SHEET 19 OF 32

NOTES LUCAS CO.

DATE 2/17/22

ROUTE CR 24

H.C. BEERS

WEATHER

COUNTY LUCAS

R.C.

TEMP.

TOWNSHIP SPRINGFIELD

SECTION 4

DWG BY RHOADES

PID

T 2

USR

TYPE MONUMENT MONBOX W/CMON

ON SURFACE - ~~BELOW~~ ON

OFFSET \varnothing PAVEMENT _____ LT : RT

_____ TO _____ EDGE PAVEMENT


STATION: _____

HORZ.DATUM: _____


GEOID: _____

GRID: NORTHING: 726319.803

EASTING: 1634251.219

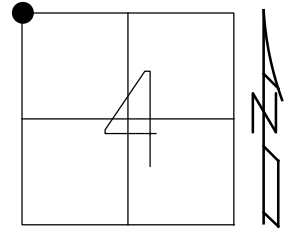

RECORD:
FD MONBOX
W/CMON
3/5/07, KAUFMAN
2/17/22, BEERS

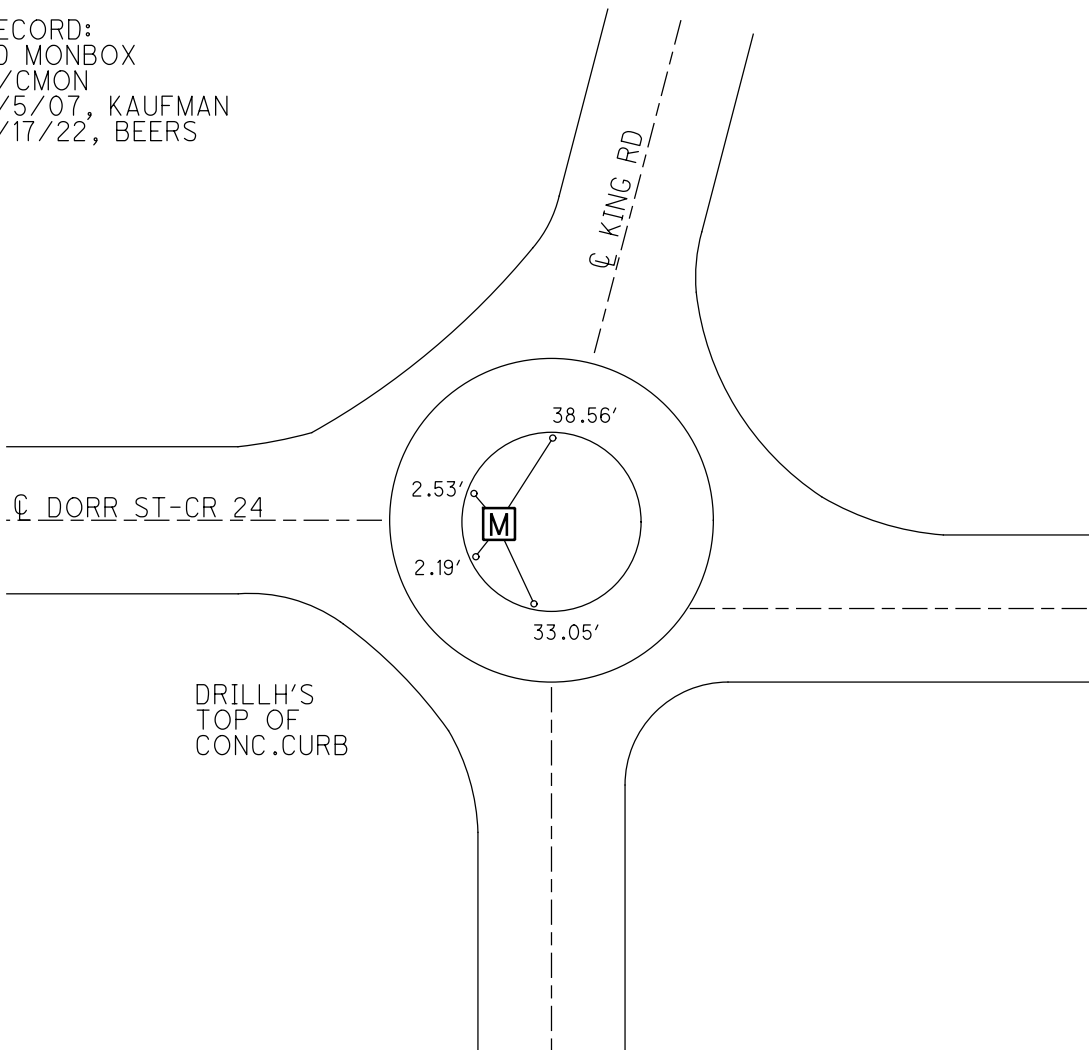

DRILLH'S
TOP OF
CONC.CURB

O.D.O.T. DISTRICT 2 SURVEY OFFICE (USE ONLY)

PERSONNEL _____ REFERENCE NO. T SHEET 20 OF 32

NOTES LUCAS CO. DATE 11/2/16 ROUTE CR 24
 H.C. CORNELL WEATHER _____ COUNTY LUCAS
 R.C. _____ TEMP. _____ TOWNSHIP SPRINGFIELD

DWG BY RHOADES PID _____ SECTION 33
 T 9 S R 6 E

TYPE MONUMENT MONBOX W/ CMON

ON SURFACE - ~~BELOW~~ ON _____


OFFSET \varnothing PAVEMENT _____ LT : RT

_____ TO _____ EDGE PAVEMENT


STATION: _____

HORIZ.DATUM: _____ GEOID: _____

GRID: NORTHING: 726320.781 EASTING: 1629231.985

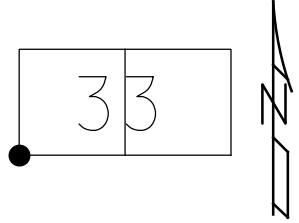

RECORD:
 FD MONBOX
 W/CMON
 W/2" ALUM.CAP
 0.6' DOWN
 11/2/16, CORNELL

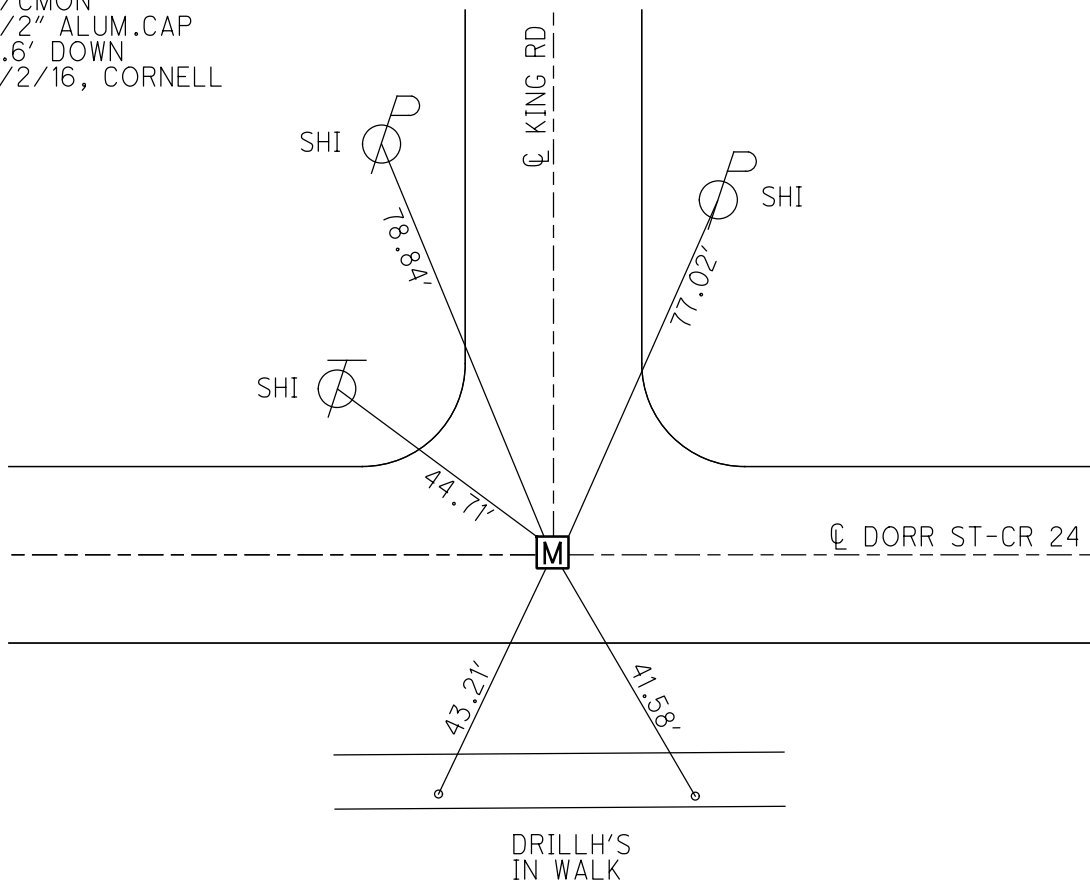

O.D.O.T. DISTRICT 2 SURVEY OFFICE (USE ONLY)

PERSONNEL _____ REFERENCE NO. U SHEET 21 OF 32

NOTES LUCAS CO. DATE 11/17/10 ROUTE CR 24
 H.C. BEERS WEATHER _____ COUNTY LUCAS
 R.C. _____ TEMP. _____ TOWNSHIP SPRINGFIELD
 SECTION 33

DWG BY RHOADES PID _____

T 9 S R 6 E

TYPE MONUMENT MAG NAIL

ON SURFACE - ~~BELOW~~ ON _____

OFFSET \varnothing PAVEMENT _____ LT : RT


_____ TO _____ EDGE PAVEMENT

STATION: _____


HORZ. DATUM: _____ GEOID: _____

GRID: NORTHING: 726349.091 EASTING: 1637349.885

33

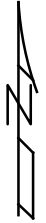

RECORD:
 FD MAG NAIL
 11/17/10, BEERS

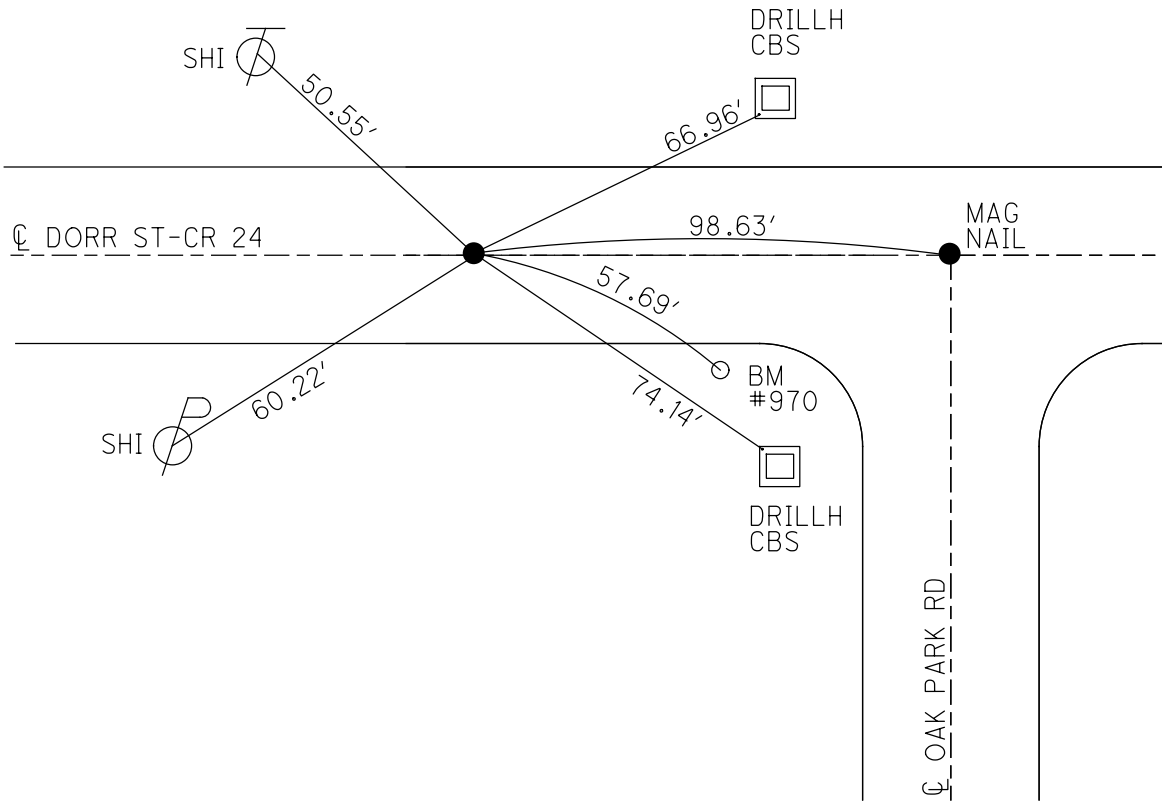

O.D.O.T. DISTRICT 2 SURVEY OFFICE (USE ONLY)

PERSONNEL _____ REFERENCE NO. V SHEET 22 OF 32

NOTES LUCAS CO. DATE 2/8/11 ROUTE CR 24

H.C. BEERS WEATHER _____ COUNTY LUCAS

R.C. _____ TEMP. _____ TOWNSHIP SPRINGFIELD

DWG BY RHOADES PID _____ SECTION 4

T 2 USR

TYPE MONUMENT MONBOX W/4" CMON W/1/2" IPID

ON SURFACE - ~~BELOW~~ ON _____


OFFSET ☉ PAVEMENT _____ LT : RT

_____ TO _____ EDGE PAVEMENT


STATION: _____

HORZ.DATUM: _____ GEOID: _____

GRID: NORTHING: 726309.675 EASTING: 1639569.122

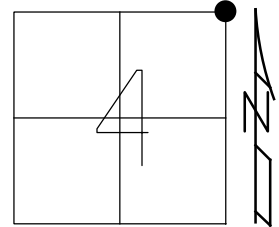


RECORD:
 FD P.K.NAIL
 0.2' DOWN
 8/11/10, BEERS
 SET MONBOX
 W/4" CMON
 W/1/2" IPID
 2/8/11, BEERS

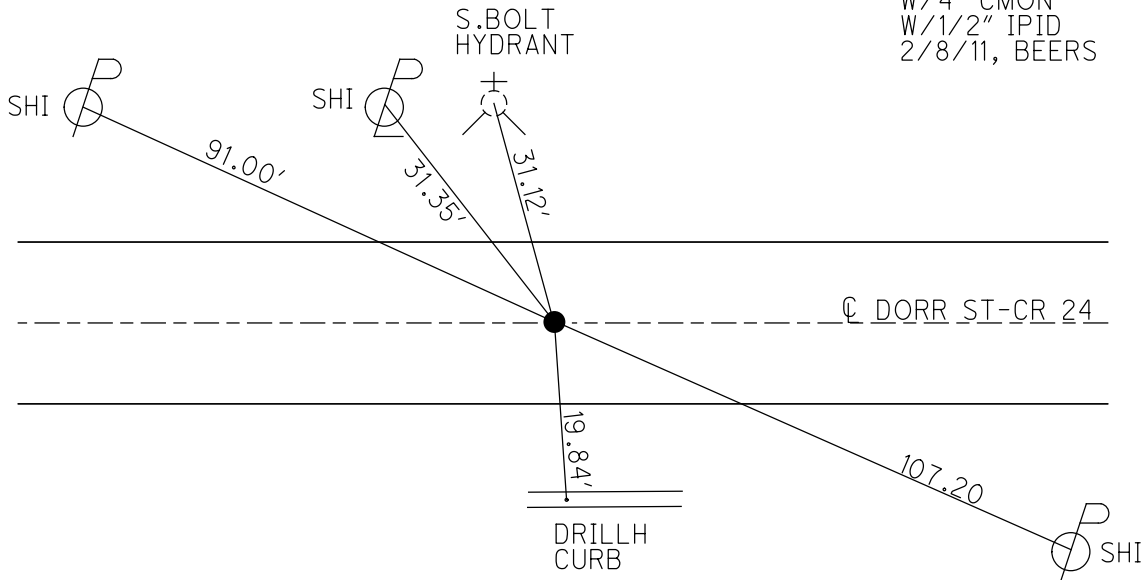

O.D.O.T. DISTRICT 2 SURVEY OFFICE (USE ONLY)


PERSONNEL _____ REFERENCE NO. W SHEET 23 OF 32
 NOTES LUCAS CO. DATE 8/11/10 ROUTE CR 24
 H.C. BEERS WEATHER _____ COUNTY LUCAS
 R.C. _____ TEMP. _____ TOWNSHIP SPRINGFIELD
 DWG BY RHOADES PID _____ T 2 USR _____

TYPE MONUMENT MONBOX W/CMON
 ON SURFACE - ~~BELOW~~ ON _____
 OFFSET $\text{\textcircled{C}}$ PAVEMENT _____ LT : RT _____
 _____ TO _____ EDGE PAVEMENT
 STATION: _____

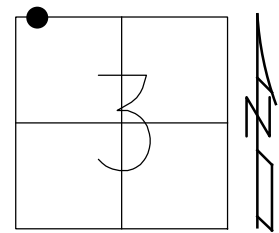

HORZ.DATUM: _____ GEOID: _____
 GRID: NORTHING: 726304.042 EASTING: 1639769.152

RECORD:
 FD P.K.NAIL
 0.2' DOWN
 8/11/10, BEERS
 SET MONBOX
 W/4" CMON
 W/1/2" IPID
 2/8/11, BEERS

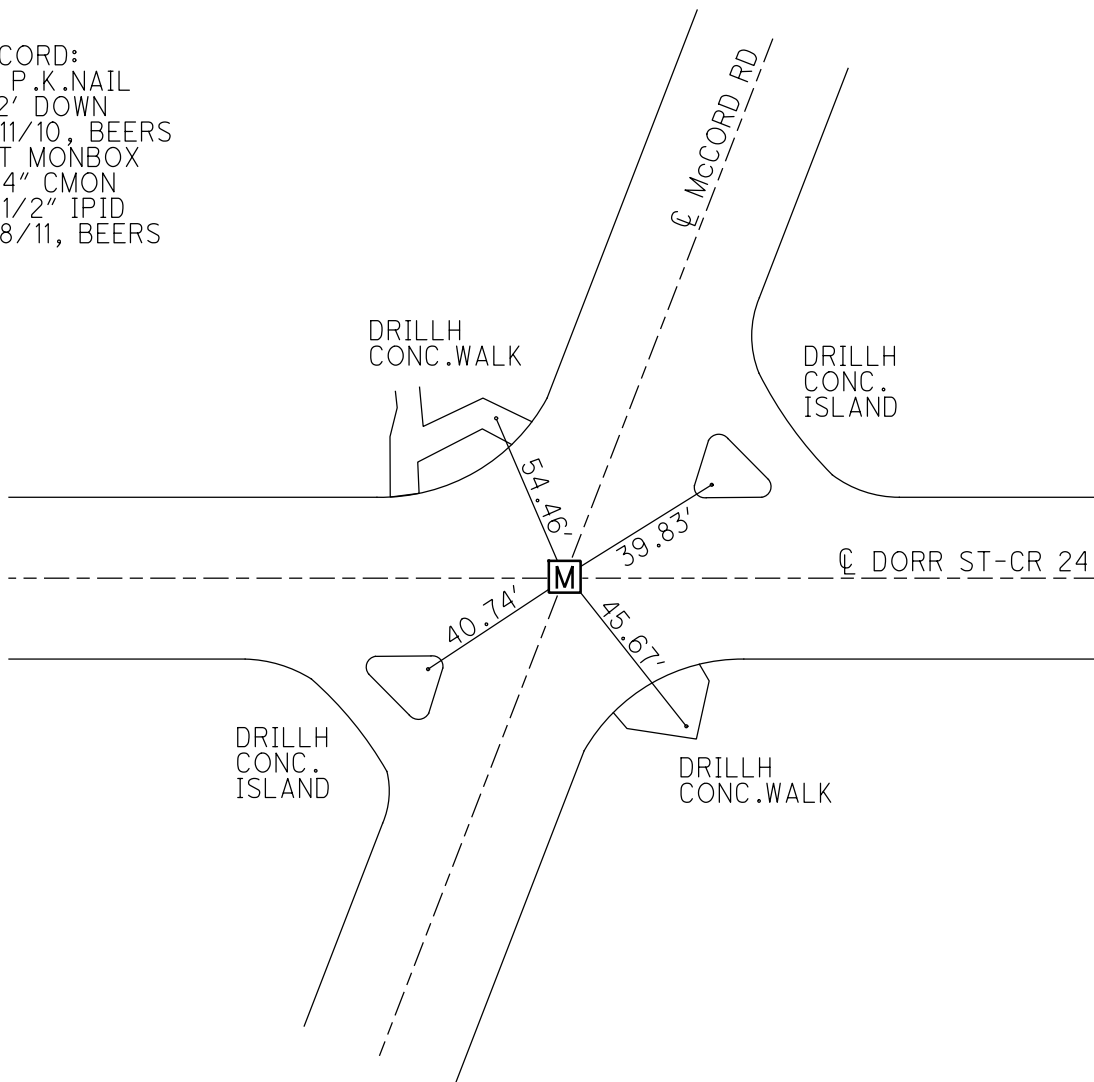

O.D.O.T. DISTRICT 2 SURVEY OFFICE (USE ONLY)

PERSONNEL _____ REFERENCE NO. X SHEET 24 OF 32

NOTES LUCAS CO. DATE 9/19/08 ROUTE CR 24

H.C. KAUFMAN WEATHER _____ COUNTY LUCAS

R.C. _____ TEMP. _____ TOWNSHIP SPRINGFIELD

SECTION 34

DWG BY RHOADES PID _____

T 9 S R 6 E

TYPE MONUMENT MONBOX W/CMON

ON SURFACE - ~~BELOW~~ ON _____



OFFSET \odot PAVEMENT _____ LT : RT

_____ TO _____ EDGE PAVEMENT


STATION: _____

HORZ. DATUM: _____ GEOID: _____

GRID: NORTHING: 726297.602 EASTING: 1639992.680

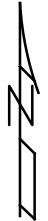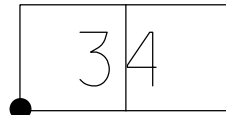

RECORD:
FD MONBOX
W/CMON
9/19/08, KAUFMAN

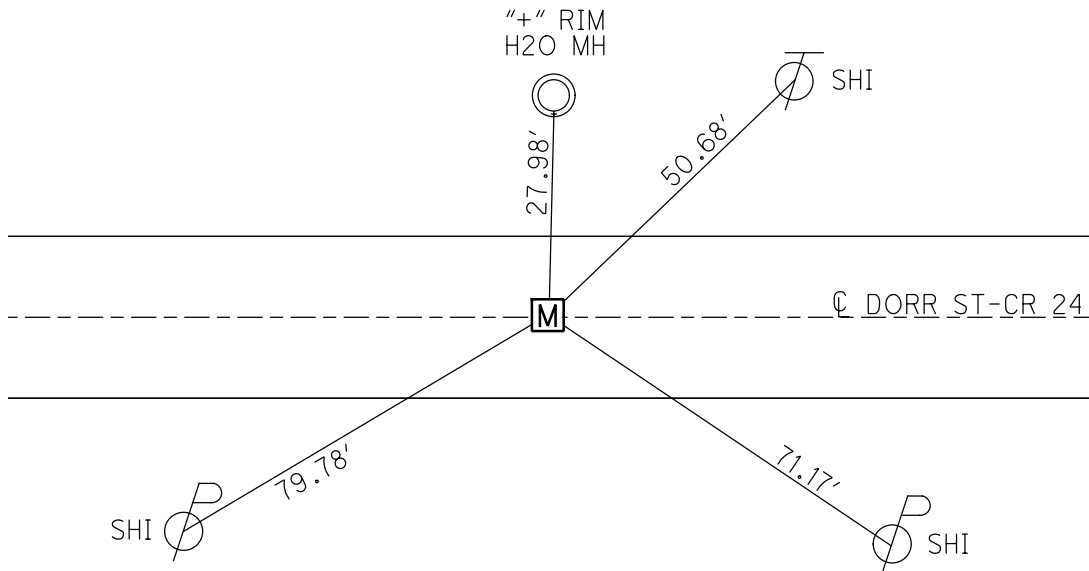


O.D.O.T. DISTRICT 2 SURVEY OFFICE (USE ONLY)


PERSONNEL _____ REFERENCE NO. Y SHEET 25 OF 32
NOTES LUCAS CO. DATE 8/23/21 ROUTE CR 24
H.C. BEERS WEATHER _____ COUNTY LUCAS
R.C. _____ TEMP. _____ TOWNSHIP SPRINGFIELD
DWG BY RHOADES PID _____ SECTION 3
T 2 USR _____

TYPE MONUMENT 12X12" CMON W/BOLT
ON SURFACE - ~~BELOW~~ ON _____
OFFSET ☉ PAVEMENT _____ LT : RT _____
TO _____ EDGE PAVEMENT _____
STATION: _____

HORIZ.DATUM: _____ GEOID: _____
GRID: NORTHING: 726234.990 EASTING: 1642240.445

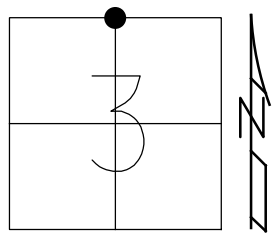

RECORD:
FD 12X12" CMON
W/BOLT
8/23/21, BEERS

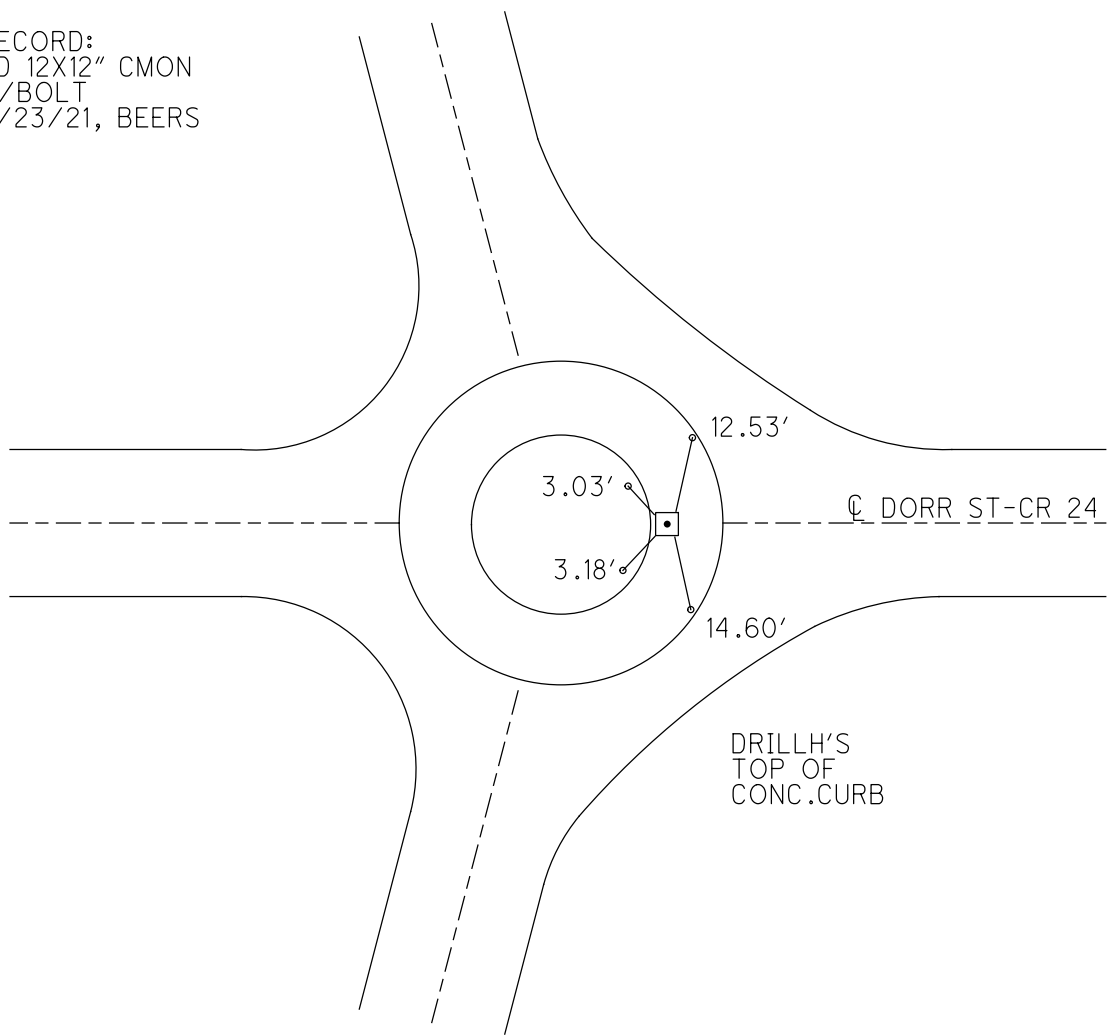

DRILLH'S
TOP OF
CONC.CURB

O.D.O.T. DISTRICT 2 SURVEY OFFICE (USE ONLY)

PERSONNEL _____

REFERENCE NO. Z

SHEET 26 OF 32

NOTES LUCAS CO. DATE 10/7/14

H.C. CORNELL WEATHER _____

R.C. _____ TEMP. _____

ROUTE CR 24

COUNTY LUCAS

TOWNSHIP SPRINGFIELD

SECTION 3

DWG BY RHOADES PID _____

T 2 USR

TYPE MONUMENT MAG NAIL

ON SURFACE - ~~BELOW~~ ON

OFFSET \odot PAVEMENT _____ LT : RT

 TO EDGE PAVEMENT


STATION: _____

HORZ.DATUM: _____


GEOID: _____

GRID: NORTHING: 726230.141

EASTING: 1642405.319

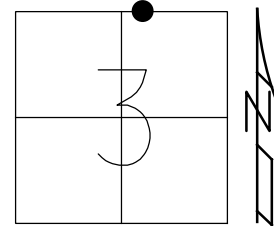

RECORD:
SET MAG NAIL
10/7/14, CORNELL

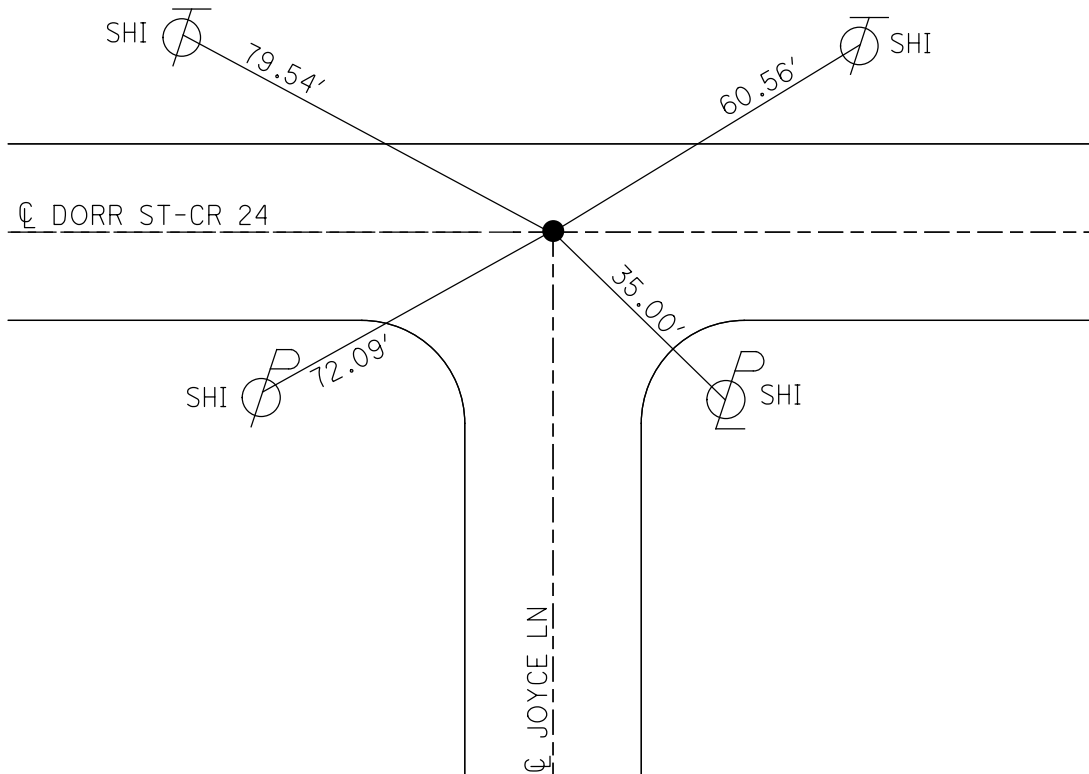

O.D.O.T. DISTRICT 2 SURVEY OFFICE (USE ONLY)

PERSONNEL _____ REFERENCE NO. ZA SHEET 27 OF 32

NOTES LUCAS CO. DATE 8/23/21 ROUTE CR 24

H.C. BEERS WEATHER _____ COUNTY LUCAS

R.C. _____ TEMP. _____ TOWNSHIP SPRINGFIELD

DWG BY RHOADES PID _____ SECTION 34

T 9 S R 6 E

TYPE MONUMENT MONBOX W/1" IPIN

ON SURFACE - ~~BELOW~~ ON _____


OFFSET ϕ PAVEMENT _____ LT : RT

_____ TO _____ EDGE PAVEMENT


STATION: _____

HORZ.DATUM: _____ GEOID: _____

GRID: NORTHING: 726222.941 EASTING: 1642658.652

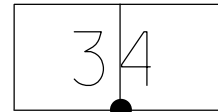

RECORD:
FD MONBOX
W/1" IPIN
8/23/21, BEERS

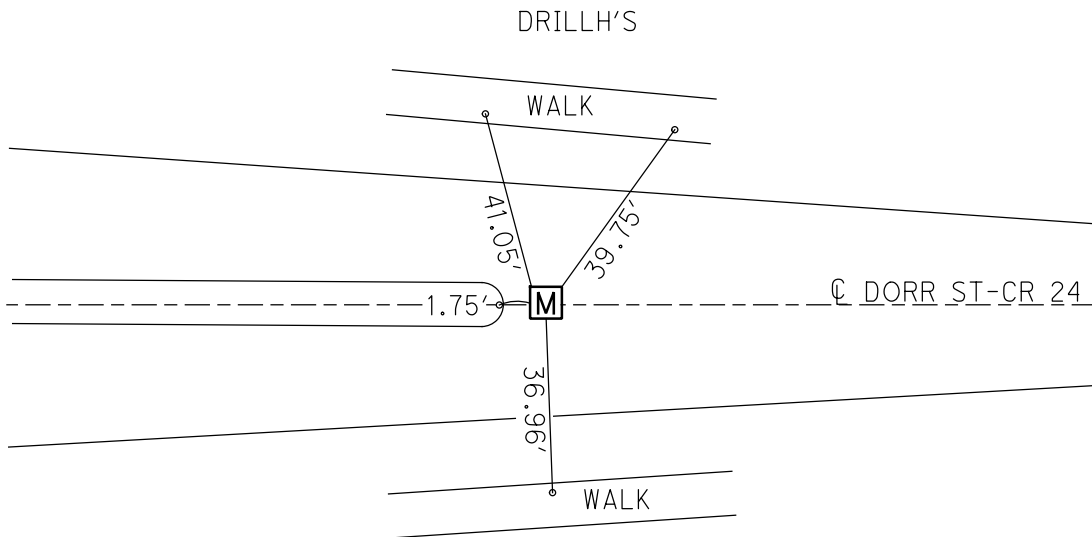

DIST. ZA-ZB= 78.07'

O.D.O.T. DISTRICT 2 SURVEY OFFICE (USE ONLY)

PERSONNEL

REFERENCE NO. ZB

SHEET 28 OF 32

NOTES LUCAS CO.

DATE 10/7/14

ROUTE CR 24

H.C. CORNELL

WEATHER _____

COUNTY LUCAS

R.C. _____

TEMP. _____

TOWNSHIP SPRINGFIELD

DWG BY RHOADES

PID _____

SECTION 3

T 2

USR

TYPE MONUMENT MAG NAIL

ON SURFACE - ~~BELOW~~ ON

OFFSET \odot PAVEMENT _____ LT : RT

_____ TO _____ EDGE PAVEMENT


STATION: _____

HORZ.DATUM: _____


GEOID: _____

GRID: NORTHING: 726220.815

EASTING: 1642736.760

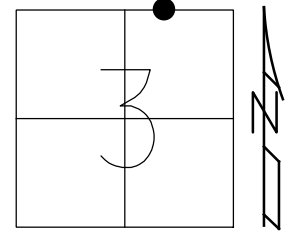


RECORD:
SET MAG NAIL
10/7/14, CORNELL

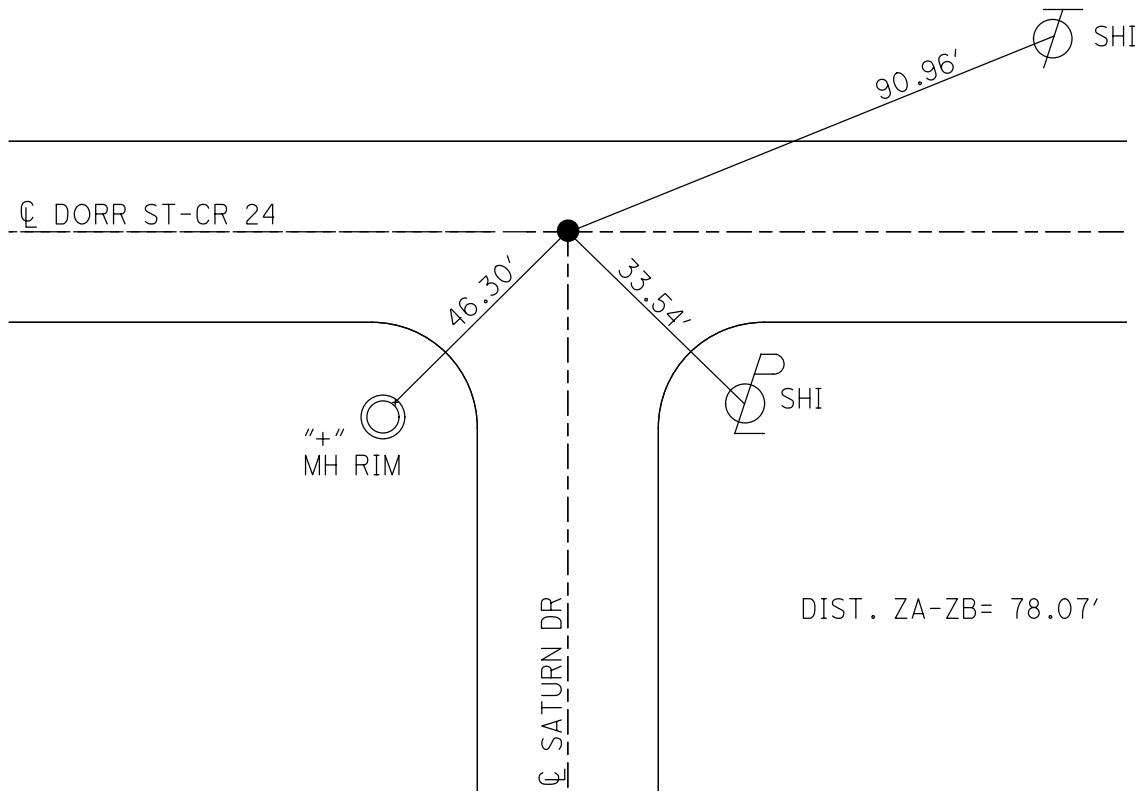

O.D.O.T. DISTRICT 2 SURVEY OFFICE (USE ONLY)


PERSONNEL _____ REFERENCE NO. ZC SHEET 29 OF 32
 NOTES LUCAS CO. DATE 12/27/16 ROUTE CR 24
 H.C. CORNELL WEATHER _____ COUNTY LUCAS
 R.C. _____ TEMP. _____ TOWNSHIP SPRINGFIELD
 _____ SECTION 2
 DWG BY RHOADES PID _____ T 2 USR _____

TYPE MONUMENT MAG NAIL
 ON SURFACE - ~~BELOW~~ ON _____
 OFFSET \odot PAVEMENT _____ LT : RT _____
 _____ TO _____ EDGE PAVEMENT
 STATION: _____

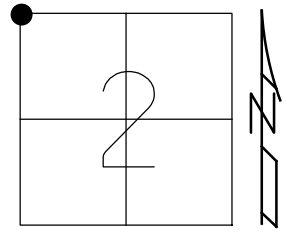

HORIZ.DATUM: _____ GEOID: _____
 GRID: NORTHING: 726160.677 EASTING: 1644887.532

RECORD:
 FD MAG NAIL
 12/27/16, CORNELL

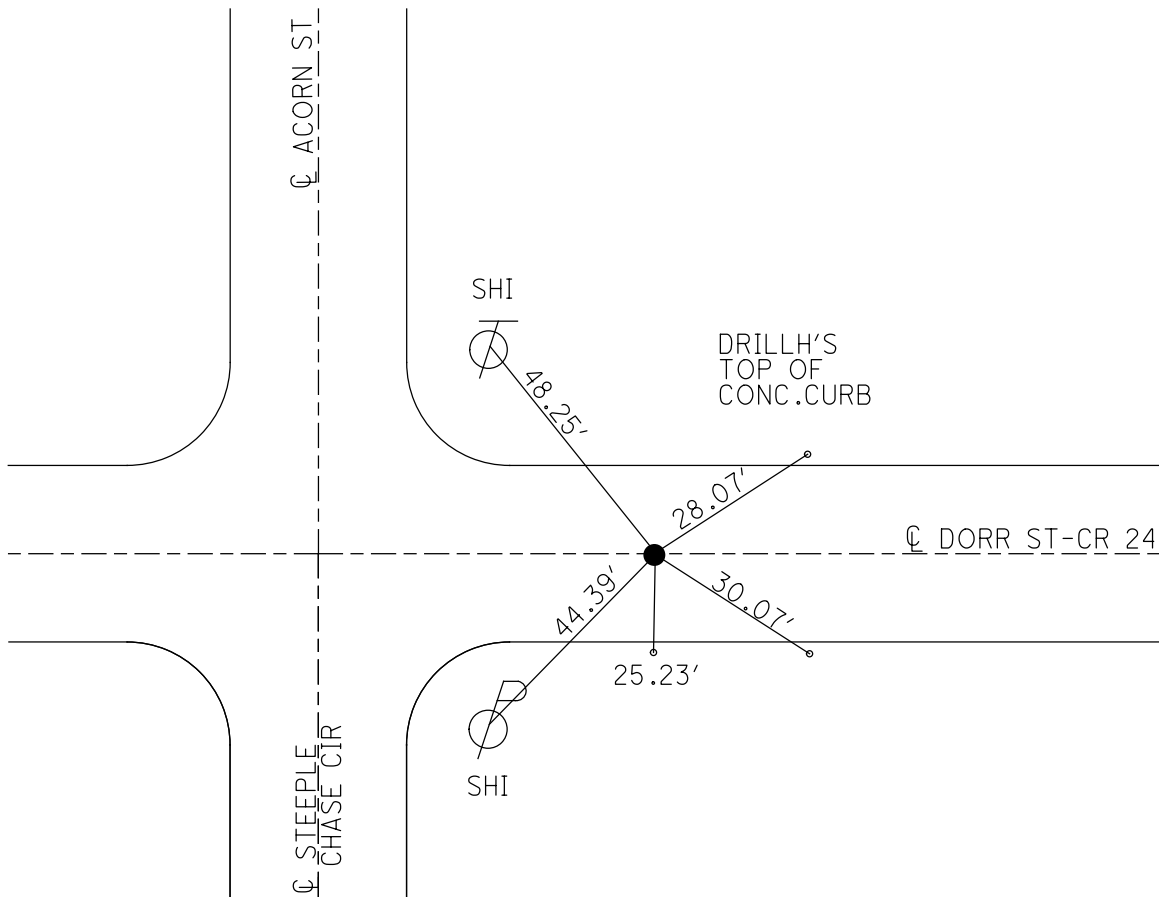

O.D.O.T. DISTRICT 2 SURVEY OFFICE (USE ONLY)

PERSONNEL

REFERENCE NO. ZD

SHEET 30 OF 32

NOTES LUCAS CO.

DATE 12/29/16

ROUTE CR 24

H.C. KAUFMAN

WEATHER

COUNTY LUCAS

R.C.

TEMP.

TOWNSHIP SPRINGFIELD

SECTION 35

DWG BY RHOADES

PID

T 9 S R 6 E

TYPE MONUMENT 6" CMON

ON SURFACE - ~~BELOW~~ ON

OFFSET \odot PAVEMENT _____ LT : RT

_____ TO _____ EDGE PAVEMENT


STATION: _____

HORIZ.DATUM: _____


GEOID: _____

GRID: NORTHING: 726147.791

EASTING: 1645324.967

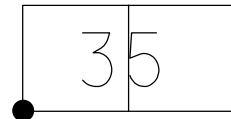

RECORD:
FD 6" CMON
10/14/08
12/29/16, KAUFMAN

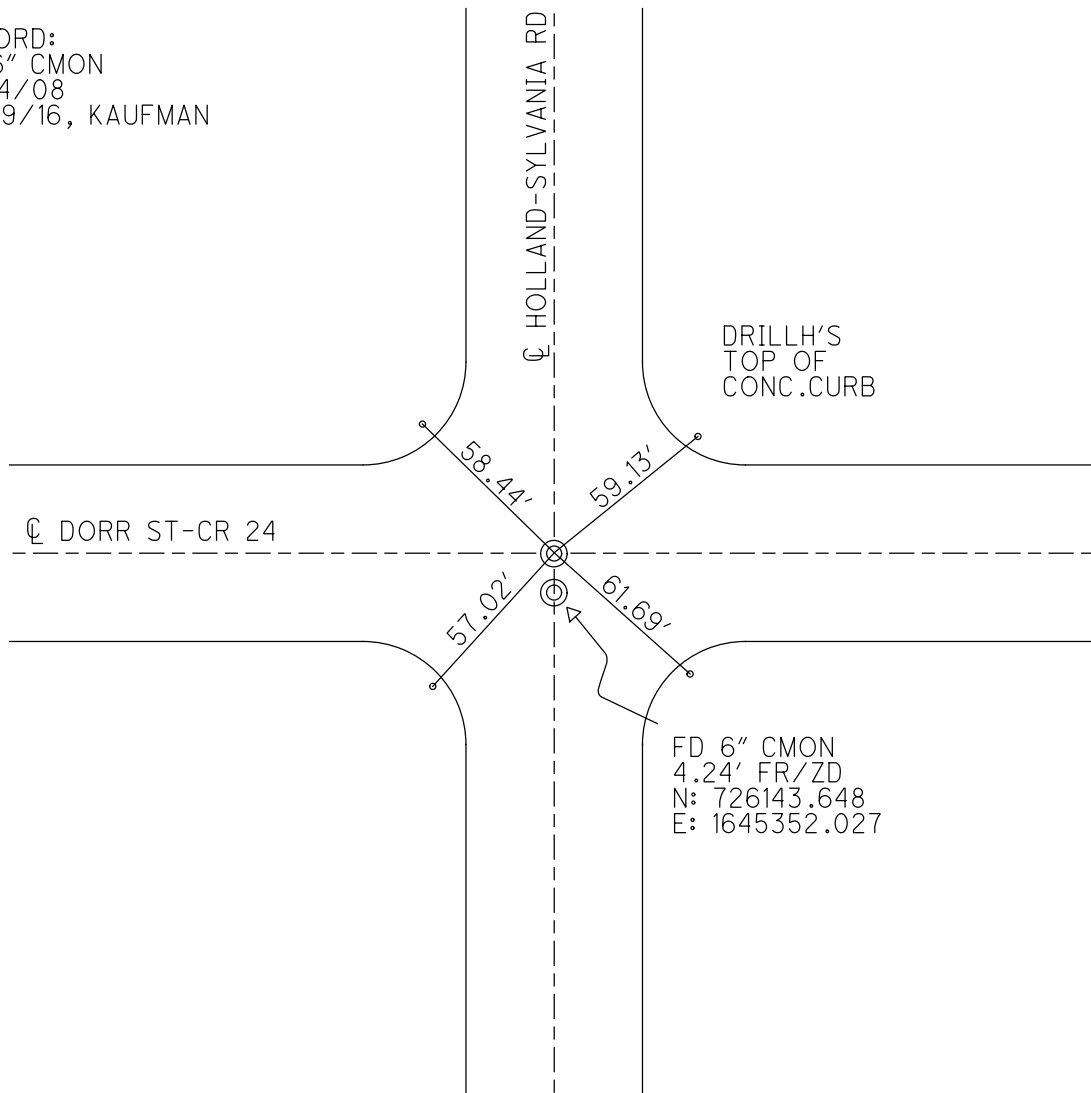

O.D.O.T. DISTRICT 2 SURVEY OFFICE (USE ONLY)

PERSONNEL _____

REFERENCE NO. ZE

SHEET 31 OF 32

NOTES LUCAS CO. DATE 12/27/16

ROUTE CR 24

H.C. CORNELL WEATHER _____

COUNTY LUCAS

R.C. _____ TEMP. _____

TOWNSHIP SPRINGFIELD

DWG BY RHOADES PID _____

SECTION 2

T 2 USR

TYPE MONUMENT R.R.SPIKE

ON SURFACE - ~~BELOW~~ ON _____

OFFSET \varnothing PAVEMENT _____ LT : RT

_____ TO _____ EDGE PAVEMENT


STATION: _____

HORZ.DATUM: _____


GEOID: _____

GRID: NORTHING: 726056.776

EASTING: 1647554.983

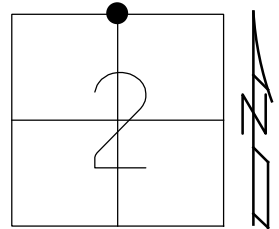


RECORD:
FD MAG NAIL
12/27/16, CORNELL

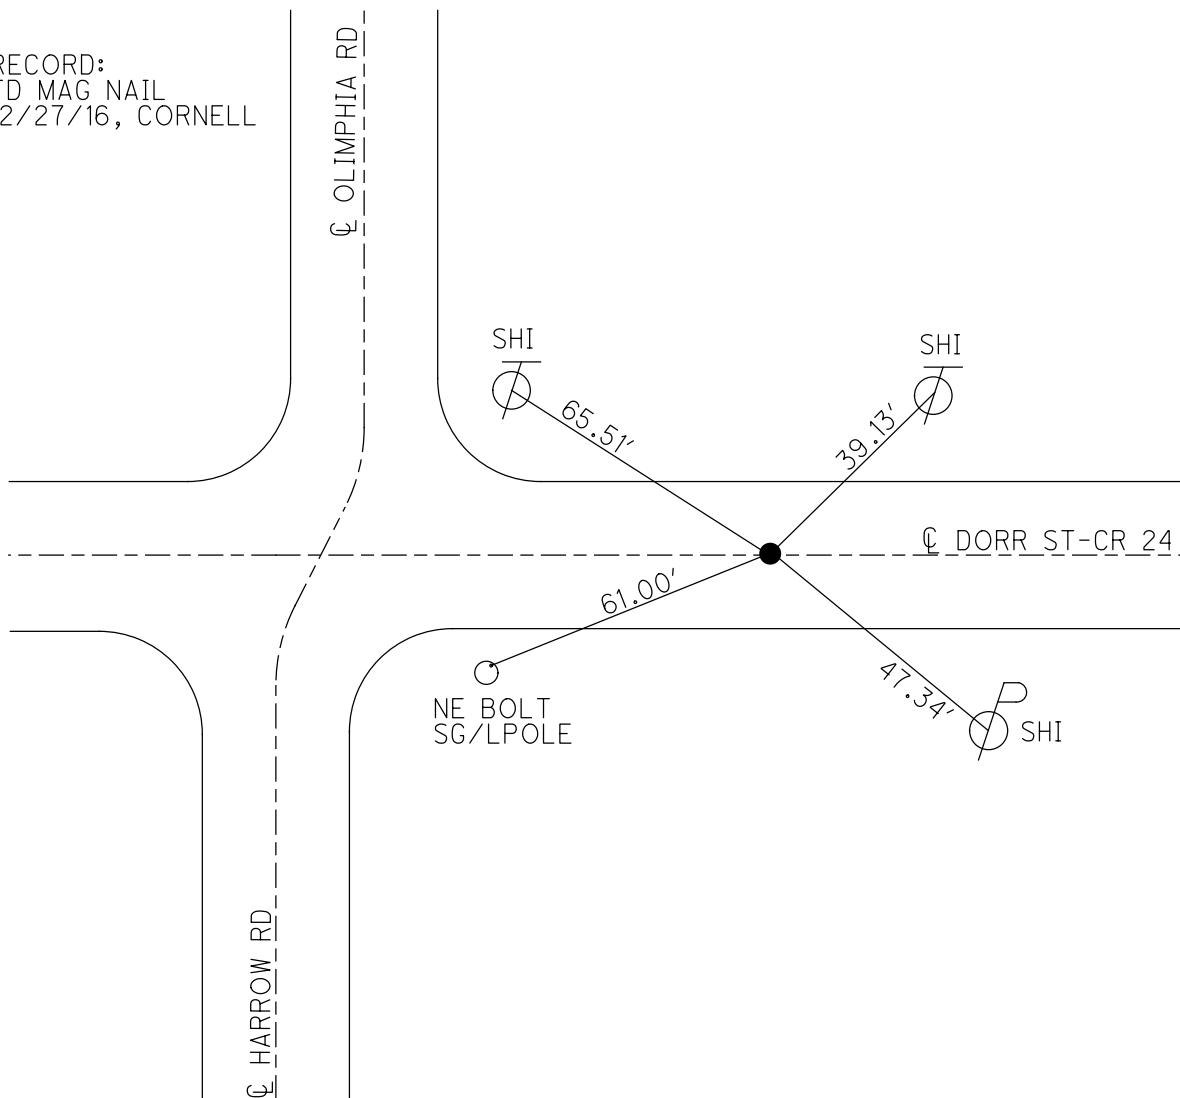


O.D.O.T. DISTRICT 2 SURVEY OFFICE (USE ONLY)

PERSONNEL _____ REFERENCE NO. ZF SHEET 32 OF 32
 NOTES LUCAS CO. DATE 12/27/16 ROUTE CR 24
 H.C. CORNELL WEATHER _____ COUNTY LUCAS
 R.C. _____ TEMP. _____ TOWNSHIP SPRINGFIELD
 DWG BY RHOADES PID _____ T 2 USR _____

TYPE MONUMENT CMON W/BRASS PLATE
 ON SURFACE - ~~BELOW~~ ON _____
 OFFSET \odot PAVEMENT _____ LT : RT _____
 _____ TO _____ EDGE PAVEMENT
 STATION: _____
 HORZ.DATUM: _____ GEOID: _____
 GRID: NORTHING: 725991.877 EASTING: 1648448.204

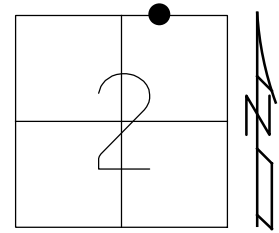

RECORD:
 FD CMON
 W/BRASS PLATE
 12/27/16, CORNELL

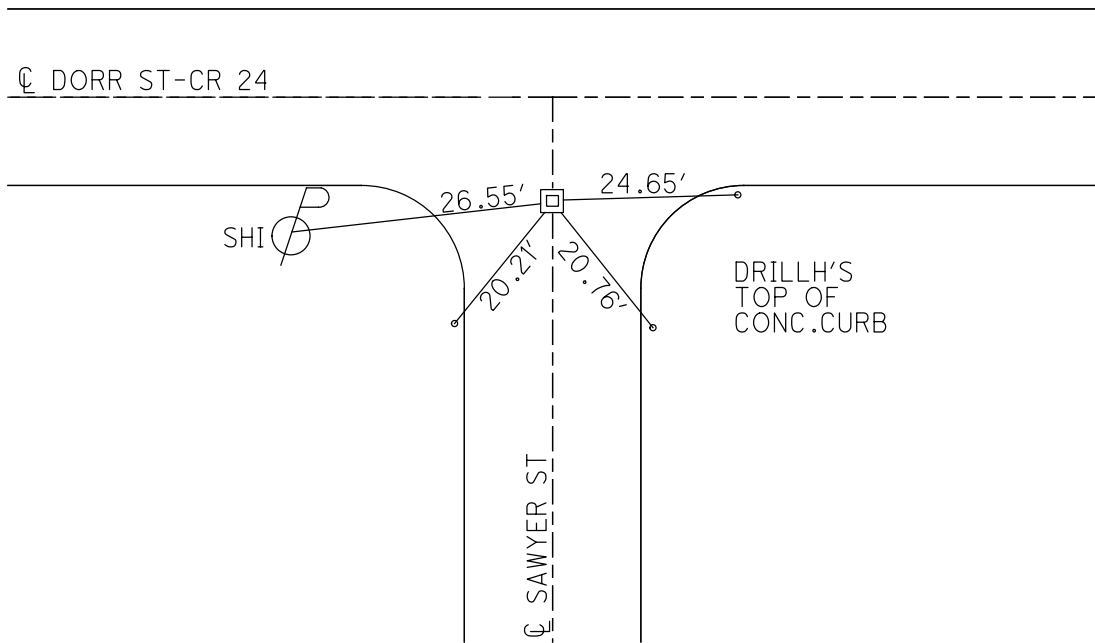

O.D.O.T. DISTRICT 2 SURVEY OFFICE (USE ONLY)

PERSONNEL _____

REFERENCE NO. 1

SHEET 1 OF 12

NOTES DENNO DATE 2/25/66
 H.C. CURTIS WEATHER SUNNY
 R.C. GRANATA TEMP. 26°
OMEY

ROUTE SR 246
 COUNTY LUCAS
 TOWNSHIP CITY OF TOLEDO
 SECTION 35
 T 9 S R 6 E

DWG BY NIESE PID _____

TYPE MONUMENT IPIN IN MONUMENT

ON SURFACE - ~~BELOW~~ ON


OFFSET ☉ PAVEMENT _____ LT : RT

- TO - EDGE PAVEMENT


STATION: 0+00

HORZ. DATUM: _____ GEOID: _____

GRID: NORTHING: _____ EASTING: _____

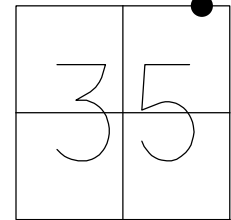

RECORD:
 FD SPIKE
 3/11/53
 FD IPIN IN
 MONUMENT
 2/25/66, WD

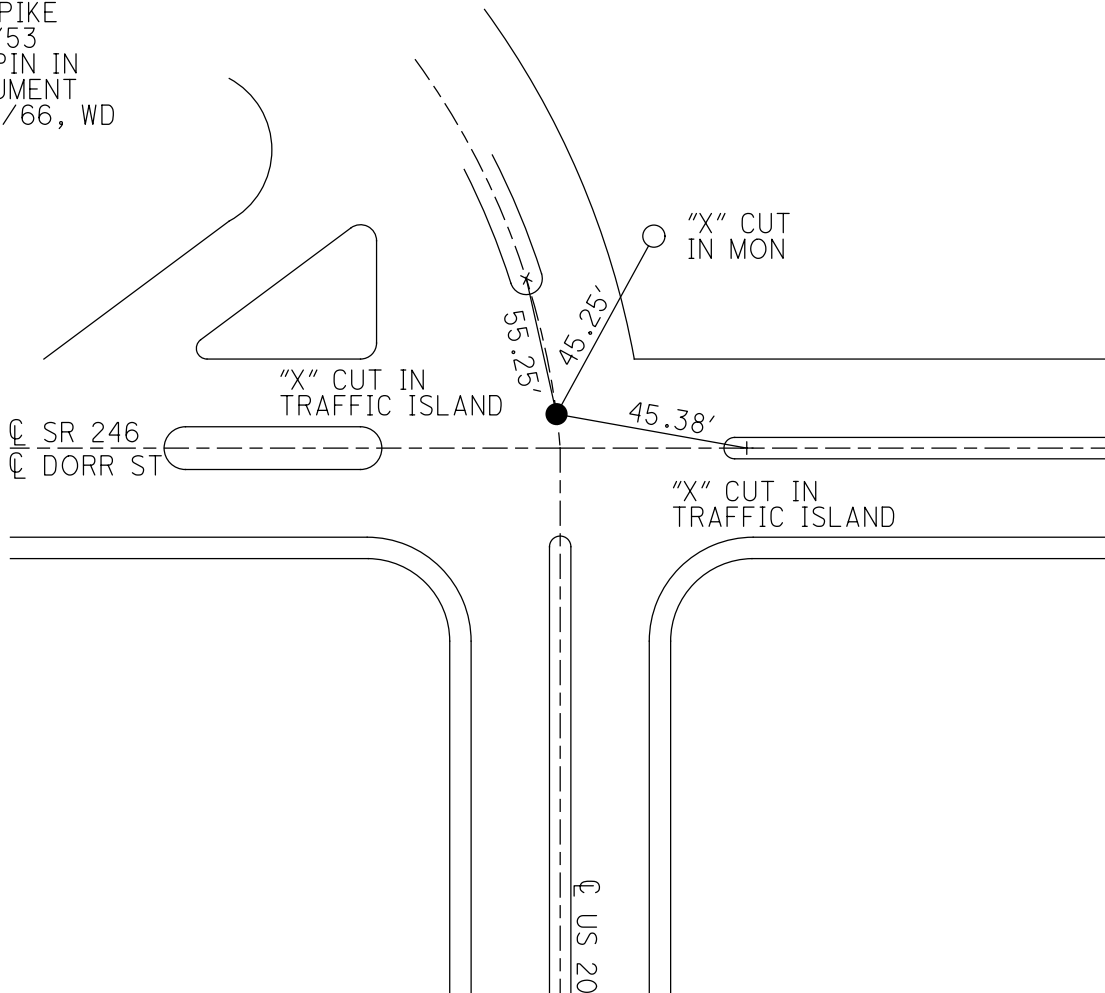

O.D.O.T. DISTRICT 2 SURVEY OFFICE (USE ONLY)

PERSONNEL

REFERENCE NO. 2

SHEET 2 OF 12

NOTES DENNO DATE 2/25/66
 H.C. CURTIS WEATHER SUNNY
 R.C. GRANATA TEMP. 26°
OMEY

ROUTE SR 246
 COUNTY LUCAS
 TOWNSHIP CITY OF TOLEDO
 SECTION 36

DWG BY NIESE PID _____

T 9 S R 6 E

TYPE MONUMENT BRASS MONUMENT

ON SURFACE - ~~BELOW~~ ON


OFFSET \odot PAVEMENT _____ LT : RT

_____ TO _____ EDGE PAVEMENT


STATION: 52+65.24

HORZ. DATUM: _____ GEOID: _____

GRID: NORTHING: _____ EASTING: _____

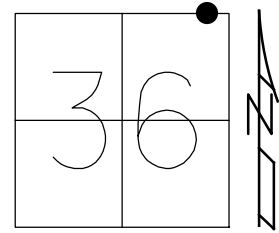

RECORD: P.I.
 STA. 52+65.24
 $\Delta = 3^\circ 18' \text{ LT}$
 $D = 2^\circ 00'$
 $R = 2864.93$
 $L = 165.00'$
 1957 PLANS
 FD IPIN
 3/11/53
 FD BRASS MON
 2/25/66, WD

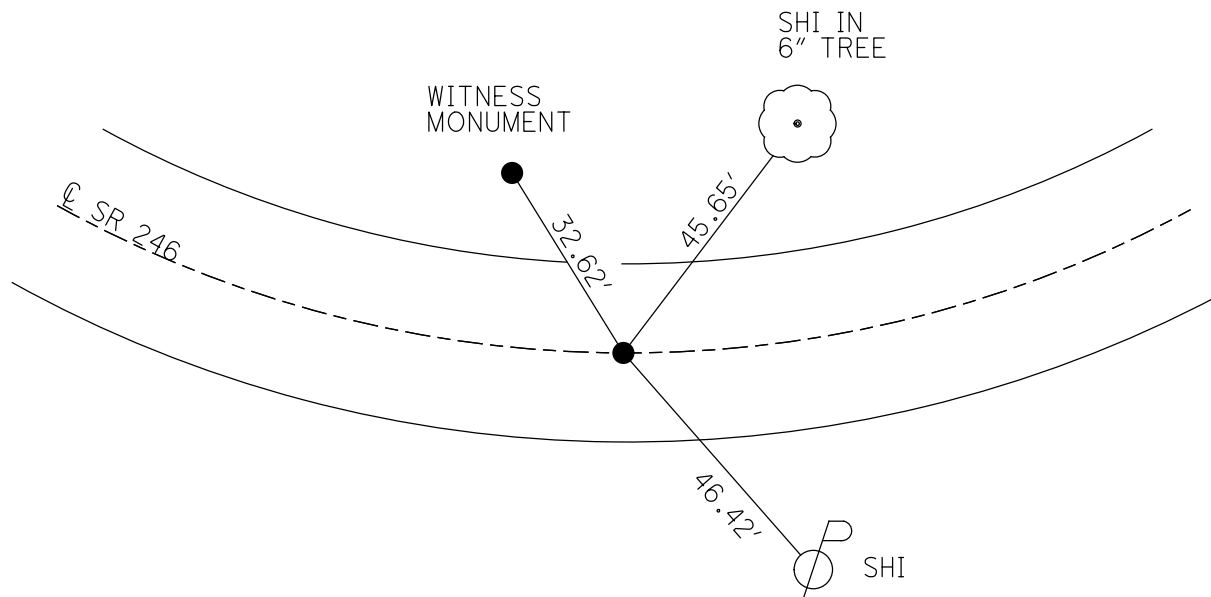

O.D.O.T. DISTRICT 2 SURVEY OFFICE (USE ONLY)

PERSONNEL

REFERENCE NO. 3

SHEET 3 OF 12

NOTES DENNO

DATE 2/25/66

ROUTE SR 246

H.C. CURTIS

WEATHER PARTLY CLOUDY

COUNTY LUCAS

R.C. GRANATA

TEMP. 26°

TOWNSHIP CITY OF TOLEDO

OMEY

SECTION 31

DWG BY NIESE PID _____

T 9 S R 7 E

TYPE MONUMENT BRASS MONUMENT

ON SURFACE - ~~BELOW~~ ON


OFFSET Q PAVEMENT _____ LT : RT

- TO - EDGE PAVEMENT


STATION: 64+42

HORZ. DATUM: _____ GEOID: _____

GRID: NORTHING: _____ EASTING: _____

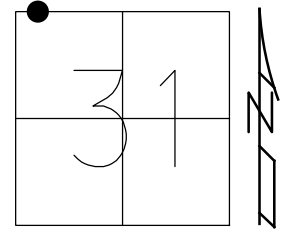

RECORD:
FD IPIN
REFERENCE #4
3/11/53
FD BRASS PLATE
MONUMENT
2/25/66, WD

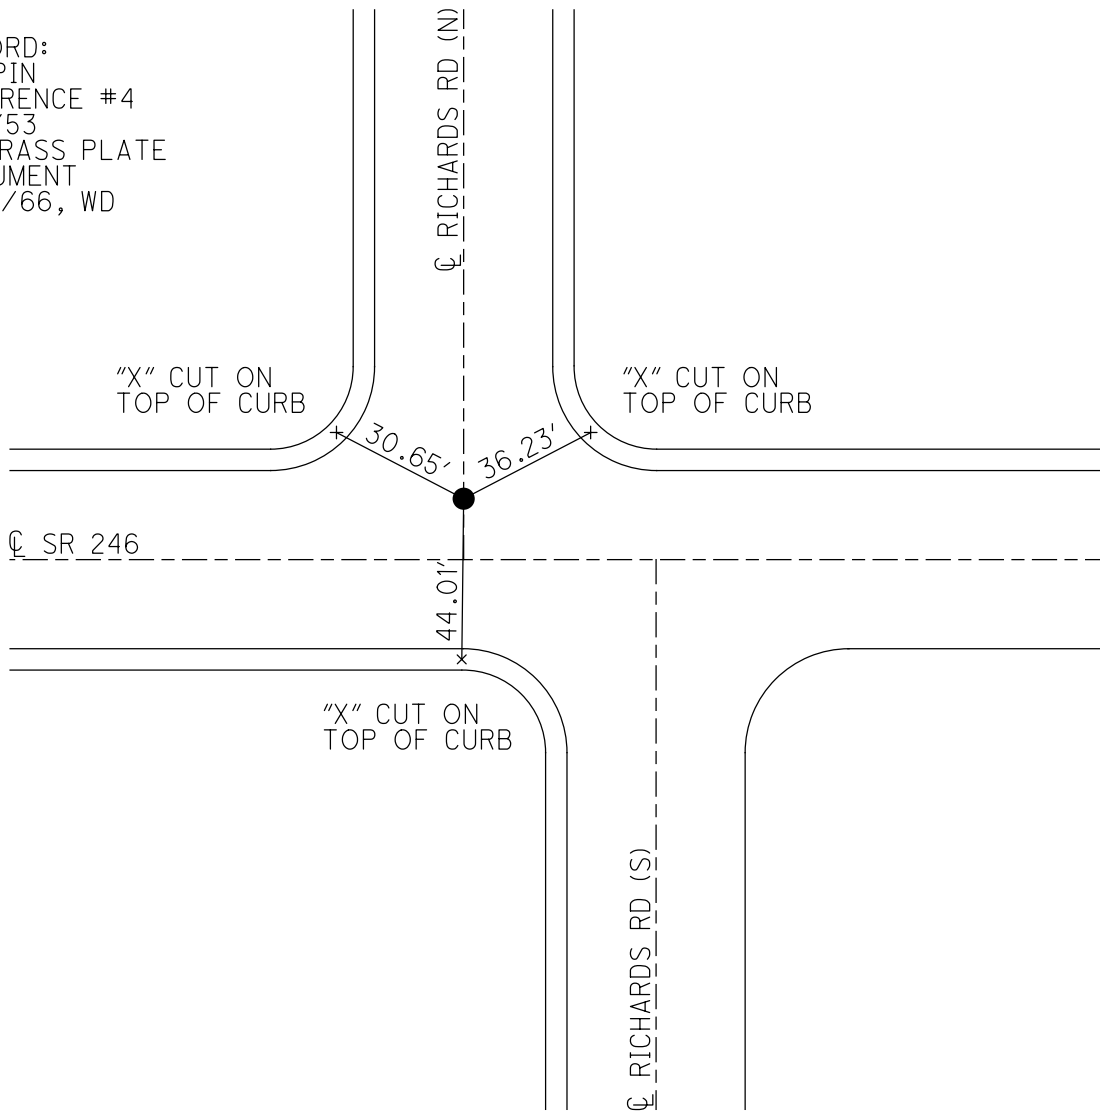

O.D.O.T. DISTRICT 2 SURVEY OFFICE (USE ONLY)

PERSONNEL _____

REFERENCE NO. 3 A

SHEET 4 OF 12

NOTES N/A

DATE 3/11/53

ROUTE SR 246

H.C. _____

WEATHER _____

COUNTY LUCAS

R.C. _____

TEMP. _____

TOWNSHIP CITY OF TOLEDO

DWG BY _____

PID _____

SECTION 31

T 9 S R 7 E

TYPE MONUMENT UNKNOWN

ON SURFACE - BELOW ON

OFFSET \odot PAVEMENT _____ LT : RT

_____ TO _____ EDGE PAVEMENT


STATION: 65+47

HORIZ.DATUM: _____


GEOID: _____

GRID: NORTHING: _____

EASTING: _____

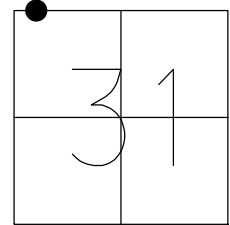

RECORD:
REFERENCE # 5
3/11/53

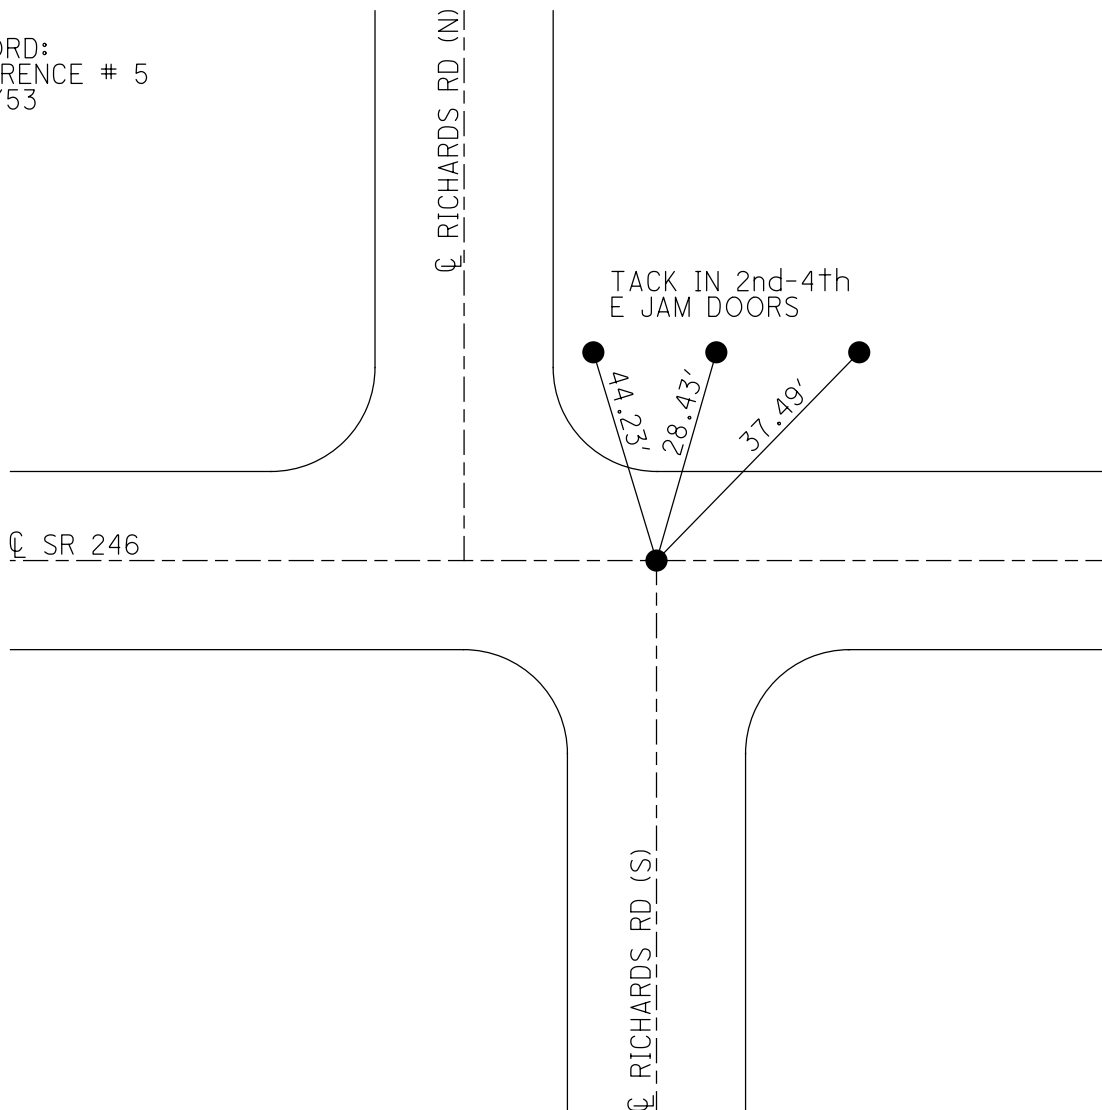

O.D.O.T. DISTRICT 2 SURVEY OFFICE (USE ONLY)

PERSONNEL

REFERENCE NO. 4

SHEET 5 OF 12

NOTES DENNO

DATE 2/25/66

ROUTE SR 246

H.C. CURTIS

WEATHER PARTLY CLOUDY

COUNTY LUCAS

R.C. GRANATA

TEMP. 26°

TOWNSHIP CITY OF TOLEDO

OMEY

SECTION 31

DWG BY NIESE PID _____

T 9 S R 7 E

TYPE MONUMENT BRASS MONUMENT

ON SURFACE - ~~BELOW~~ ON

OFFSET CL PAVEMENT _____ LT : RT

- TO - EDGE PAVEMENT


STATION: 79+20

HORIZ.DATUM: _____


GEOID: _____

GRID: NORTHING: _____

EASTING: _____

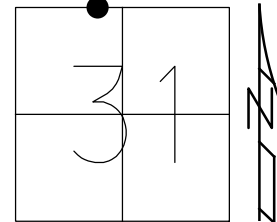

RECORD:
 FD IPIN
 REFERENCE #6
 3/11/53
 FD BRASS PLATE
 MONUMENT
 2/25/66, WD

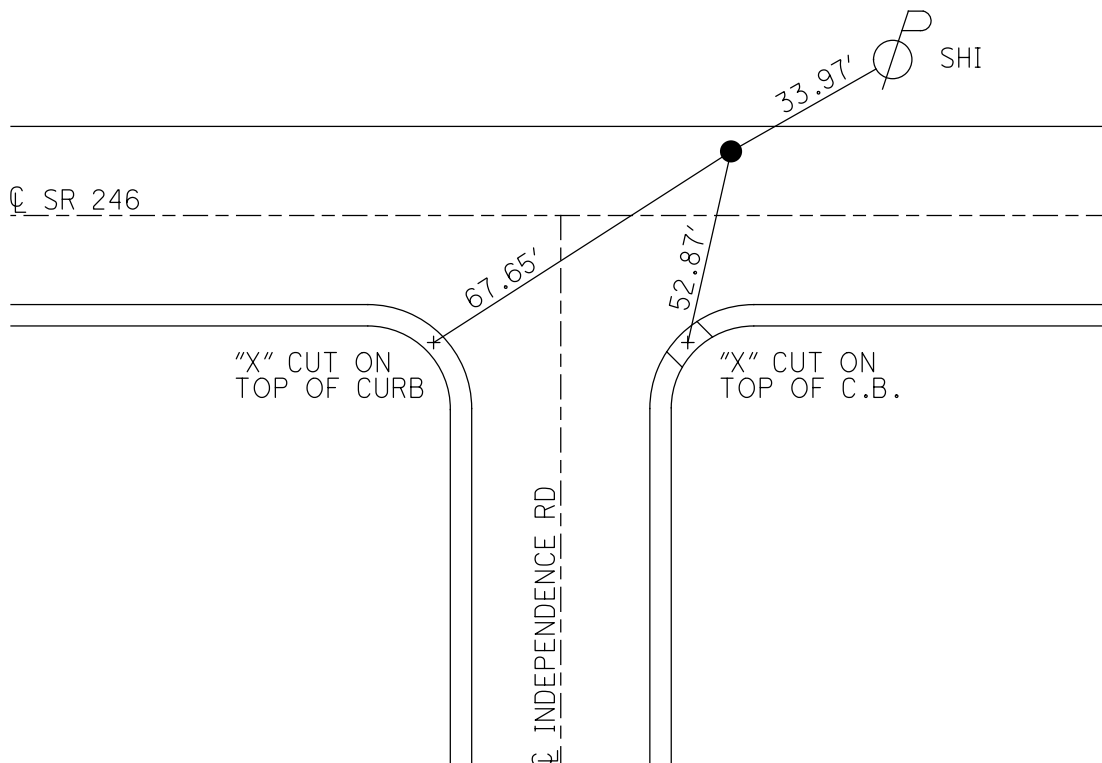

O.D.O.T. DISTRICT 2 SURVEY OFFICE (USE ONLY)

PERSONNEL _____ REFERENCE NO. 5 SHEET 6 OF 12

NOTES BURNSIDE DATE 12/18/79 ROUTE SR 246

H.C. BOWERS WEATHER CLEAR COUNTY LUCAS

R.C. CURTIS TEMP. 20° TOWNSHIP CITY OF TOLEDO

NEUSER/MICHALAK SECTION 31

DWG BY NIESE PID _____ T 9 S R 7 E

TYPE MONUMENT P.K. NAIL

ON SURFACE - ~~BELOW~~ ON _____


OFFSET \varnothing PAVEMENT _____ LT : RT

- TO - EDGE PAVEMENT


STATION: 105+60

HORIZ.DATUM: _____ GEOID: _____

GRID: NORTHING: _____ EASTING: _____

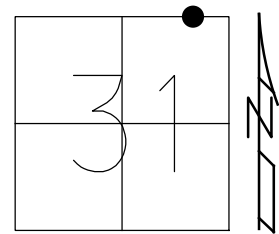

RECORD:
 STA. 105+84.93
 $\Delta = 0^\circ 03' \text{ LT}$
 1957 PLANS
 FD IPIN
 3/11/53
 FD MONBOX
 2/28/66, WD
 FD BRASS MON
 4" DOWN
 SET P.K. NAIL
 12/18/79, BURNSIDE

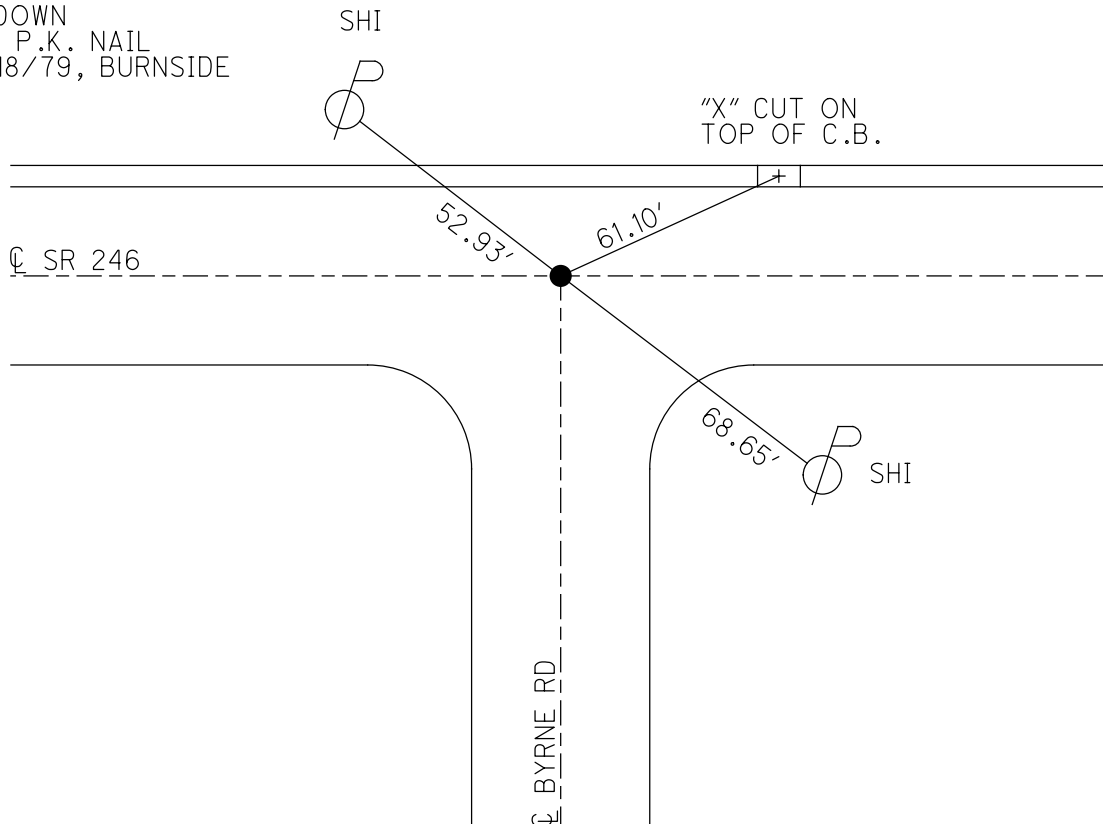

O.D.O.T. DISTRICT 2 SURVEY OFFICE (USE ONLY)

PERSONNEL _____

REFERENCE NO. 6

SHEET 7 OF 12

NOTES BURNSIDE DATE 12/18/79

ROUTE SR 246

H.C. BOWERS WEATHER CLEAR

COUNTY LUCAS

R.C. CURTIS TEMP. 20°

TOWNSHIP CITY OF TOLEDO

NEUSER/MICHALAK

SECTION 31

DWG BY NIESE PID _____

T 9 S R 7 E

TYPE MONUMENT BRASS MONUMENT

~~ON SURFACE~~ - BELOW 2"


OFFSET Q PAVEMENT _____ LT : RT

_____ TO _____ EDGE PAVEMENT


STATION: 117+21.6

HORZ. DATUM: _____ GEOID: _____

GRID: NORTHING: _____ EASTING: _____

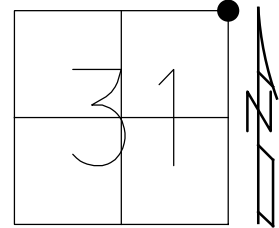

RECORD: P.I.
 STA 117+14.40
 $\Delta = 0^\circ 01' \text{ LT}$
 1957 PLANS
 FD MON
 3/11/53
 FD BRASS PLATE
 12/26/61, STONE
 2/28/66, WD
 FD BRASS MON.
 2"+ BELOW
 12/18/79, BURNSIDE

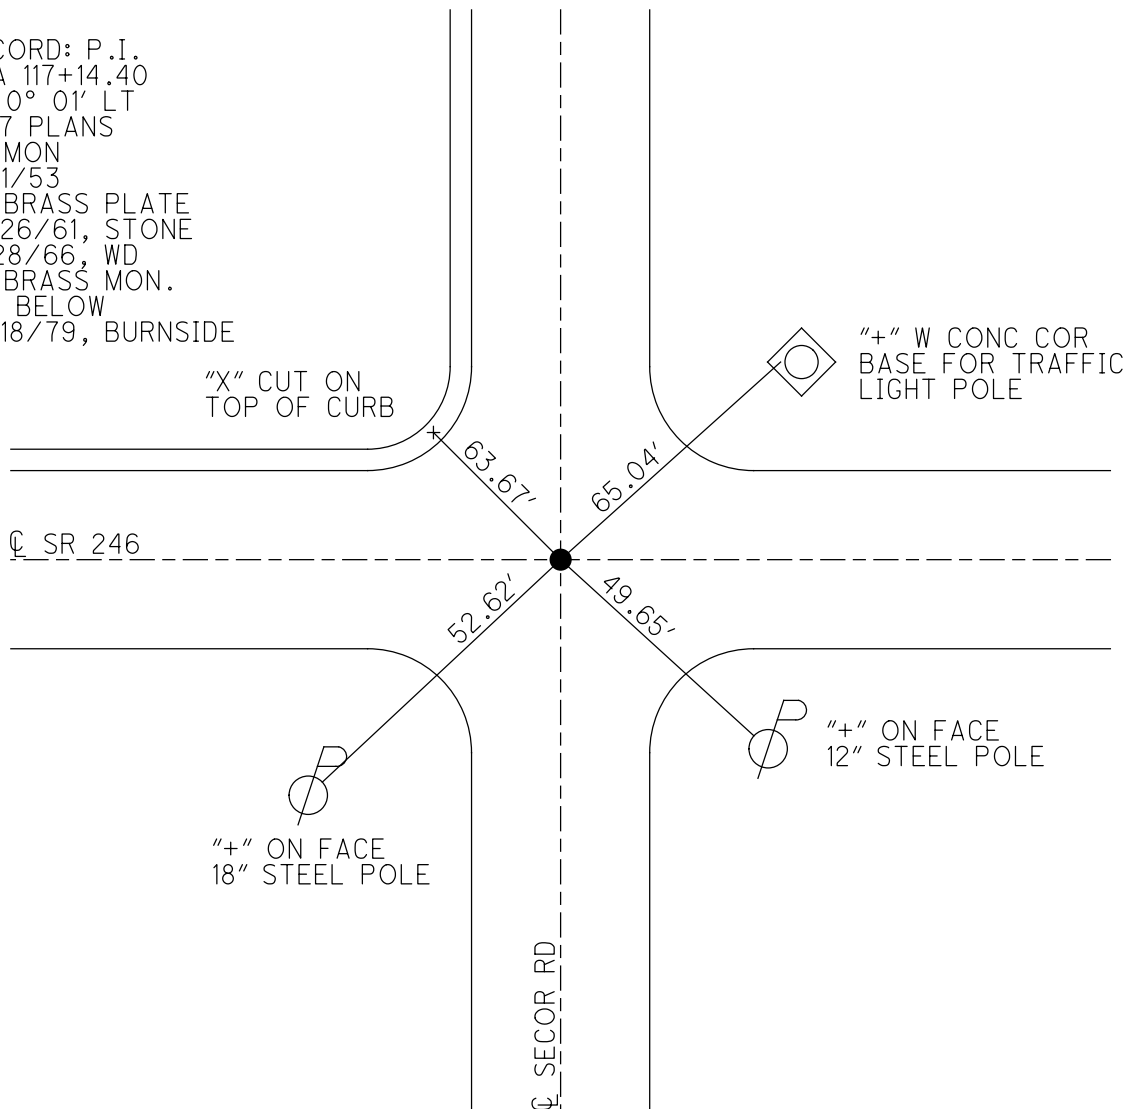

O.D.O.T. DISTRICT 2 SURVEY OFFICE (USE ONLY)

PERSONNEL _____

REFERENCE NO. 7

SHEET 8 OF 12

NOTES N/A

DATE 3/11/53

ROUTE SR 246

H.C. _____

WEATHER _____

COUNTY LUCAS

R.C. _____

TEMP. _____

TOWNSHIP CITY OF TOLEDO

DWG BY _____

PID _____

SECTION 32

T 9 S R 7 E

TYPE MONUMENT MONUMENT

ON SURFACE - BELOW - _____

OFFSET \varnothing PAVEMENT _____ LT : RT

_____ TO _____ EDGE PAVEMENT


STATION: 156+28.8

HORZ.DATUM: _____


GEOID: _____

GRID: NORTHING: _____

EASTING: _____

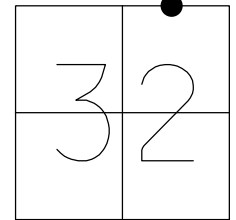

RECORD:
FD MONUMENT
3/11/53

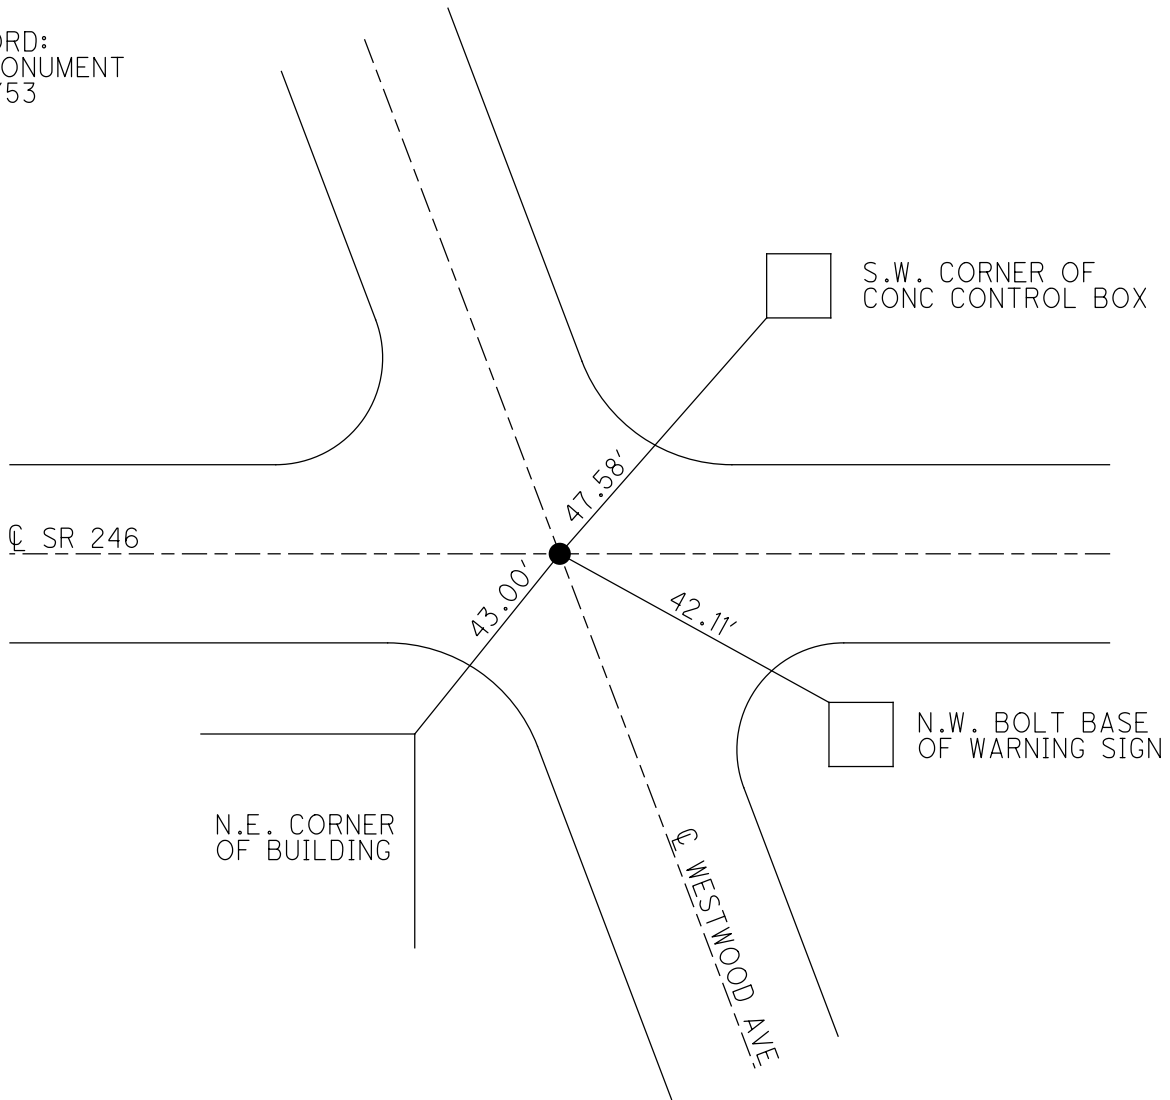

O.D.O.T. DISTRICT 2 SURVEY OFFICE (USE ONLY)

PERSONNEL _____

REFERENCE NO. 8

SHEET 9 OF 12

NOTES STONE

DATE 12/26/61

ROUTE SR 246

H.C. CURTIS

WEATHER COOL

COUNTY LUCAS

R.C. _____

TEMP. 28°

TOWNSHIP CITY OF TOLEDO

DWG BY NIESE PID _____

SECTION 32

T 9 S R 7 E

TYPE MONUMENT 1/2" IPIN

ON SURFACE - ~~BELOW~~ ON


OFFSET \varnothing PAVEMENT _____ LT : RT

TO EDGE PAVEMENT


STATION: 132+33.94

HORZ.DATUM: _____ GEOID: _____

GRID: NORTHING: _____ EASTING: _____

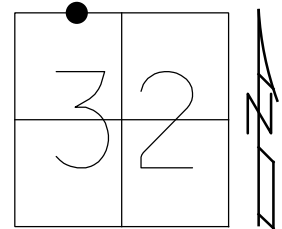

RECORD:
 $\Delta = 00^{\circ}01'00''$ RT
STA 132+33.94
FD 1/2" IPIN
12/26/61, STONE

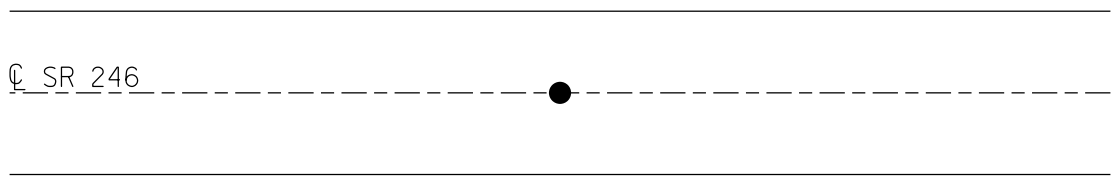

O.D.O.T. DISTRICT 2 SURVEY OFFICE (USE ONLY)

PERSONNEL

REFERENCE NO. 9

SHEET 10 OF 12

NOTES STONE

DATE 12/26/61

ROUTE SR 246

H.C. CURTIS

WEATHER COOL

COUNTY LUCAS

R.C. _____

TEMP. 28°

TOWNSHIP CITY OF TOLEDO

DWG BY NIESE PID _____

SECTION 32

T 9 S R 7 E

TYPE MONUMENT BRASS PLATE

ON SURFACE - ~~BELOW~~ ON


OFFSET Q PAVEMENT _____ LT : RT

_____ TO _____ EDGE PAVEMENT

STATION: 158+81.42

HORZ.DATUM: _____ GEOID: _____

GRID: NORTHING: _____ EASTING: _____

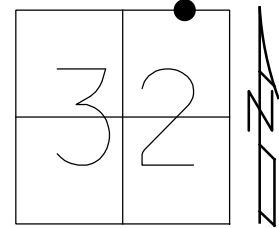

RECORD:
 $\Delta = 00^{\circ}04'00''$ RT
 STA 158+81.42
 FD BRASS PLATE
 12/26/61, STONE

Q SR 246 _____ ● _____

O.D.O.T. DISTRICT 2 SURVEY OFFICE (USE ONLY)

PERSONNEL _____

REFERENCE NO. 10

SHEET 11 OF 12

NOTES STONE

DATE 12/26/61

ROUTE SR 246

H.C. CURTIS

WEATHER COOL

COUNTY LUCAS

R.C. _____

TEMP. 28°

TOWNSHIP CITY OF TOLEDO

DWG BY NIESE PID _____

SECTION 33

T 9 S R 7 E

TYPE MONUMENT "+" IN CONC _____

ON SURFACE - ~~BELOW~~ ON _____


OFFSET \odot PAVEMENT _____ LT : RT

_____ TO _____ EDGE PAVEMENT


STATION: 184+80

HORZ.DATUM: _____ GEOID: _____

GRID: NORTHING: _____ EASTING: _____

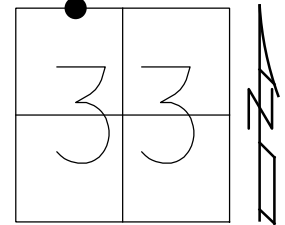

RECORD:
 $\Delta = 00^{\circ}04'00''$ LT
STA 184+46.71
SET "+" IN CONC
12/26/61, STONE

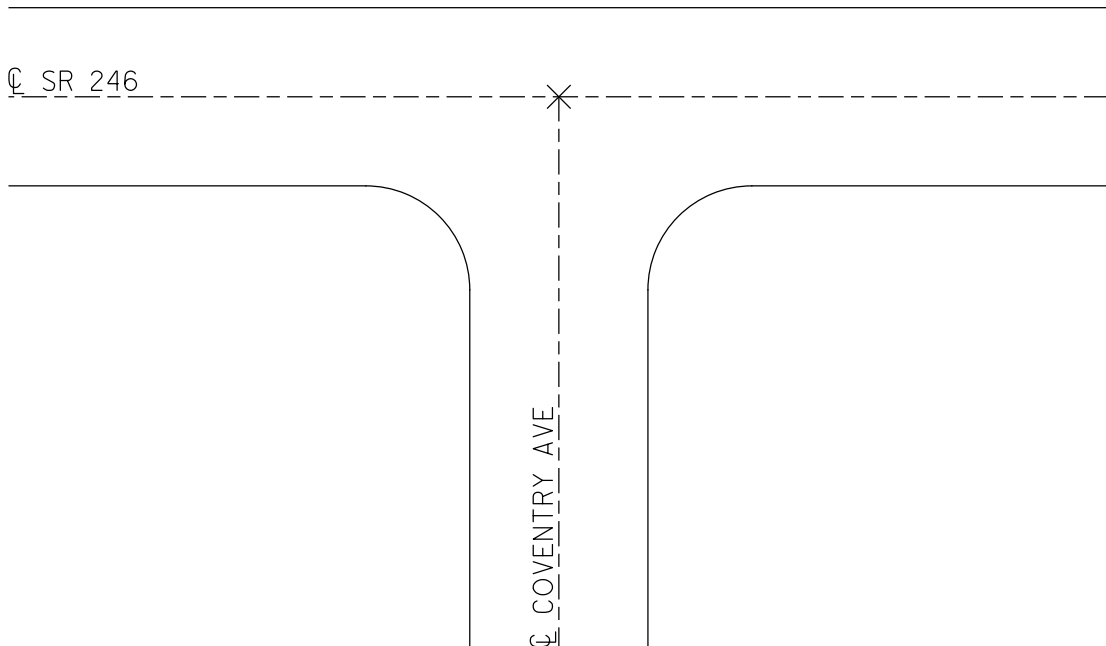

O.D.O.T. DISTRICT 2 SURVEY OFFICE (USE ONLY)

PERSONNEL _____

REFERENCE NO. 11

SHEET 12 OF 12

NOTES STONE DATE 12/26/61

ROUTE SR 246

H.C. CURTIS WEATHER COOL

COUNTY LUCAS

R.C. _____ TEMP. 28°

TOWNSHIP CITY OF TOLEDO

DWG BY NIESE PID _____

SECTION 33

T 9 S R 7 E

TYPE MONUMENT MONBOX

ON SURFACE - ~~BELOW~~ ON _____

OFFSET ☉ PAVEMENT _____ LT : RT

_____ TO _____ EDGE PAVEMENT


STATION: 209+09

HORZ. DATUM: _____

GEOID: _____

GRID: NORTHING: _____

EASTING: _____

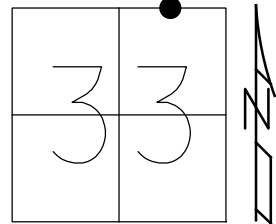

RECORD:
STA 208+98.20
FD MONBOX
12/26/61, STONE

