

O.D.O.T. DISTRICT 2 SURVEY OFFICE (USE ONLY)

PERSONNEL _____

REFERENCE NO. 1

SHEET 1 OF 12

NOTES DENNO DATE 2/25/66
 H.C. CURTIS WEATHER SUNNY
 R.C. GRANATA TEMP. 26°
OMEY

ROUTE SR 246
 COUNTY LUCAS
 TOWNSHIP CITY OF TOLEDO
 SECTION 35
 T 9 S R 6 E

DWG BY NIESE PID _____

TYPE MONUMENT IPIN IN MONUMENT

ON SURFACE - ~~BELOW~~ ON


OFFSET ☐ PAVEMENT _____ LT : RT

- TO - EDGE PAVEMENT


STATION: 0+00

HORZ. DATUM: _____ GEOID: _____

GRID: NORTHING: _____ EASTING: _____

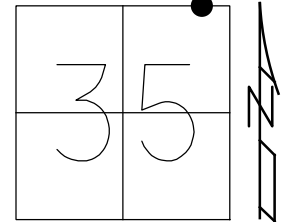

RECORD:
 FD SPIKE
 3/11/53
 FD IPIN IN
 MONUMENT
 2/25/66, WD

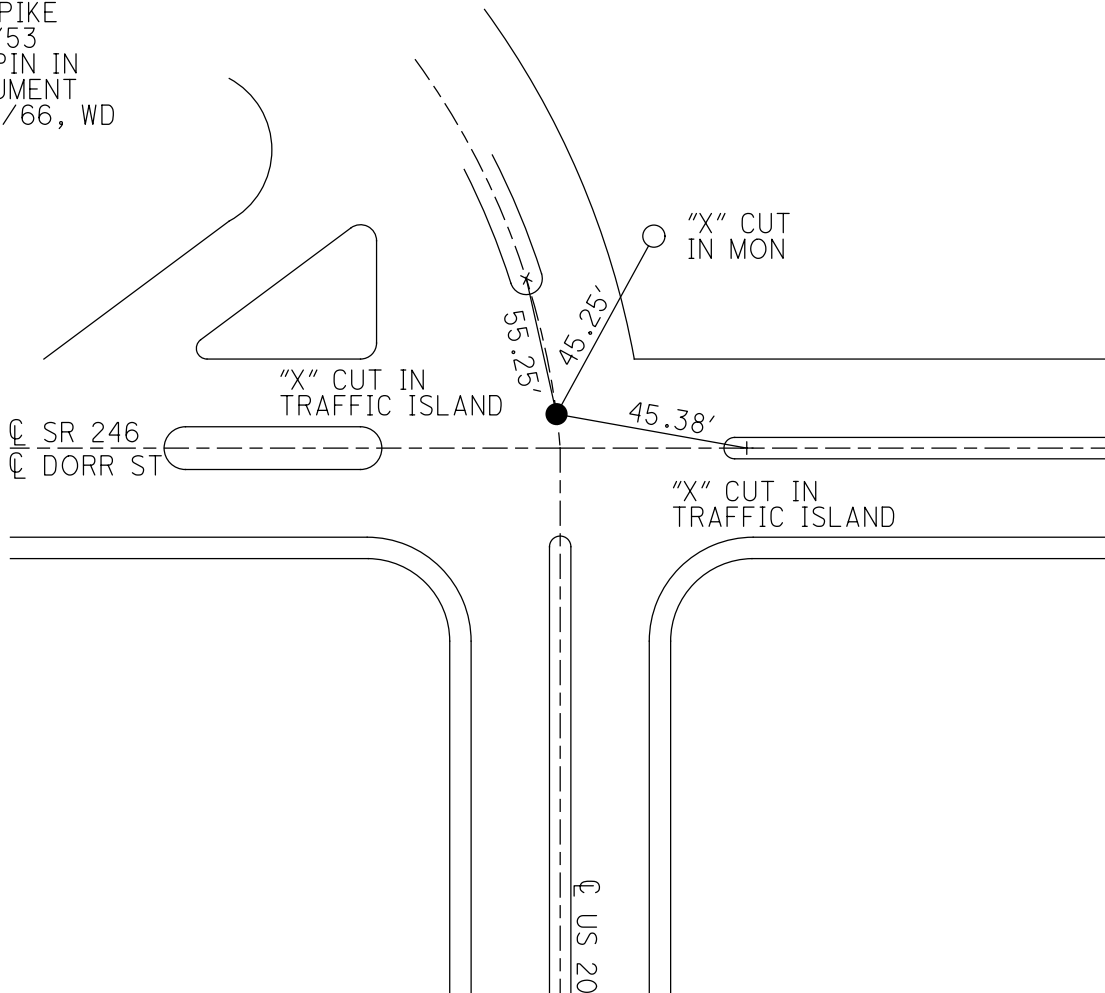

PERSONNEL	TITLE	PERSONNEL	TITLE	COUNTY	Lucas	DATE	Feb. 25, 1966
W. Dehno				S. R.	246	WEATHER	Sunny
D. Curtis				SEC.		TEMP.	26°
D. Granata				DESCRIPTION <u>S.R. 246 (Dorr St.) - Ref. Mon. & Control Points</u>			
E. Omev				JOB NO. _____			

