

O.D.O.T. DISTRICT 2 SURVEY OFFICE (USE ONLY)

PERSONNEL _____

REFERENCE NO. 3 A

SHEET 4 OF 12

NOTES N/A

DATE 3/11/53

ROUTE SR 246

H.C. _____

WEATHER _____

COUNTY LUCAS

R.C. _____

TEMP. _____

TOWNSHIP CITY OF TOLEDO

DWG BY _____

PID _____

SECTION 31

T 9 S R 7 E

TYPE MONUMENT UNKNOWN

ON SURFACE - BELOW ON

OFFSET \odot PAVEMENT _____ LT : RT

_____ TO _____ EDGE PAVEMENT


STATION: 65+47

HORIZ.DATUM: _____


GEOID: _____

GRID: NORTHING: _____

EASTING: _____

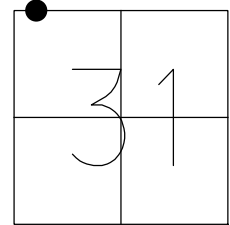

RECORD:
REFERENCE # 5
3/11/53

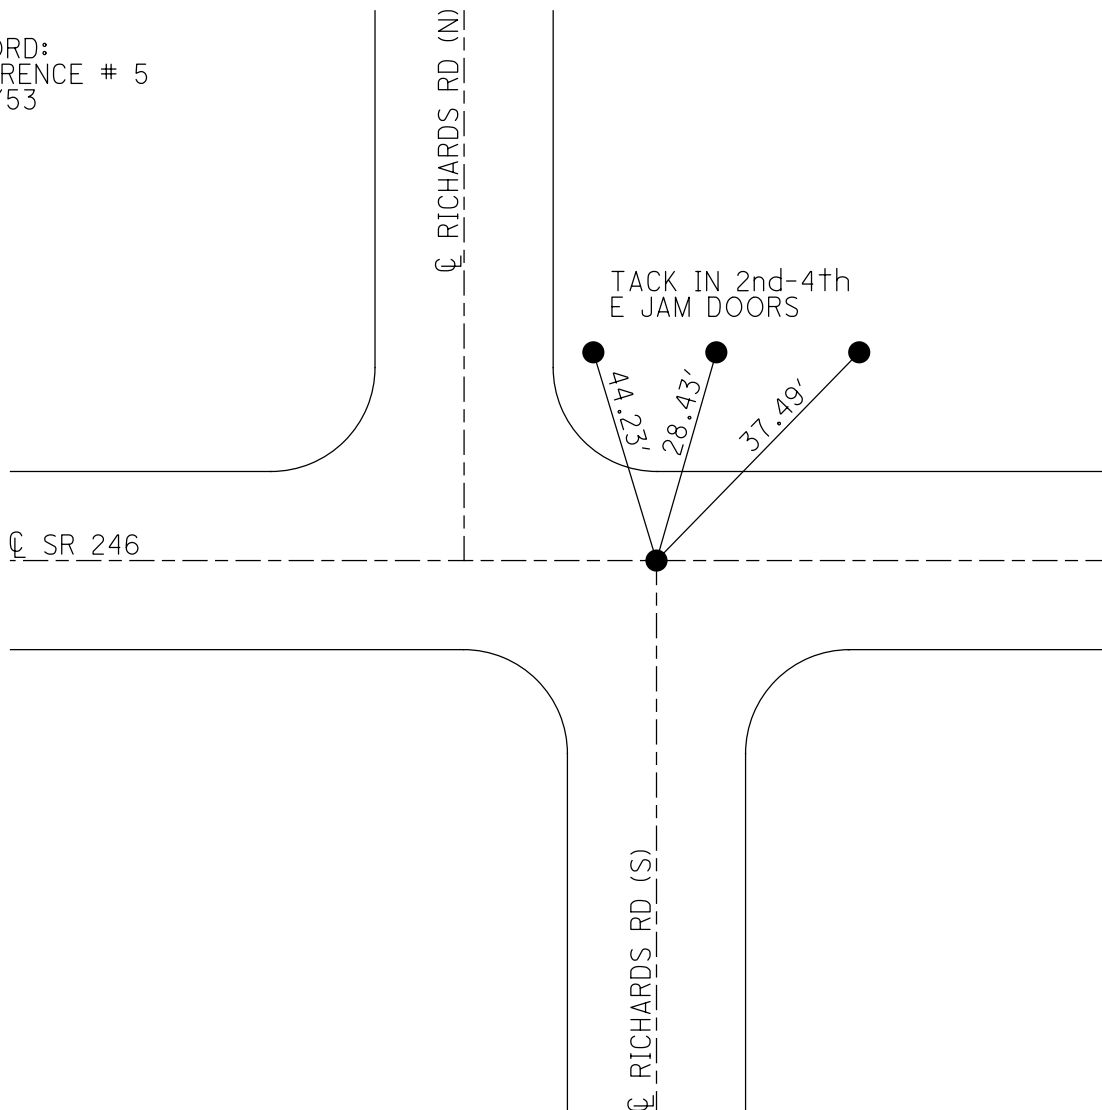

PERSONNEL	TITLE	PERSONNEL	TITLE	COUNTY	DATE	WEATHER	TEMP
W. Denno				Lucas	Feb. 25, 1966	Partly Cloudy	26°
D. Curtis				S. R. 246			
D. Granata							
E. Omev							

DESCRIPTION: S.R. 246 (Dorr St.) - Ref. Mon. & Control Points

