

O.D.O.T. DISTRICT 2 SURVEY OFFICE (USE ONLY)

PERSONNEL _____

REFERENCE NO. 8

SHEET 9 OF 12

NOTES STONE

DATE 12/26/61

ROUTE SR 246

H.C. CURTIS

WEATHER COOL

COUNTY LUCAS

R.C. _____

TEMP. 28°

TOWNSHIP CITY OF TOLEDO

DWG BY NIESE PID _____

SECTION 32

T 9 S R 7 E

TYPE MONUMENT 1/2" IPIN

ON SURFACE - ~~BELOW~~ ON

OFFSET \varnothing PAVEMENT _____ LT : RT

_____ TO _____ EDGE PAVEMENT


STATION: 132+33.94

HORZ.DATUM: _____


GEOID: _____

GRID: NORTHING: _____

EASTING: _____

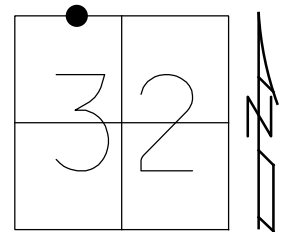

RECORD:
 $\Delta = 00^{\circ}01'00''$ RT
STA 132+33.94
FD 1/2" IPIN
12/26/61, STONE

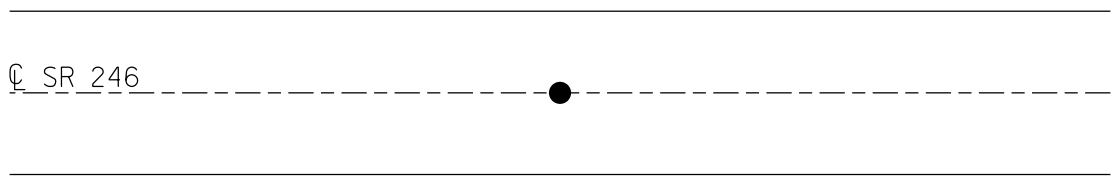

| PERSONNEL | TITLE | PERSONNEL | TITLE | COUNTY | DATE |
|-------------|--------------------|-------------|-------|---------------------|--------------|
| Stone | | | | Lucas | 26 Dec. 61 |
| | | | | S. R. # 276 | WEATHER Cool |
| Crew | | | | SEC. Secor to Upton | TEMP. 28° |
| DESCRIPTION | Dorr St. Alignment | | | JOB NO. | |
| | LEFT | CENTER LINE | RIGHT | | |

