

O.D.O.T. DISTRICT 2 SURVEY OFFICE (USE ONLY)

PERSONNEL _____

REFERENCE NO. 11

SHEET 12 OF 12

NOTES STONE DATE 12/26/61

ROUTE SR 246

H.C. CURTIS WEATHER COOL

COUNTY LUCAS

R.C. _____ TEMP. 28°

TOWNSHIP CITY OF TOLEDO

DWG BY NIESE PID _____

SECTION 33

T 9 S R 7 E

TYPE MONUMENT MONBOX

ON SURFACE - ~~BELOW~~ ON _____

OFFSET ☉ PAVEMENT _____ LT : RT

_____ TO _____ EDGE PAVEMENT


STATION: 209+09

HORZ. DATUM: _____


GEOID: _____

GRID: NORTHING: _____

EASTING: _____

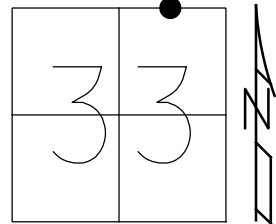

RECORD:
STA 208+98.20
FD MONBOX
12/26/61, STONE

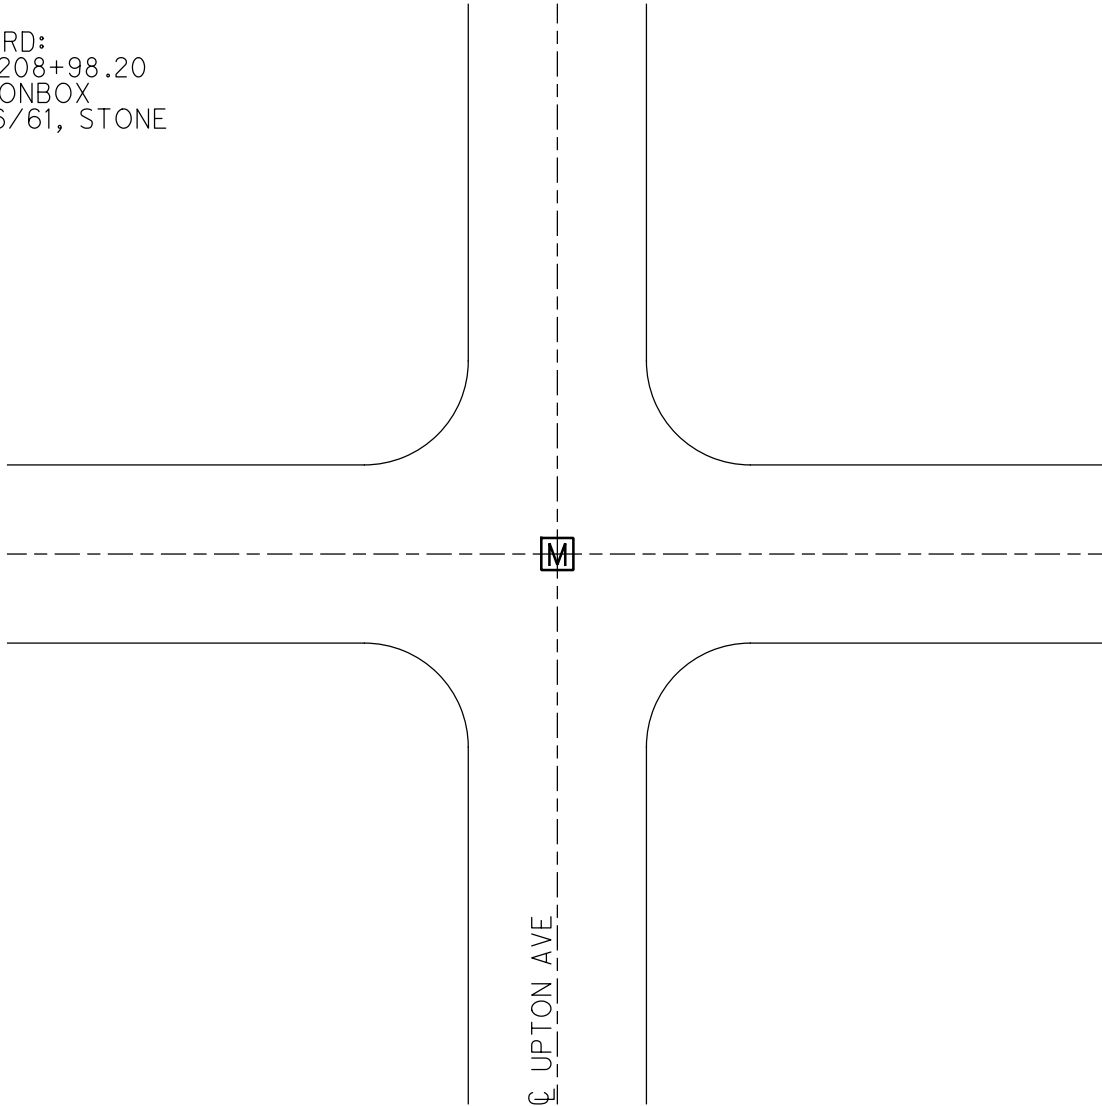

PERSONNEL	TITLE	PERSONNEL	TITLE	COUNTY	DATE
Stone				Lucas	26 Dec. 61
				S. R. # 276	WEATHER Cool
Crew				SEC. Secor to Upton	TEMP. 28°
DESCRIPTION	Dorr St. Alignment			JOB NO.	
	LEFT	CENTER LINE	RIGHT		

