

O.D.O.T. DISTRICT 2 SURVEY OFFICE (USE ONLY)

PERSONNEL

REFERENCE NO. 1

SHEET 1 OF 12

NOTES STONE

DATE 11/29/73

ROUTE IR 280

H.C. MICHALAK

WEATHER COLD

COUNTY LUCAS

R.C. DENNO

TEMP. 37°

TOWNSHIP OREGON

CURTIS

SECTION 9

DWG BY RHOADES PID 02655 (0)

T 10 S R 8 E

TYPE MONUMENT CMON

ON SURFACE - ~~BELOW~~ ON

OFFSET Q PAVEMENT ON LT : RT

- TO - EDGE PAVEMENT


STATION: 77+27.43

HORZ.DATUM: \_\_\_\_\_

GEOID: \_\_\_\_\_

GRID: NORTHING: \_\_\_\_\_

EASTING: \_\_\_\_\_

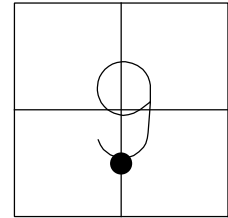

RECORD: T.S.  
STA. 77+27.43  
11/29/73, IRS

Q S.B. I-280

Q N.B. I-280



PERSONNEL TITLE PERSONNEL TITLE

COUNTY Lucas DATE 29 Nov. 73

Stone

S. R. I-280

WEATHER Cold

Michalak

SEC. 0.00

TEMP 37°


Denno

Lurtis

DESCRIPTION

References to Central Points  
LEFT CENTER LINE RIGHT

JOB NO. 02655(a)

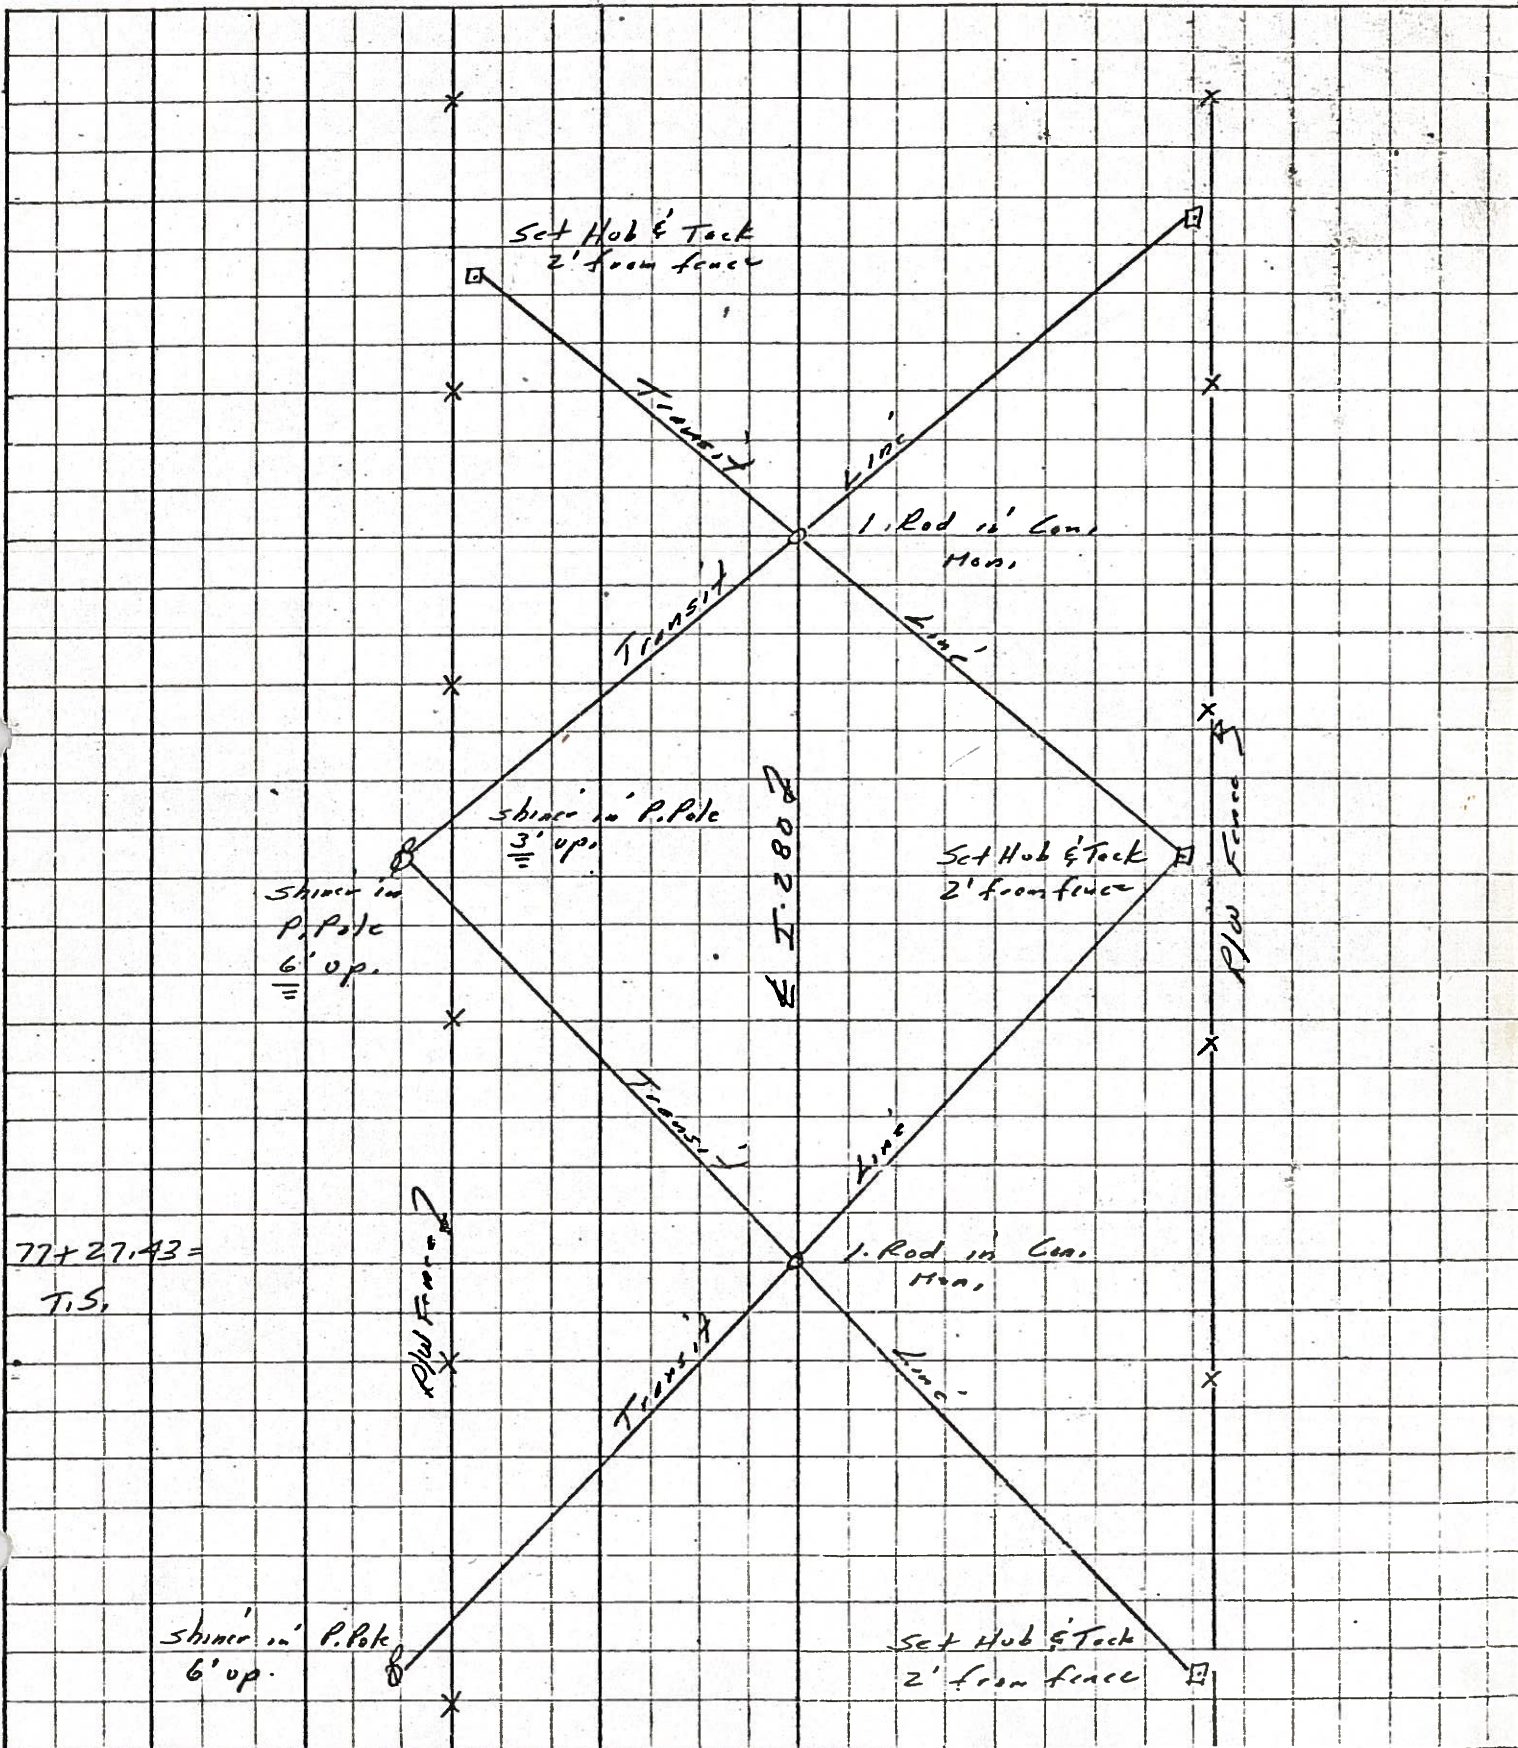

77 + 27.43 =  
T.S.

Shiner in P. Pole  
6' up.

Set Hub & Tack  
2' from fence

Plow Fence

Plow Fence

I-280

Set Hub & Tack  
2' from fence

Set Hub & Tack  
2' from fence

1. Rod in Cen.  
Mon.

1. Rod in Cen.  
Mon.

Shiner in P. Pole  
3' up.

Shiner in P. Pole  
6' up.

Transit

Line

Transit

Line

Transit

Line

Transit

Line