

O.D.O.T. DISTRICT 2 SURVEY OFFICE (USE ONLY)

PERSONNEL

REFERENCE NO. 2

SHEET 2 OF 12

NOTES STONE

DATE 11/29/73

ROUTE IR 280

H.C. MICHALAK

WEATHER COLD

COUNTY LUCAS

R.C. DENNO
CURTIS

TEMP. 37°

TOWNSHIP OREGON

DWG BY RHOADES PID 02655 (0)

SECTION 9

T 10 S R 8 E

TYPE MONUMENT CMON

ON SURFACE - ~~BELOW~~ ON

OFFSET \varnothing PAVEMENT ON LT : RT

- TO - EDGE PAVEMENT


STATION: 79+27.43

HORZ.DATUM: _____

GEOID: _____

GRID: NORTHING: _____

EASTING: _____

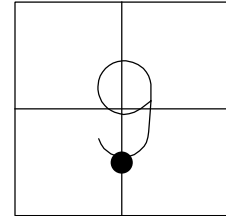

RECORD: S.C.
STA. 79+27.43
11/29/73, IRS

\varnothing S.B. I-280

\varnothing N.B. I-280



PERSONNEL TITLE PERSONNEL TITLE

COUNTY Lucas DATE 29 Nov. 73

Stone

S. R. I-280

WEATHER Cold

Michalak

SEC. 0.00

TEMP 37°


Denno

Lurtis

DESCRIPTION

References to Central Points
LEFT CENTER LINE RIGHT

JOB NO. 02655(a)

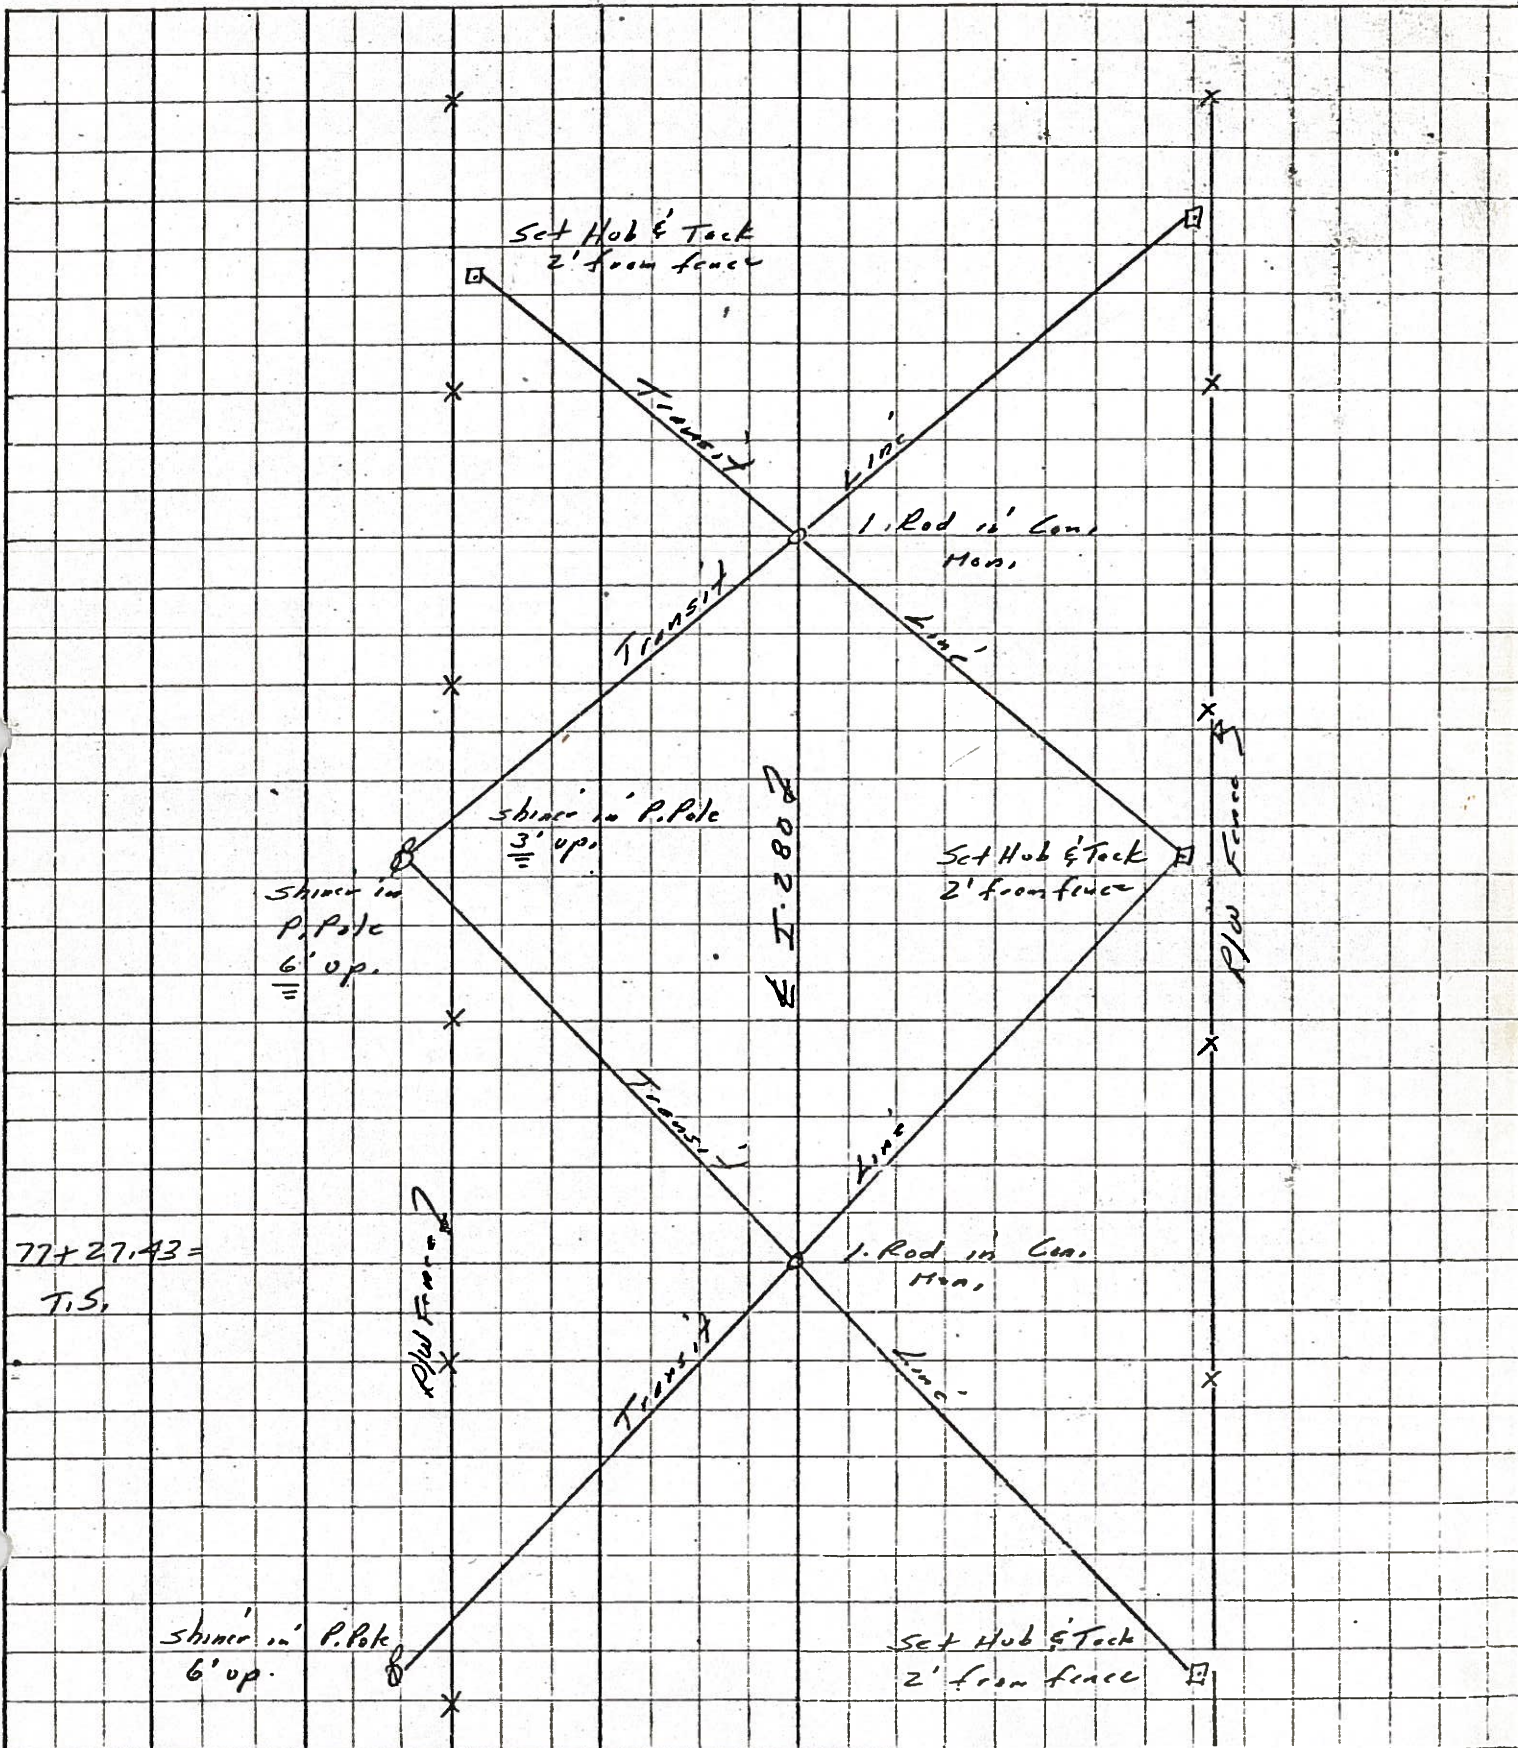

77 + 27.43 =
T.S.

Shiner in P. Pole
6' up.

Set Hub & Tack
2' from fence