

O.D.O.T. DISTRICT 2 SURVEY OFFICE (USE ONLY)

PERSONNEL

REFERENCE NO. 3

SHEET 3 OF 12

NOTES STONE

DATE 11/29/73

ROUTE IR 280

H.C. MICHALAK

WEATHER COLD

COUNTY LUCAS

R.C. DENNO

TEMP. 37°

TOWNSHIP OREGON

CURTIS

SECTION 9

DWG BY RHOADES PID 02655 (0)

T 10 S R 8 E

TYPE MONUMENT CMON

ON SURFACE - ~~BELOW~~ ON


OFFSET \odot PAVEMENT ON LT : RT

- TO - EDGE PAVEMENT


STATION: 99+07.43

HORZ.DATUM: _____ GEOID: _____

GRID: NORTHING: _____ EASTING: _____

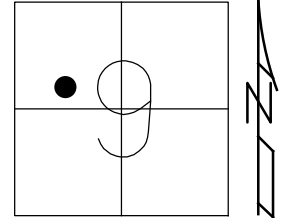

RECORD: C.S.
STA. 99+07.43
11/29/73, IRS

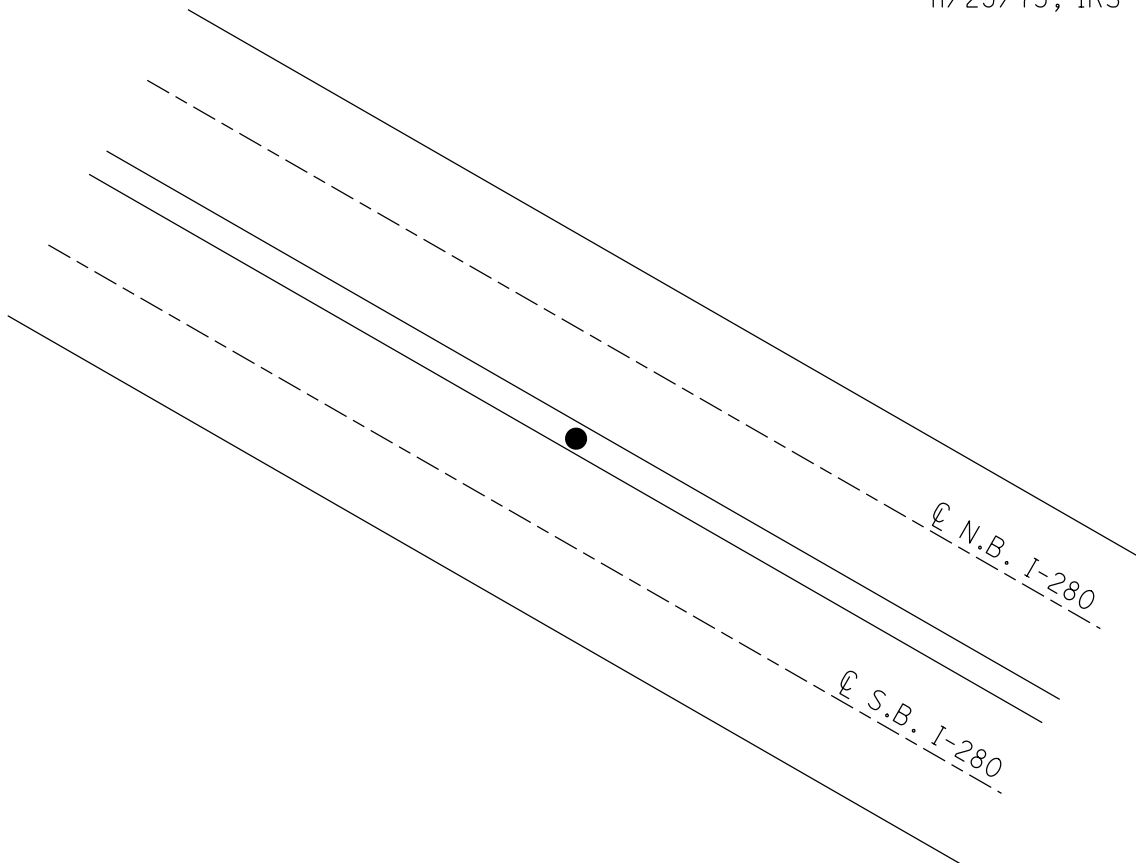

PERSONNEL	TITLE	PERSONNEL	TITLE	COUNTY	DATE
Stone				Lucas	29 Nov. 73
Deyno				S. R. I-280	WEATHER Cold
Curtis				SEC. 0.00	TEMP. 37°
Michalak					

DESCRIPTION References to Control Points JOB NO. 02655(2)

