

O.D.O.T. DISTRICT 2 SURVEY OFFICE (USE ONLY)

PERSONNEL

REFERENCE NO. 4

SHEET 4 OF 12

NOTES STONE

DATE 11/29/73

ROUTE IR 280

H.C. MICHALAK

WEATHER COLD

COUNTY LUCAS

R.C. DENNO  
CURTIS

TEMP. 37°

TOWNSHIP OREGON

DWG BY RHOADES PID 02655 (0)

SECTION 9

T 10 S R 8 E

TYPE MONUMENT CMON

ON SURFACE - ~~BELOW~~ ON

OFFSET  $\odot$  PAVEMENT ON LT : RT  
- TO - EDGE PAVEMENT


STATION: 101+07.43

HORZ.DATUM: \_\_\_\_\_


GEOID: \_\_\_\_\_

GRID: NORTHING: \_\_\_\_\_

EASTING: \_\_\_\_\_

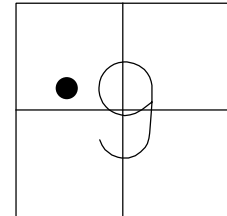

RECORD: S.T.  
STA. 101+07.43  
11/29/73, IRS

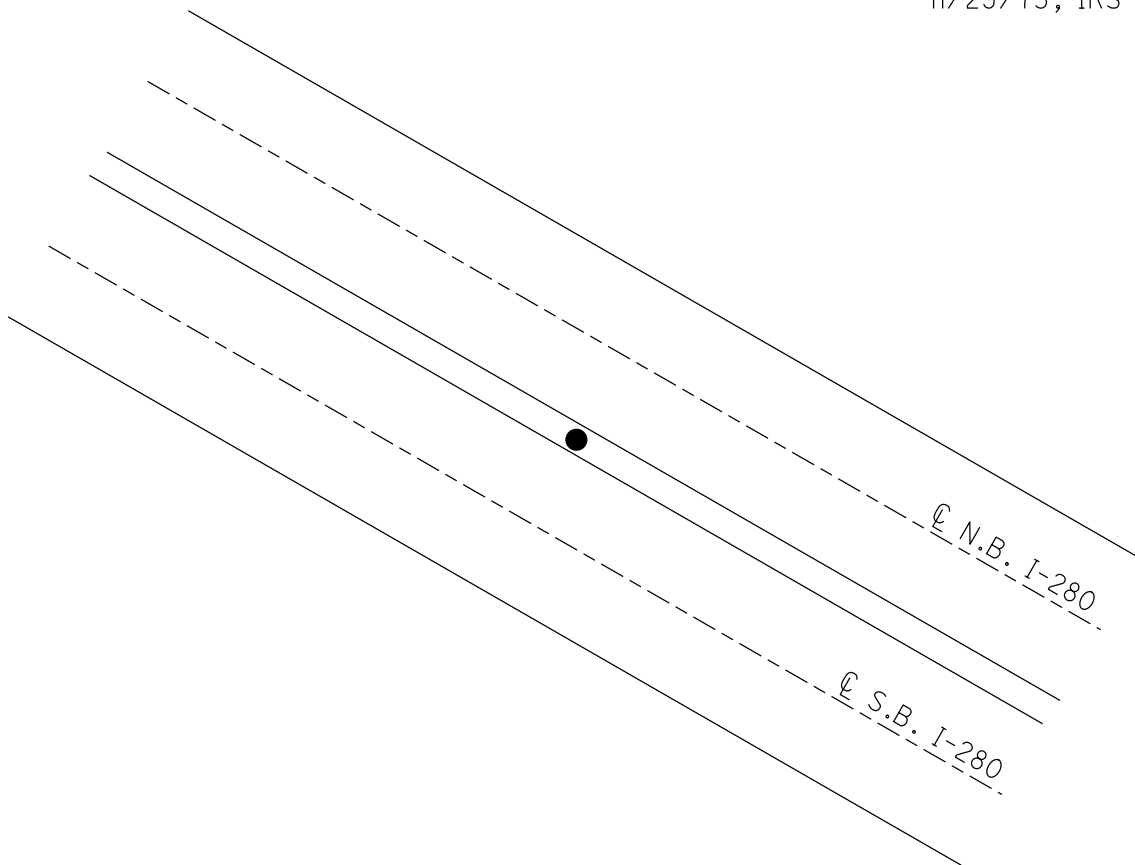

PERSONNEL	TITLE	PERSONNEL	TITLE	COUNTY	DATE
Stone				Lucas	29 Nov. 73
Deyno				S. R. I-280	WEATHER Cold
Curtis				SEC. 0.00	TEMP. 37°
Michalak					

DESCRIPTION *References to Control Points* JOB NO. 02655(2)

