

O.D.O.T. DISTRICT 2 SURVEY OFFICE (USE ONLY)

PERSONNEL

REFERENCE NO. 6

SHEET 6 OF 12

NOTES STONE

DATE 11/29/73

ROUTE IR 280

H.C. MICHALAK

WEATHER COLD

COUNTY LUCAS

R.C. DENNO

TEMP. 37°

TOWNSHIP OREGON

CURTIS

SECTION 8

DWG BY RHOADES PID 02655 (0)

T 10 S R 8 E

TYPE MONUMENT CMON

ON SURFACE - ~~BELOW~~ ON

OFFSET ϕ PAVEMENT ON LT : RT

- TO - EDGE PAVEMENT


STATION: 129+59.75

HORZ. DATUM: _____


GEOID: _____

GRID: NORTHING: _____

EASTING: _____

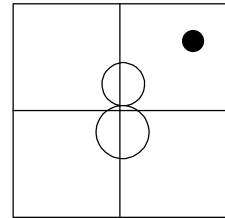

RECORD: P.T.
STA. 129+59.75
11/29/73, IRS

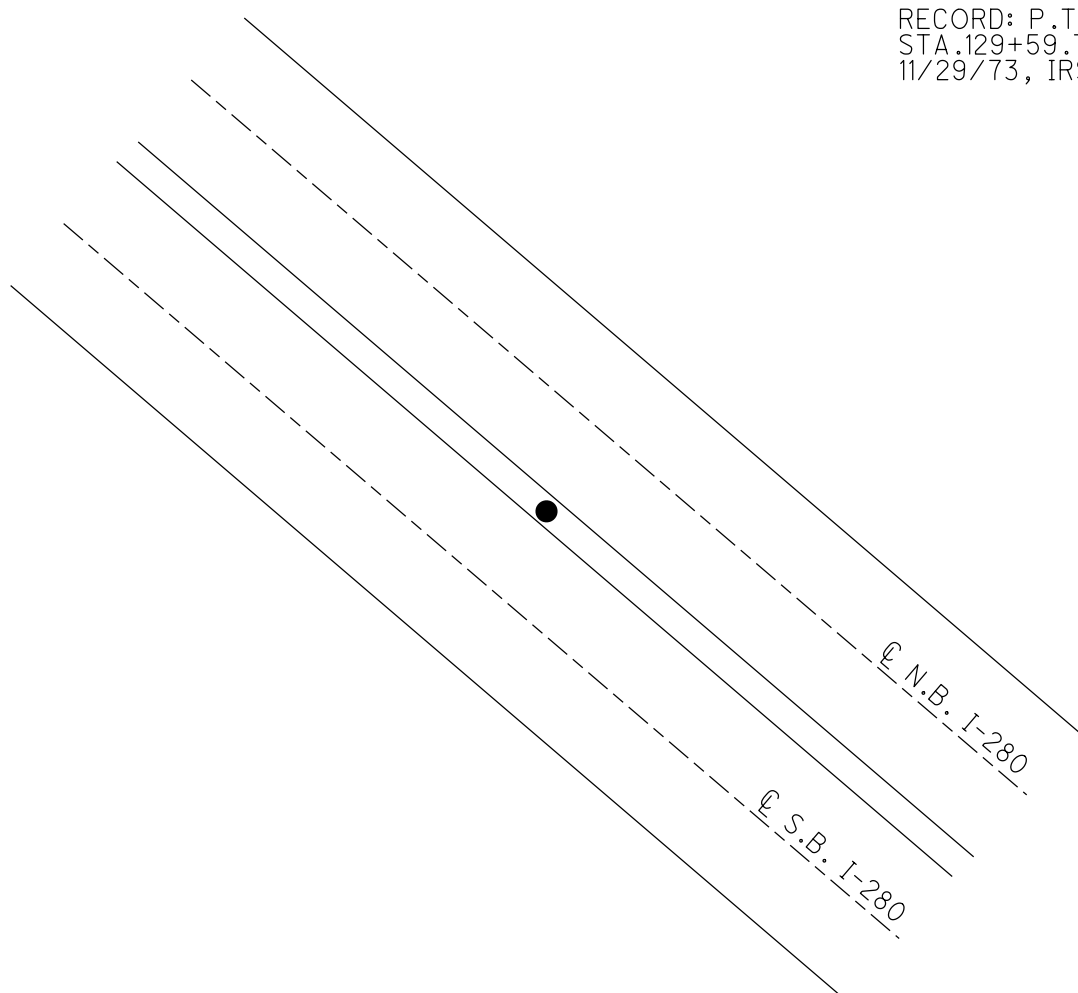

PERSONNEL TITLE PERSONNEL TITLE

COUNTY Lucas

DATE 29 Nov. 73

Stone

Rane

Curtis

Nicholak

S. R. I-280

WEATHER Cold


SEC. 0.00

TEMP. 37°

DESCRIPTION References to Control Points

JOB NO. 02655(6)

LEFT CENTER LINE RIGHT

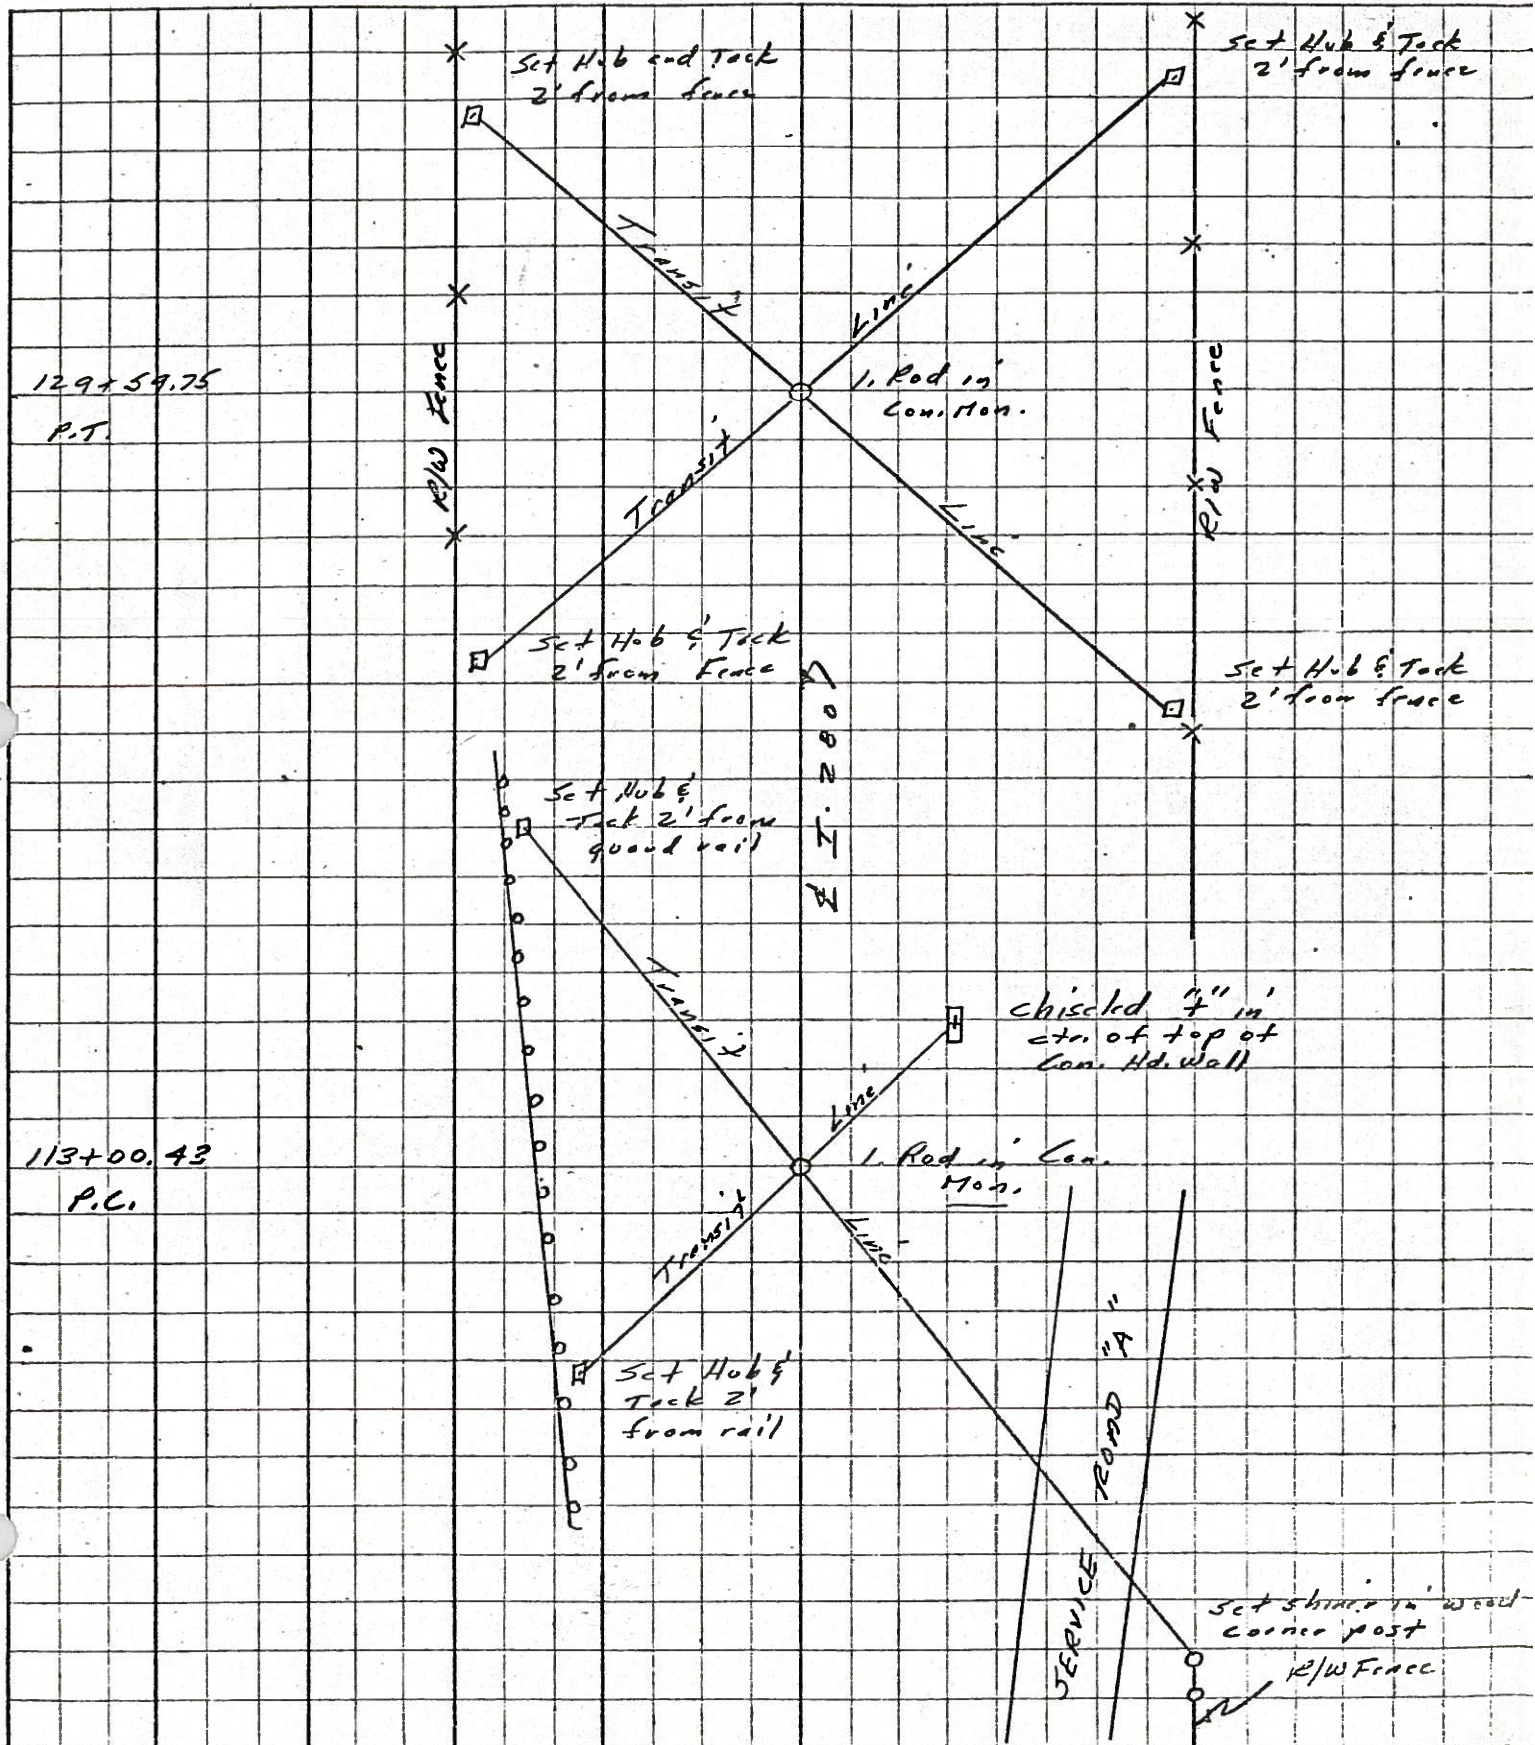

129+59.75
P.T.

113+00.43
P.C.

chiseled 4" in
ctr. of top of
Con. Hd. Wall

SERVICE ROAD "A"

Set 5" dia. x 1/2" wood
corner post
R/W Fence