

O.D.O.T. DISTRICT 2 SURVEY OFFICE (USE ONLY)

PERSONNEL

REFERENCE NO. 7

SHEET 7 OF 12

NOTES STONE
H.C. MICHALAK
R.C. DENNO
CURTIS

DATE 11/30/73
WEATHER COLD
TEMP. 32°

ROUTE IR 280
COUNTY LUCAS
TOWNSHIP OREGON
SECTION 5
T 10 S R 8 E

DWG BY RHOADES PID 02655 (0)

TYPE MONUMENT CMON

ON SURFACE - ~~BELOW~~ ON

OFFSET ☉ PAVEMENT ON LT : RT

- TO - EDGE PAVEMENT


STATION: 148+91.21

HORIZ.DATUM: _____


GEOID: _____

GRID: NORTHING: _____

EASTING: _____

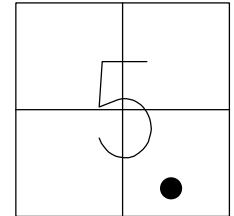

RECORD: P.C.
STA.148+91.31
11/30/73, IRS

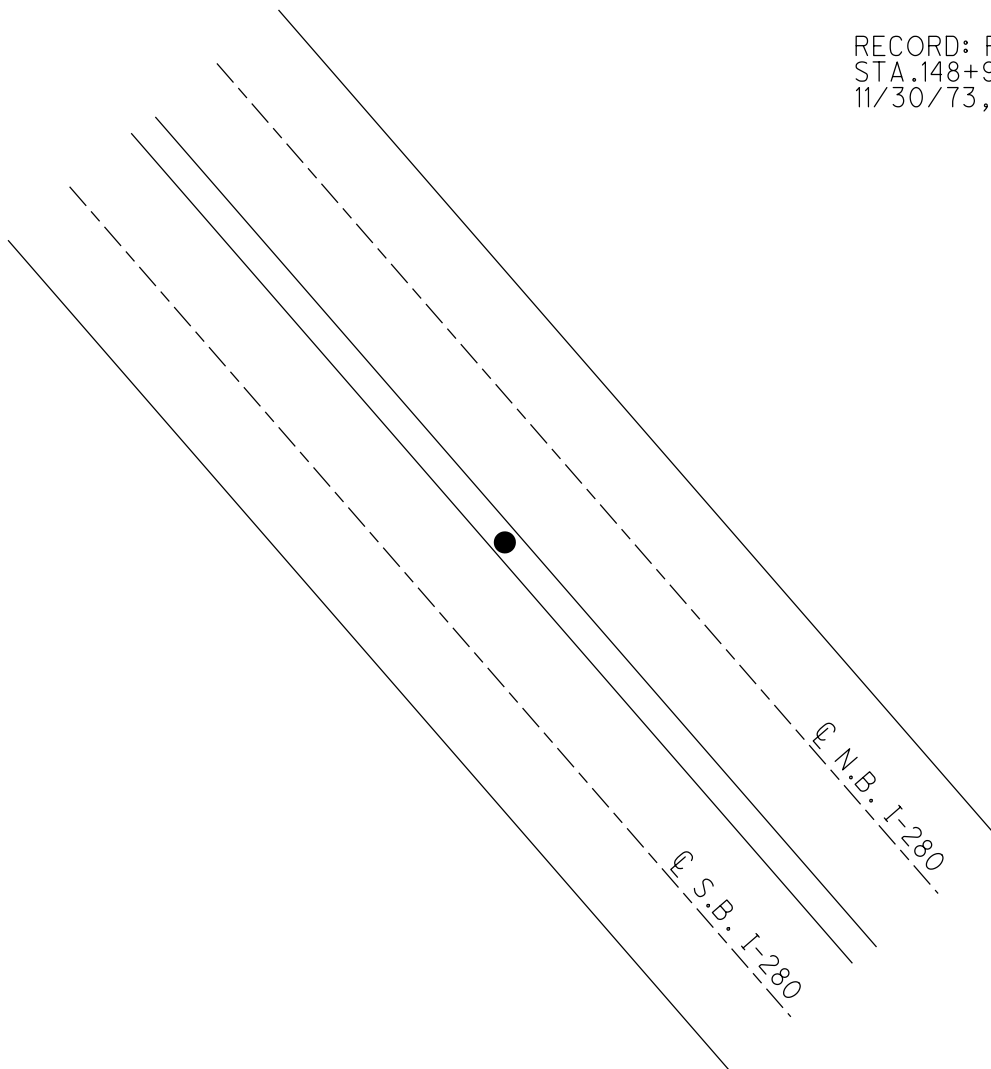

Personnel

Description

SHEET NO. _____

SP

PROJ #211

LUCAS CO.

Date 5/23/79

CB

I-280


Job No. _____

B.R.

REF. TO P.I. 152+25.39 &

Temp. _____

Stakes _____

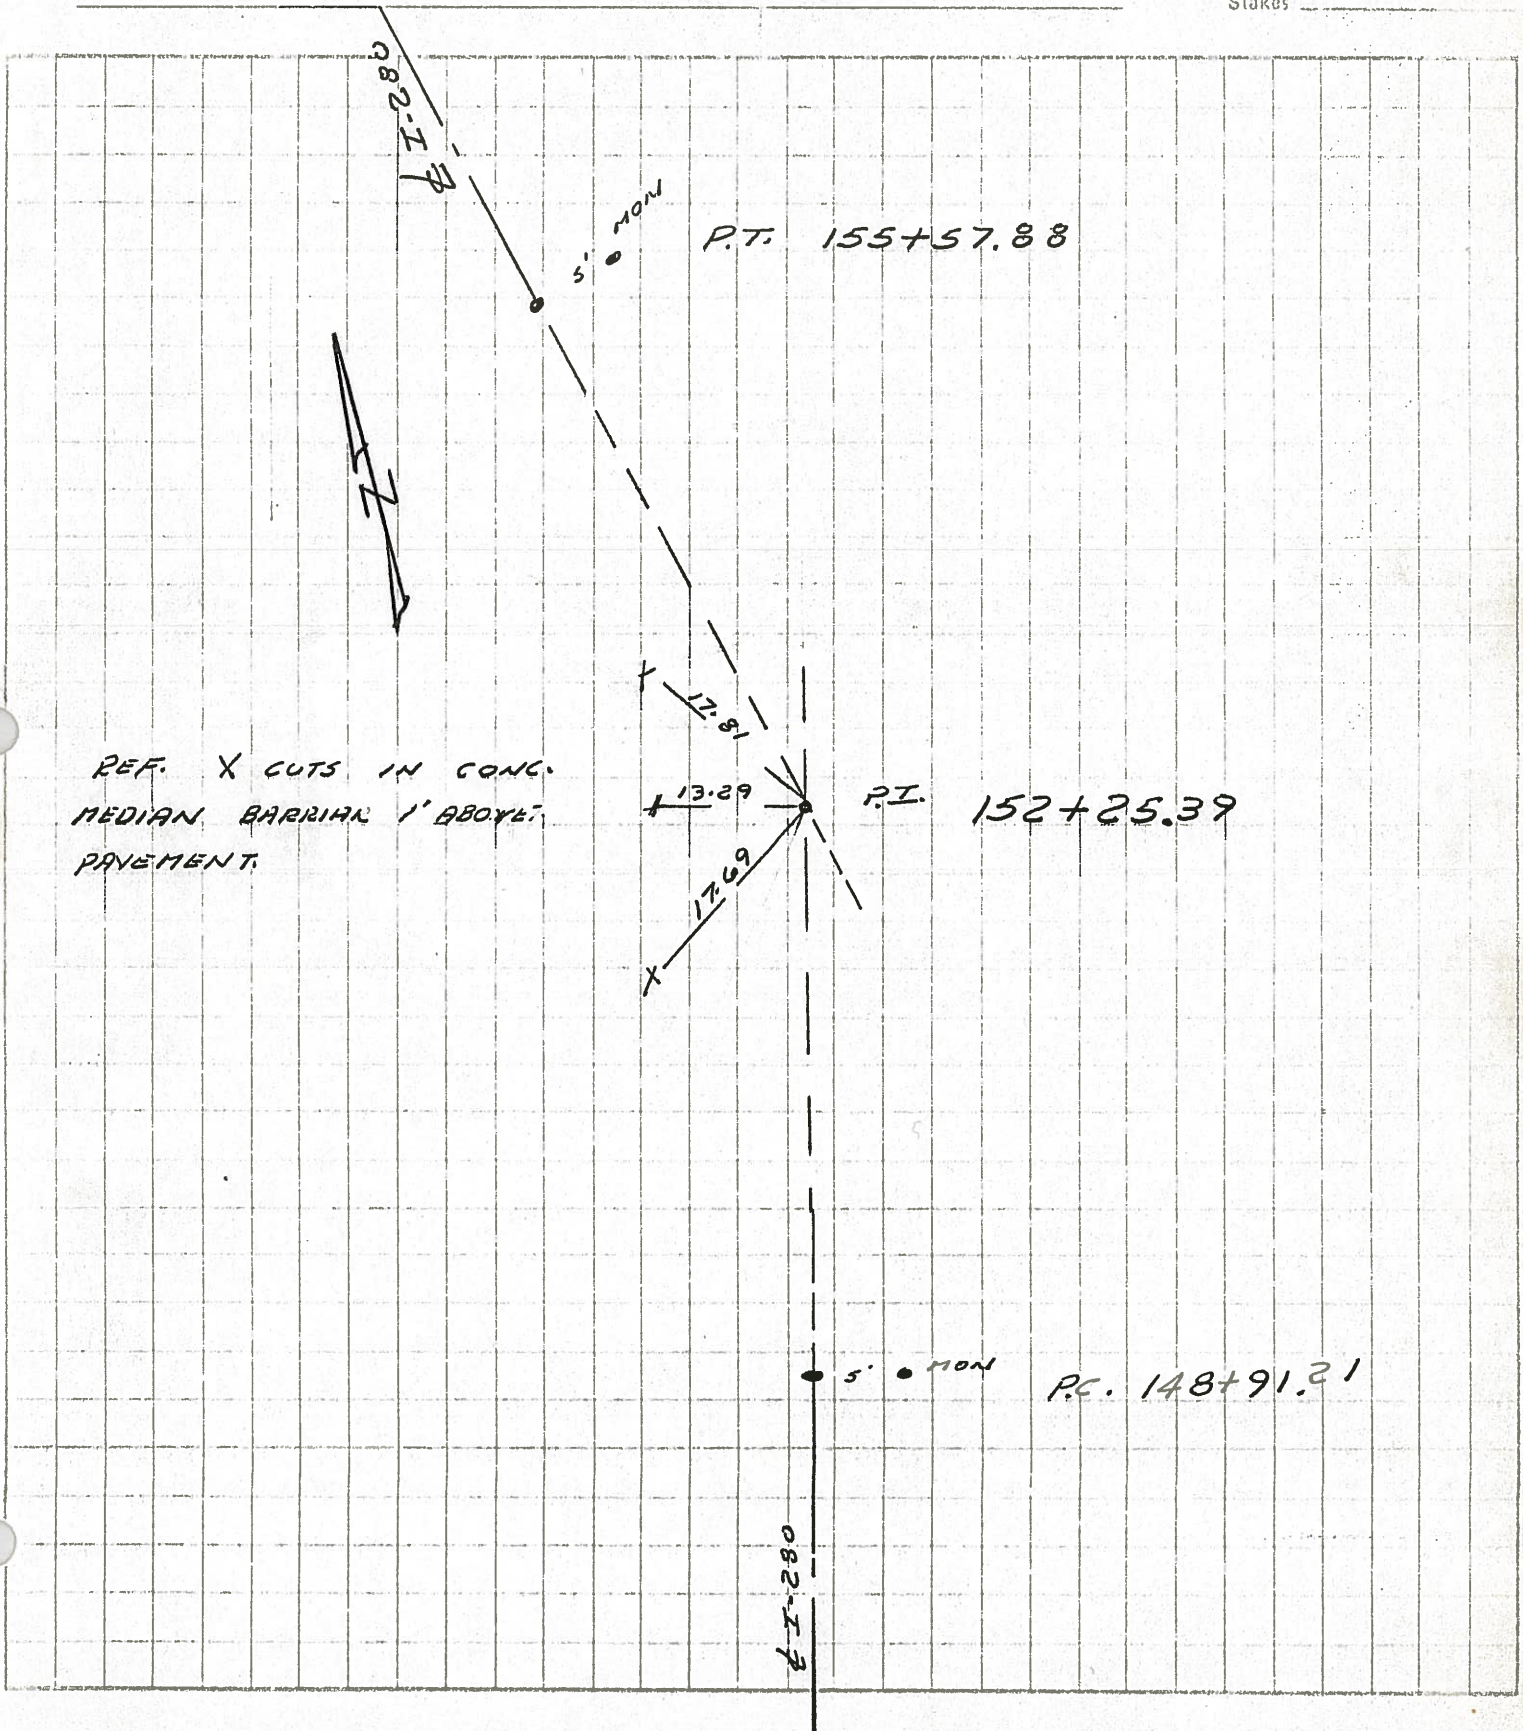

PERSONNEL	TITLE	PERSONNEL	TITLE	COUNTY	DATE
Stone				Lucas	30 Nov. 73
Dana				S. R. I-280	WEATHER Cold
Curtis				SEC. 0.00	TEMP. 32°
Michalak					

DESCRIPTION References to Control Points JOB NO. 02655(6)

LEFT CENTER LINE RIGHT

