


O.D.O.T. DISTRICT 2 SURVEY OFFICE (USE ONLY)


PERSONNEL _____ REFERENCE NO. 9 SHEET 9 OF 12
NOTES STONE DATE 11/30/73 ROUTE IR 280
H.C. MICHALAK WEATHER COLD COUNTY LUCAS
R.C. DENNO TEMP. 32° TOWNSHIP OREGON
CURTIS SECTION 5
DWG BY RHOADES PID 02655 (0) T 10 S R 8 E

TYPE MONUMENT CMON
ON SURFACE - ~~BELOW~~ ON
OFFSET ☉ PAVEMENT ON _____ LT : RT
- TO - EDGE PAVEMENT
STATION: 155+57.88

HORZ.DATUM: _____ GEOID: _____
GRID: NORTHING: _____ EASTING: _____

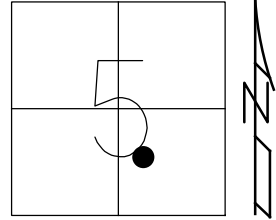

RECORD: P.T.
STA. 155+57.88
11/30/73, IRS

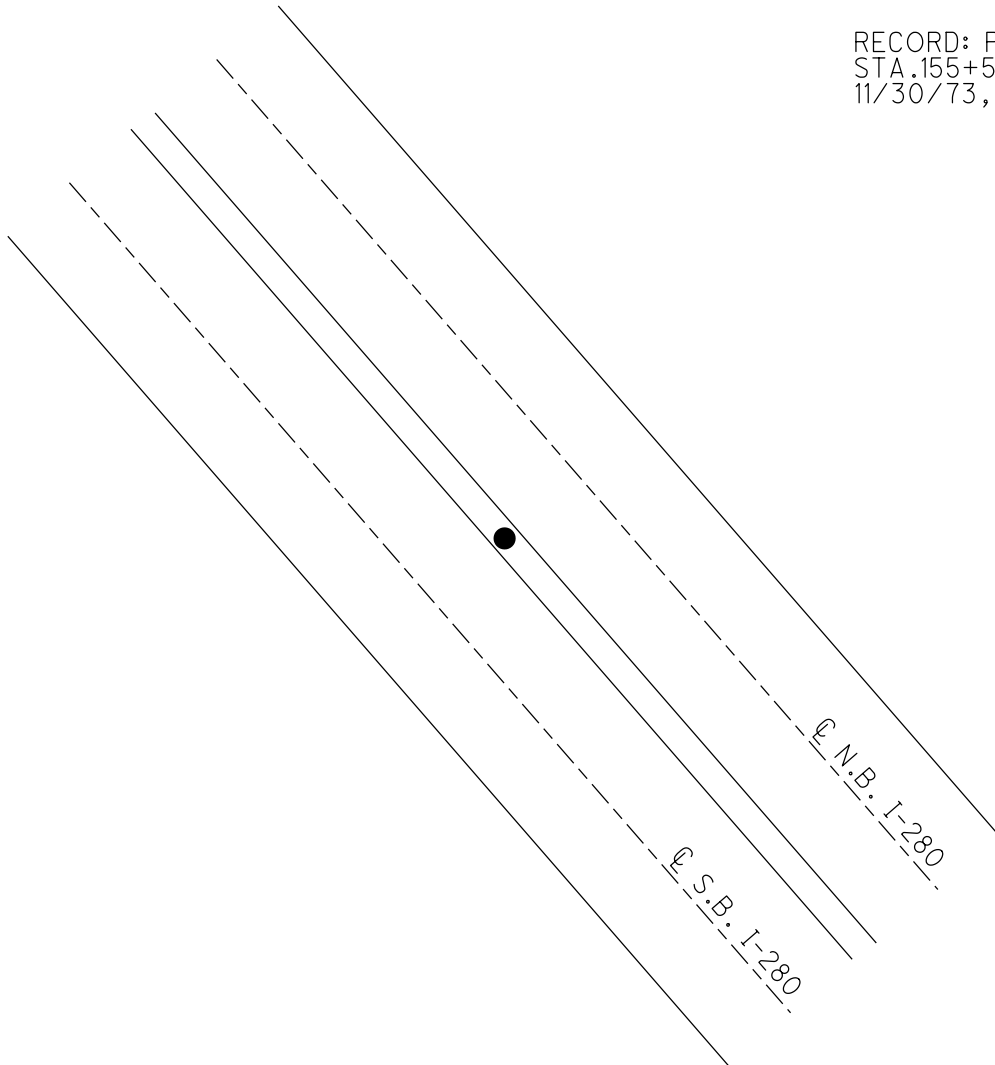

Personnel

Description

SHEET NO. _____

SP

PROJ #211

LUCAS CO.

Date 5/23/79

CB

I-280


Job No. _____

B.R.

REF. TO P.I. 152+25.39 &


Temp. _____

Stakes _____

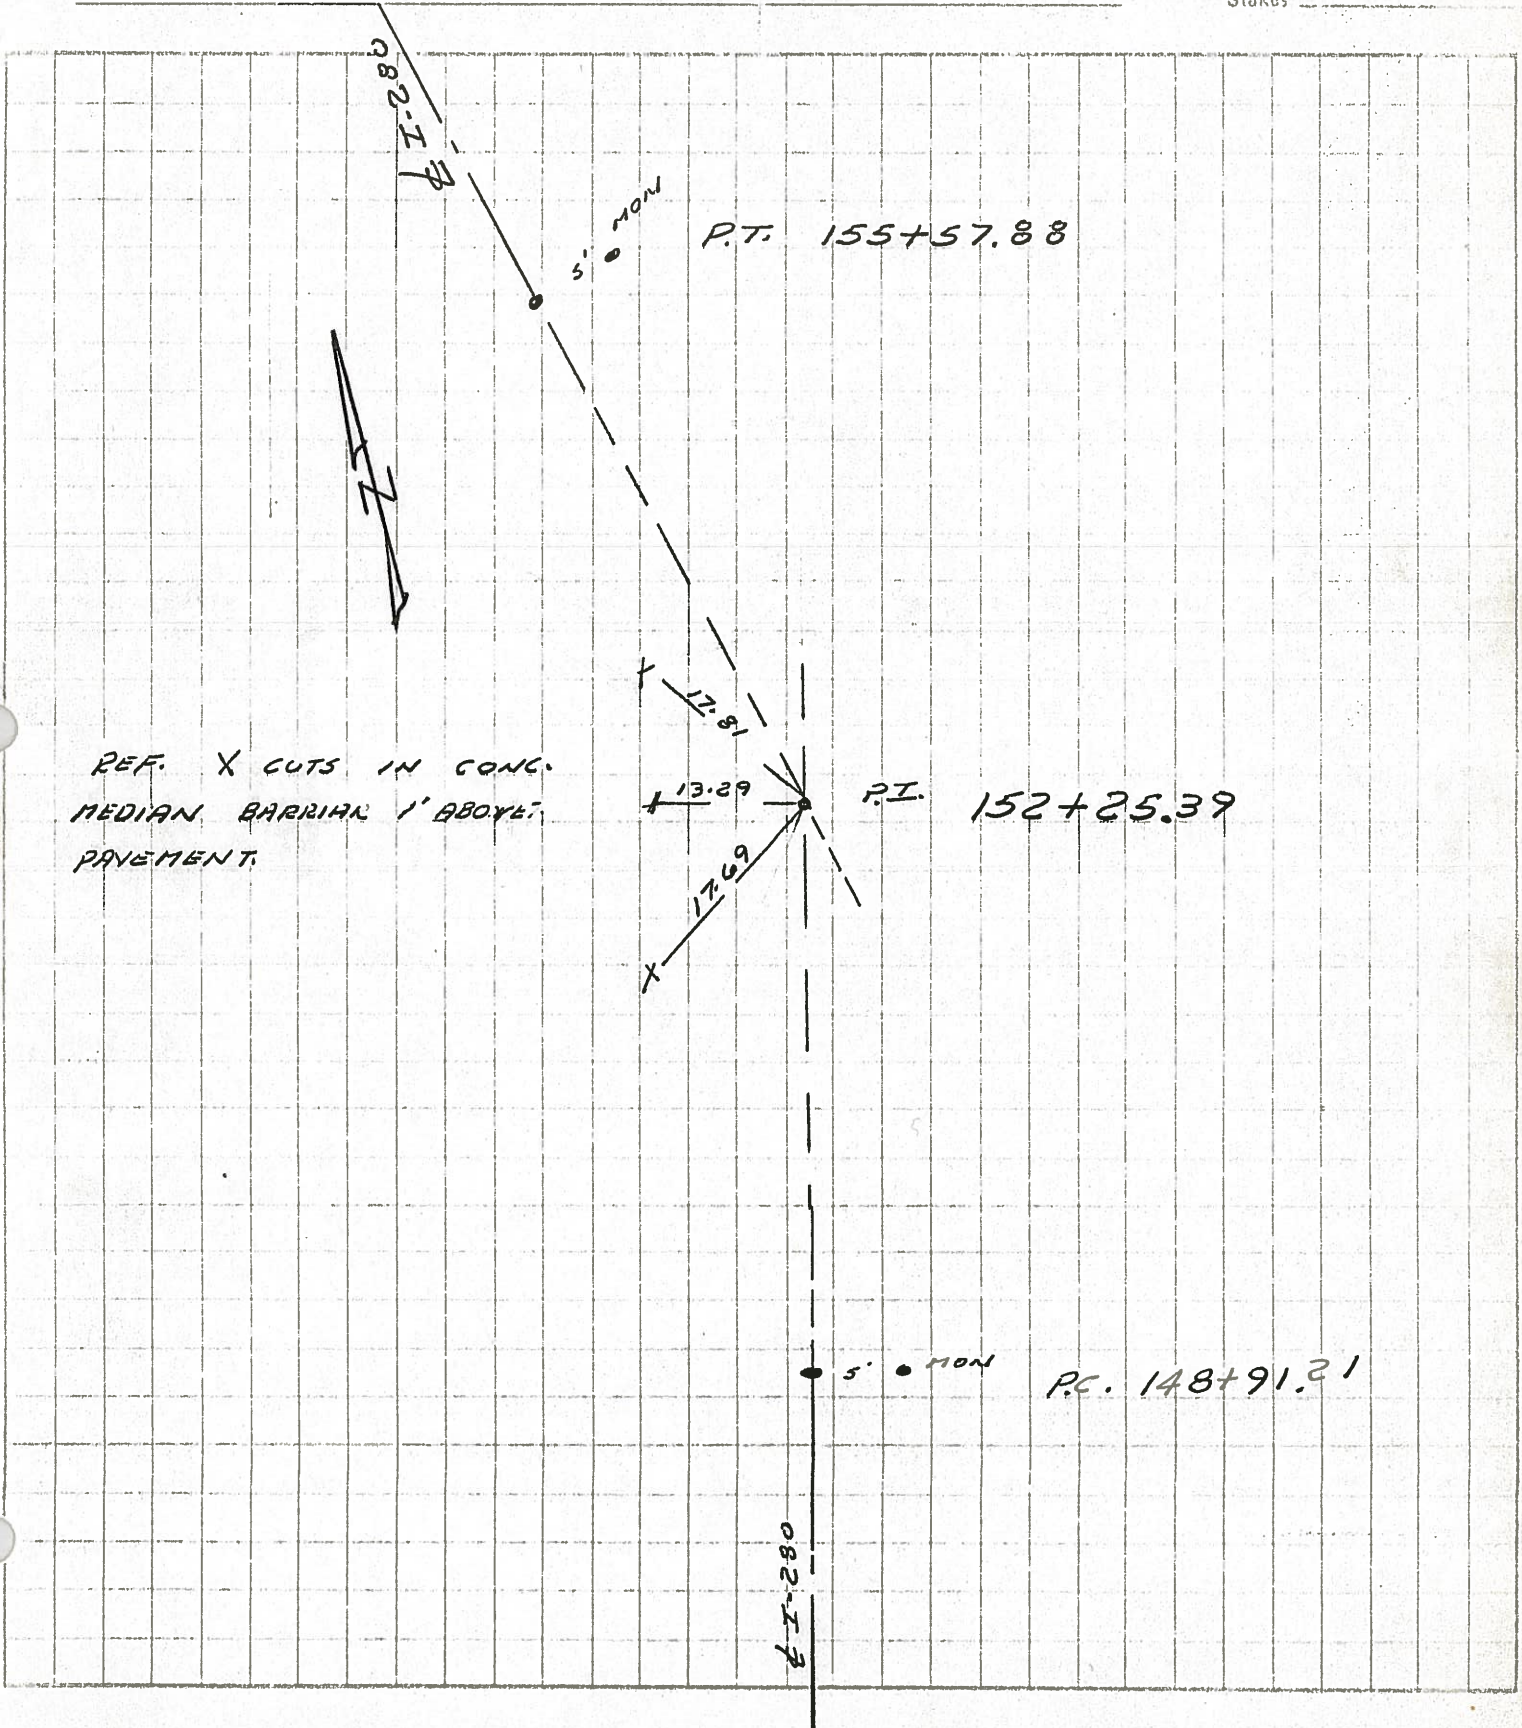

PERSONNEL	TITLE	PERSONNEL	TITLE	COUNTY	DATE
Stone				Locas	30 Nov. 73
Dana				S. R. I-280	WEATHER Cold
Curtis				SEC. 0.00	TEMP. 32°
Michalak					

DESCRIPTION References to Control Points JOB NO. 02655(6)

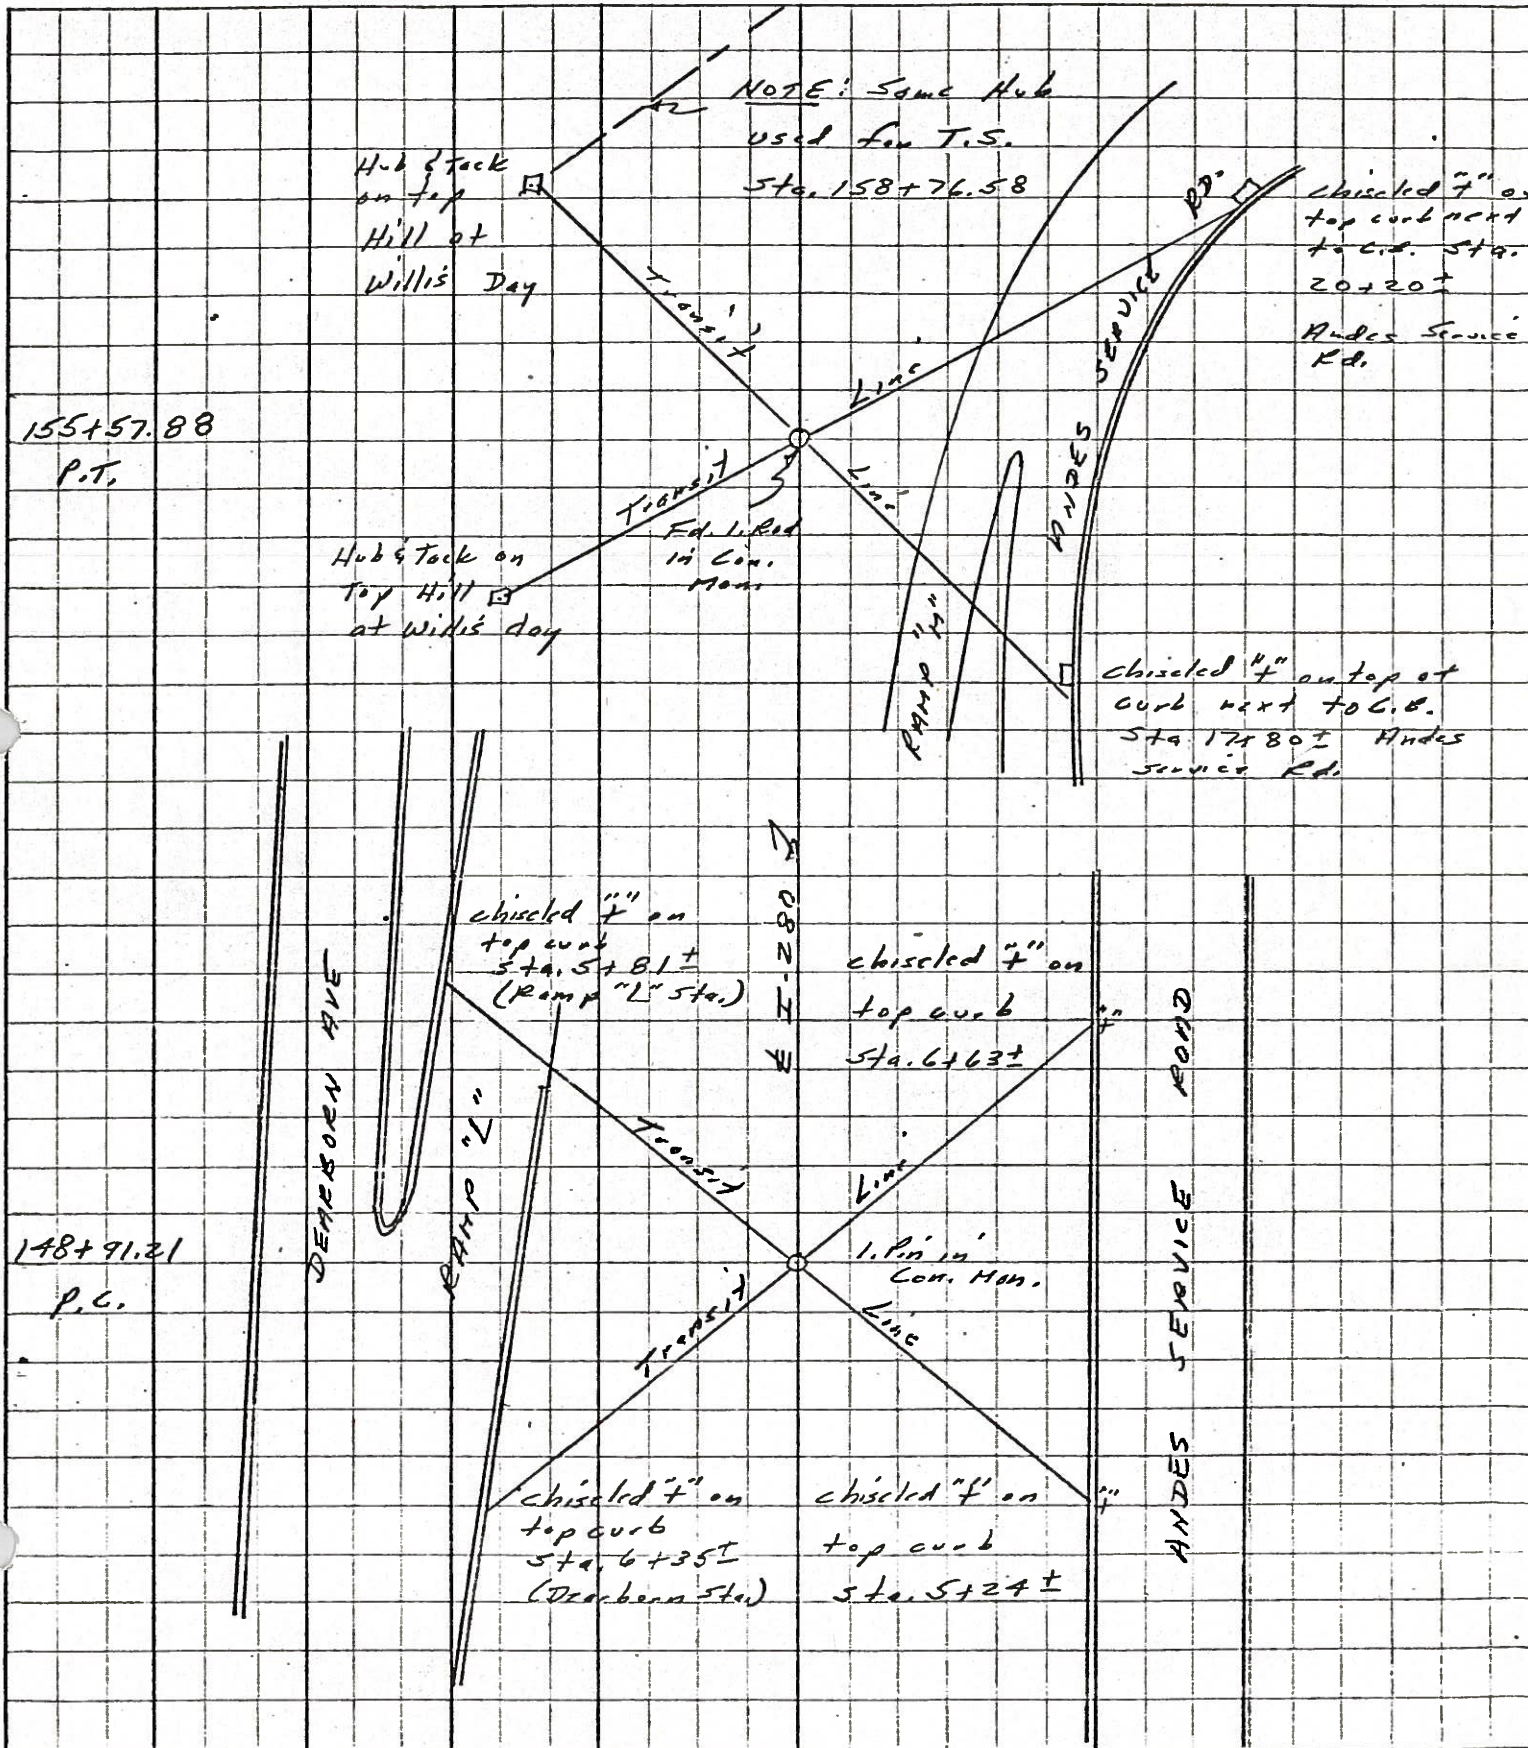

PERSONNEL	TITLE	PERSONNEL	TITLE	COUNTY	DATE
Stone				Lucas	30 Nov. 73
Donno				S. R. I-280	WEATHER Cold
Curtis				SEC. 0.00	TEMP. 37°
Michalek					

DESCRIPTION *References to Control Points* JOB NO. 02655(0)

LEFT CENTER LINE RIGHT

