

O.D.O.T. DISTRICT 2 SURVEY OFFICE (USE ONLY)

PERSONNEL

REFERENCE NO. 10

SHEET 10 OF 12

NOTES STONE

DATE 11/30/73

ROUTE IR 280

H.C. MICHALAK

WEATHER COLD

COUNTY LUCAS

R.C. DENNO

TEMP. 37°

TOWNSHIP OREGON

CURTIS

SECTION 5

DWG BY RHOADES

PID 02655 (0)

T 10 S R 8 E

TYPE MONUMENT CMON

ON SURFACE - ~~BELOW~~ ON

OFFSET ☉ PAVEMENT ON LT : RT

- TO - EDGE PAVEMENT


STATION: 158+76.58

HORZ.DATUM: _____


GEOID: _____

GRID: NORTHING: _____

EASTING: _____

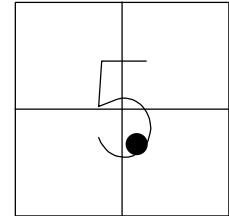

RECORD: T.S.
STA. 158+76.58
11/30/73, IRS

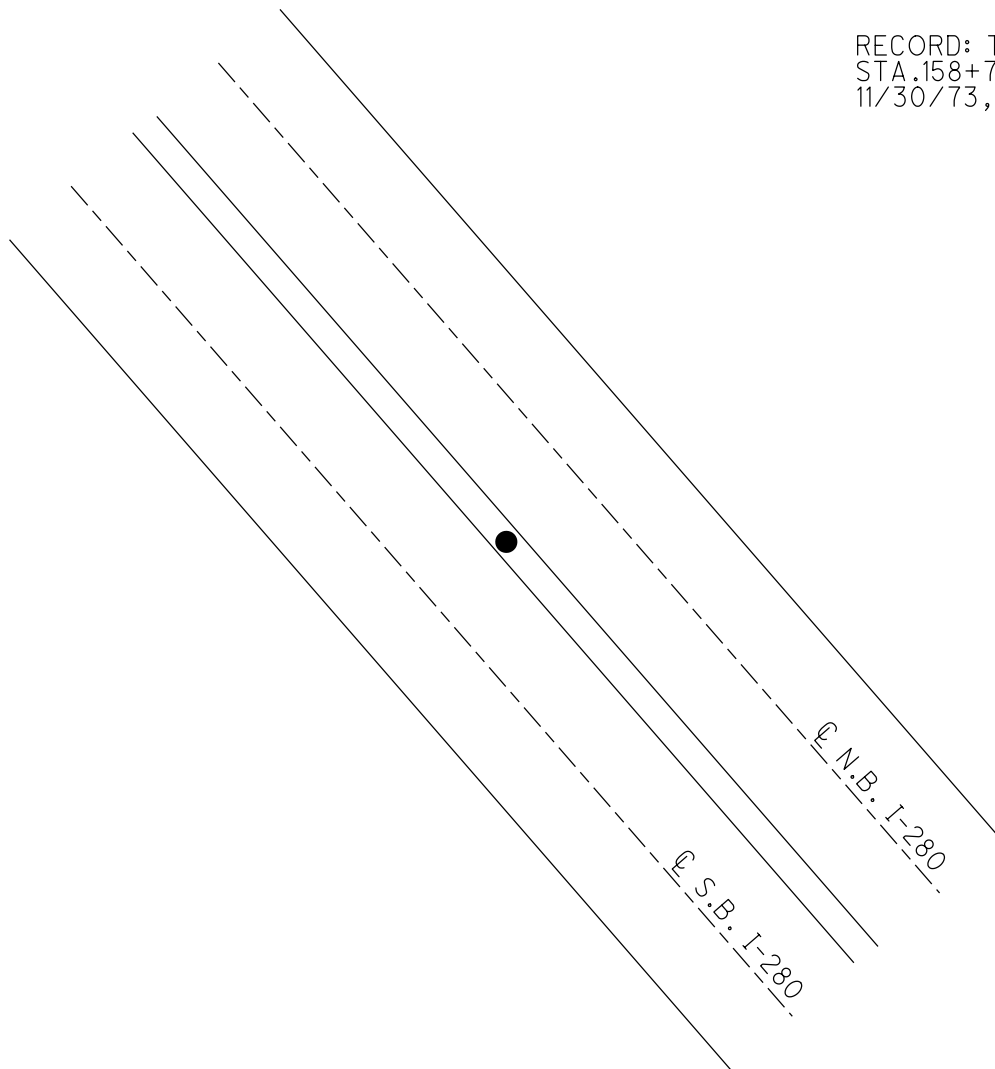

PERSONNEL	TITLE	PERSONNEL	TITLE	COUNTY	DATE
Stone				Lucas	30 Nov. 73
Donno				S. R. I-280	WEATHER Cold
Curtis				SEC. 0.00	TEMP. 37°
Michalek					

DESCRIPTION *References to Control Points* JOB NO. 02655(0)

LEFT CENTER LINE RIGHT

