

PRIORITY NO. 29 PART 2 OF 2 SHEET 1 OF 10
COUNTY LUCAS ROUTE SR 295 SECTION 18.06
BEGIN LOG (SLM) 18.06 CALC. 953+56.8 TERMINII US 20
END LOG (SLM) 21.45 CALC. 1132+56 TERMINII BERKEY MICHIGAN STATE LINE
TOTAL LENGTH 3.39 Mea 1133+44 MILES
MUNICIPALITY BERKEY BEGIN LOG (SLM) 1032+48 SIGN ON RT END LOG (SLM) 1133+44
MUNICIPALITY _____ BEGIN LOG (SLM) _____ END LOG (SLM) _____
PROPOSED WORK: Resurface
PAVEMENT 1 1/2" 404 SHOULDER SAME - 617
OTHER LOCATE BAD PAVEMENT & SHOULDER AREAS

STATION ESTABLISHED FROM: Log Book - Ctr of Intersection SR 295 @ U.S. 20
SLM = 18.06 $\Rightarrow$ Calc to 953+56.80



NOTE: ENDING Joint Fd @ Sta 1133+38
BUT Ref Point Fd for State Line
@ Sta 1133+44

STRUCTURES:

NUMBER	STATION	WIDTH	LENGTH	PROPOSED WORK
19.199		See	Sh #	
20.548		See	Sh #	
21.24	REAR 1122+12 - ABUT	27.8'	74' ⁽⁺²⁾ (25' Conc Approach)	- Butt Joint @ Approach SLAB No Work $\Rightarrow$ 124 ft

RAILROAD CROSSING: NONE

(NO WORK)

NAME _____ STATION _____ NO. TRACKS _____ LENGTH ALONG C L _____ FT
NAME _____ STATION _____ NO. TRACKS _____ LENGTH ALONG C L _____ FT

MISCELLANEOUS:

NO RAISED PAVEMENT MARKERS; EDGE OF PAVEMENT 96 CENTERLINE 132

NO. MAILBOX APPROACHES N/A MAILBOX SUPPORTS N/A

REMARKS: Butt joint @ concrete deck @ Bridge near Mich. State Line
PAVE OVER NEW CULVERTS

No RAISED P.M. Within Corp Limits - All south of Berkey Corp

DATE 7-20-70

SHEET 2 OF 10

TWO-LANE RESURFACING PROGRAM
PAVEMENT DATA

NOTE: LOCATE ALL
CHANGES IN PVMT WIDTH

COUNTY LUCAS ROUTE S.R. 295 SECTION 18.06

[illegible]

* = STATION LOCATION

[illegible]

DATE 7-20-75

SHEET 3 OF 16

UTILITIES (CATCH BASIN, MANHOLE, INLET, WATER VALVE, BOX AND MONUMENT BOX)

COUNTY LUCAS ROUTE S.R. 295 SECTION 18.06

R = RAISE F = FEATHER

[illegible]

SHEET 4 OF 16

SHEET 4 OF 16

L = PROP PAVT DEPTH (IN) X 10; W = WIDTH @ MOUTH; $W-I$ = WIDTH @ THROAT

[illegible]

SHEET 5 OF 10

SHEET 5 OF 10

COUNTY LUCAS ROUTE S.R. 295 SECTION 18.06

[illegible]

SHEET 6 OF 10

SHEET 6 OF 10

COUNTY LUCAS ROUTE S.R. 295 SECTION 18.06

[illegible]

194SWH

OHIO DEPARTMENT OF TRANSPORTATION


SHEET NO. 7/10

PERSONNEL	TITLE	PERSONNEL	TITLE	COUNTY	DATE	WEATHER	TEMP.
LOEHARKE				LUCAS	9-20-95	DAMP	+58
Crew				S. R. 295			
				SEC. 18.06			
DESCRIPTION				Begin Job - North Side U.S. 20		JOB NO.	
LEFT				CENTER LINE		RIGHT	

"ROUGHLY PLACED" ASPHALT DUMPED
AROUND C. BASIN - Something Like a
Slope Protection. This should Also
Be "PAVED" to Prevent Drop-OFF
From New PAVT

G. LOEHARKE
9-20-95

CATCH BASINS IN NW & NE
Corners - No Work

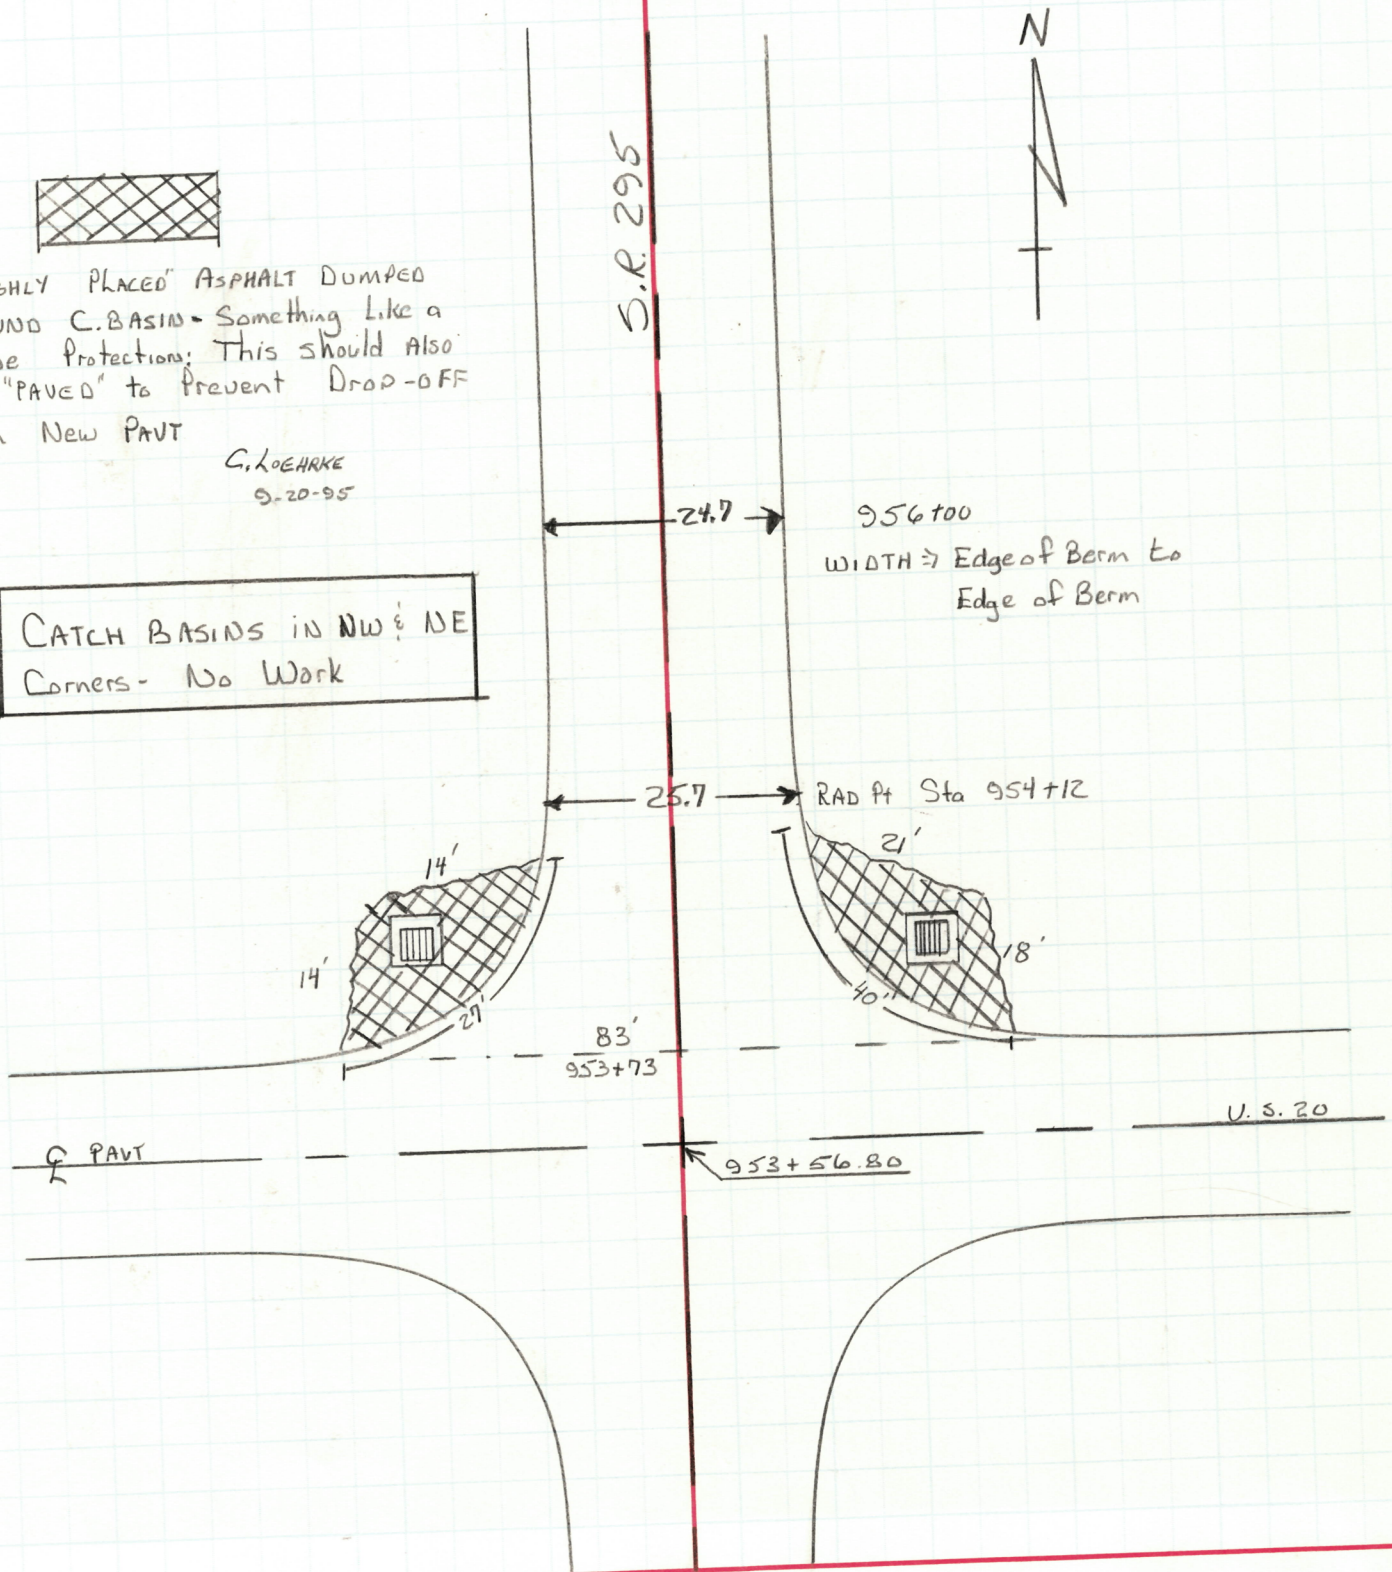

194SWH

OHIO DEPARTMENT OF TRANSPORTATION

SHEET NO. 9/10


PERSONNEL	TITLE	PERSONNEL	TITLE	COUNTY	DATE	WEATHER	TEMP.
LOEHRKE				LUCAS	9-20-95	DAMP!	62
and				S. R. 295			
Crew				SEC. 18.06			

DESCRIPTION New PAVT @ Box Culvert JOB NO. _____

LEFT


CENTER LINE

RIGHT

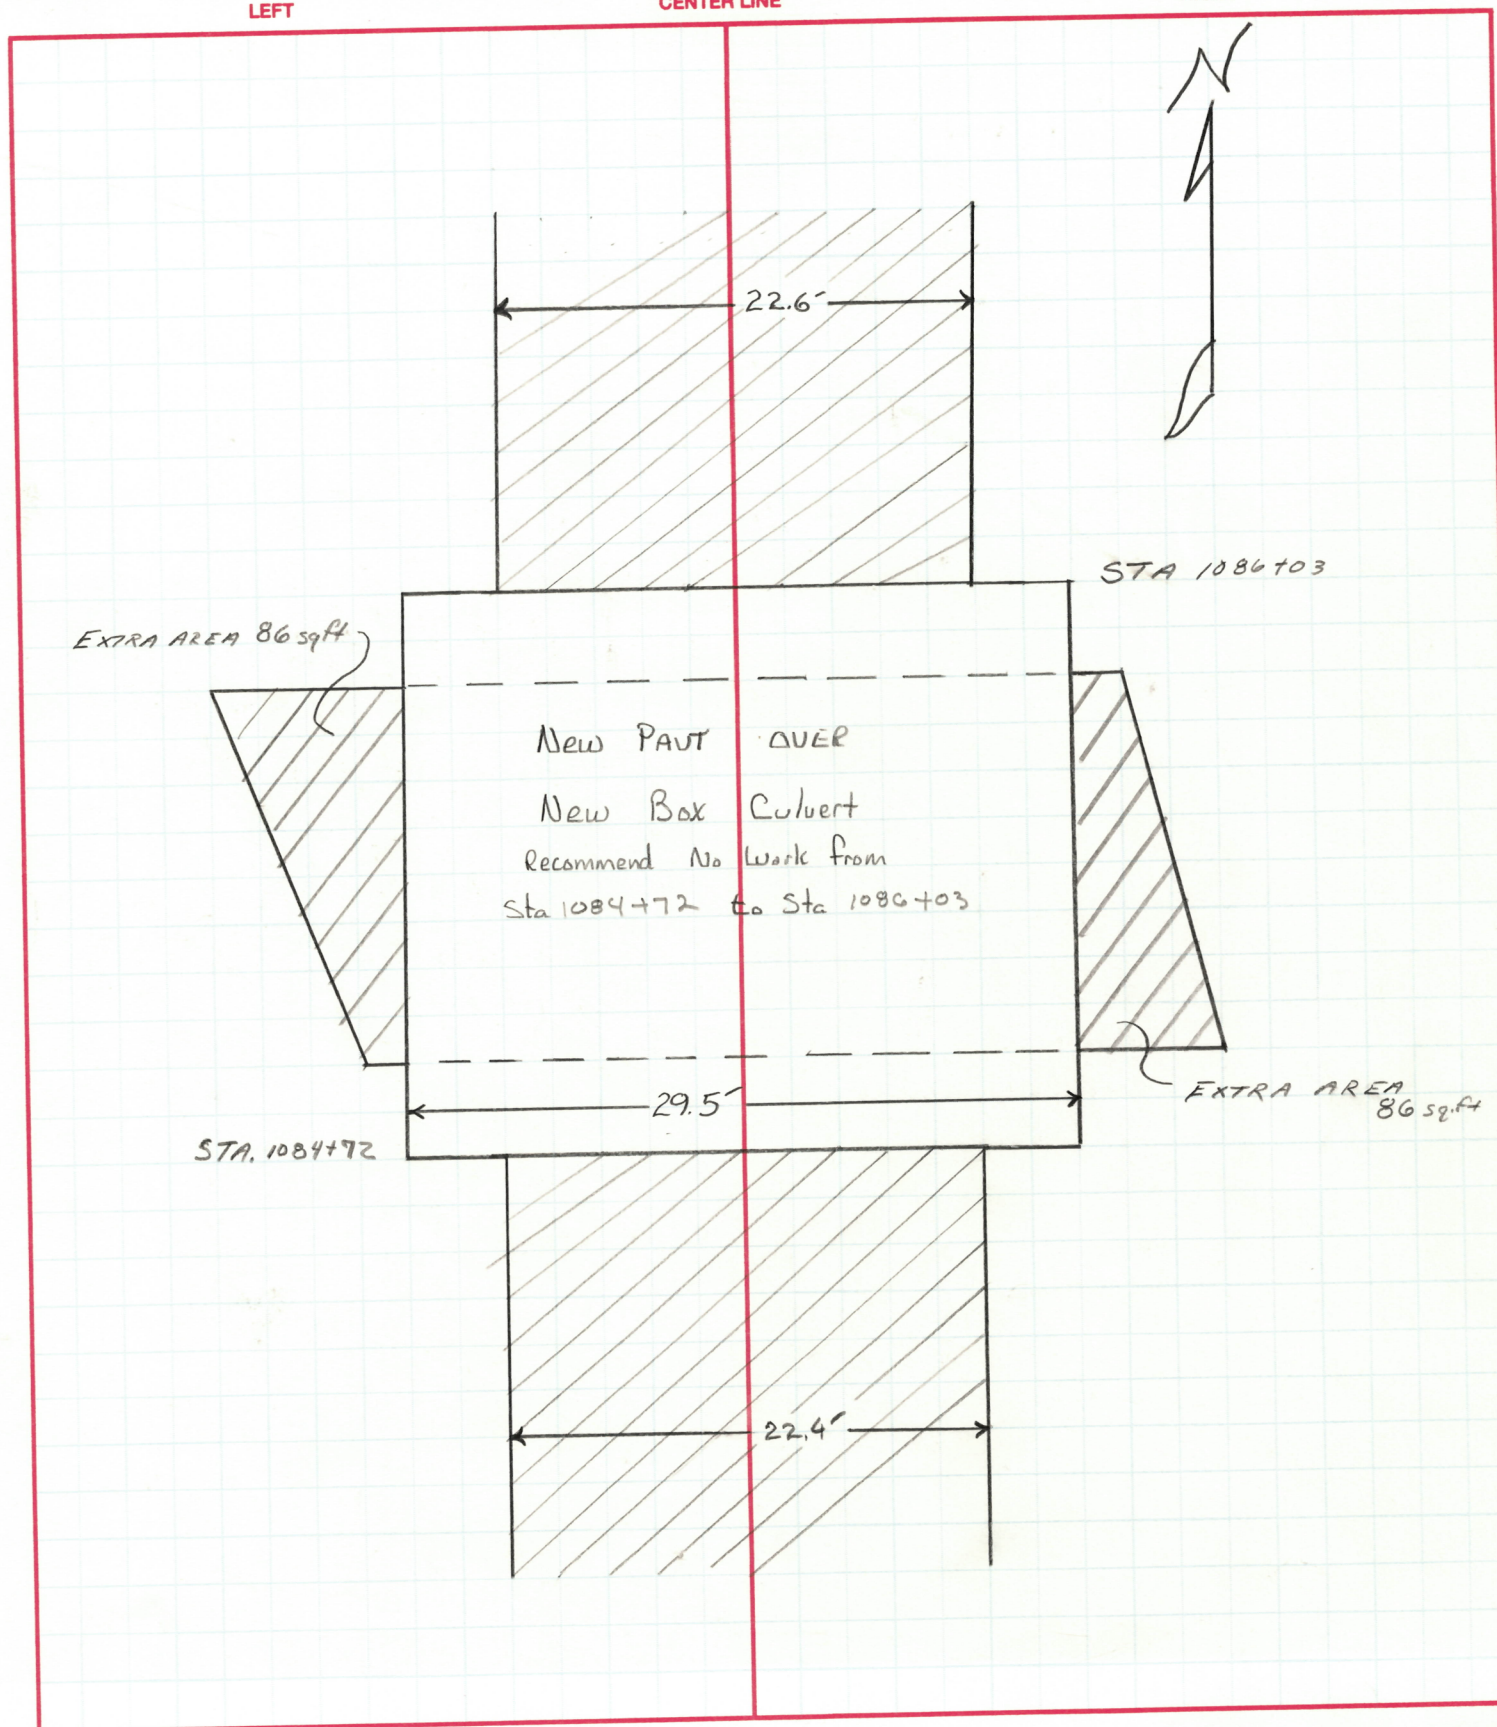

PERSONNEL	TITLE	PERSONNEL	TITLE	COUNTY	DATE	WEATHER	TEMP.
LOEHRKE				LUCAS	9-20-95	OVERCAST	+62°
CANTERBURY				S. R. 295			
ROUSOS				SEC. 18.06			

DESCRIPTION	LEFT	CENTER LINE	RIGHT	JOB NO.
NEW PAVT @ BOX CULVERT				

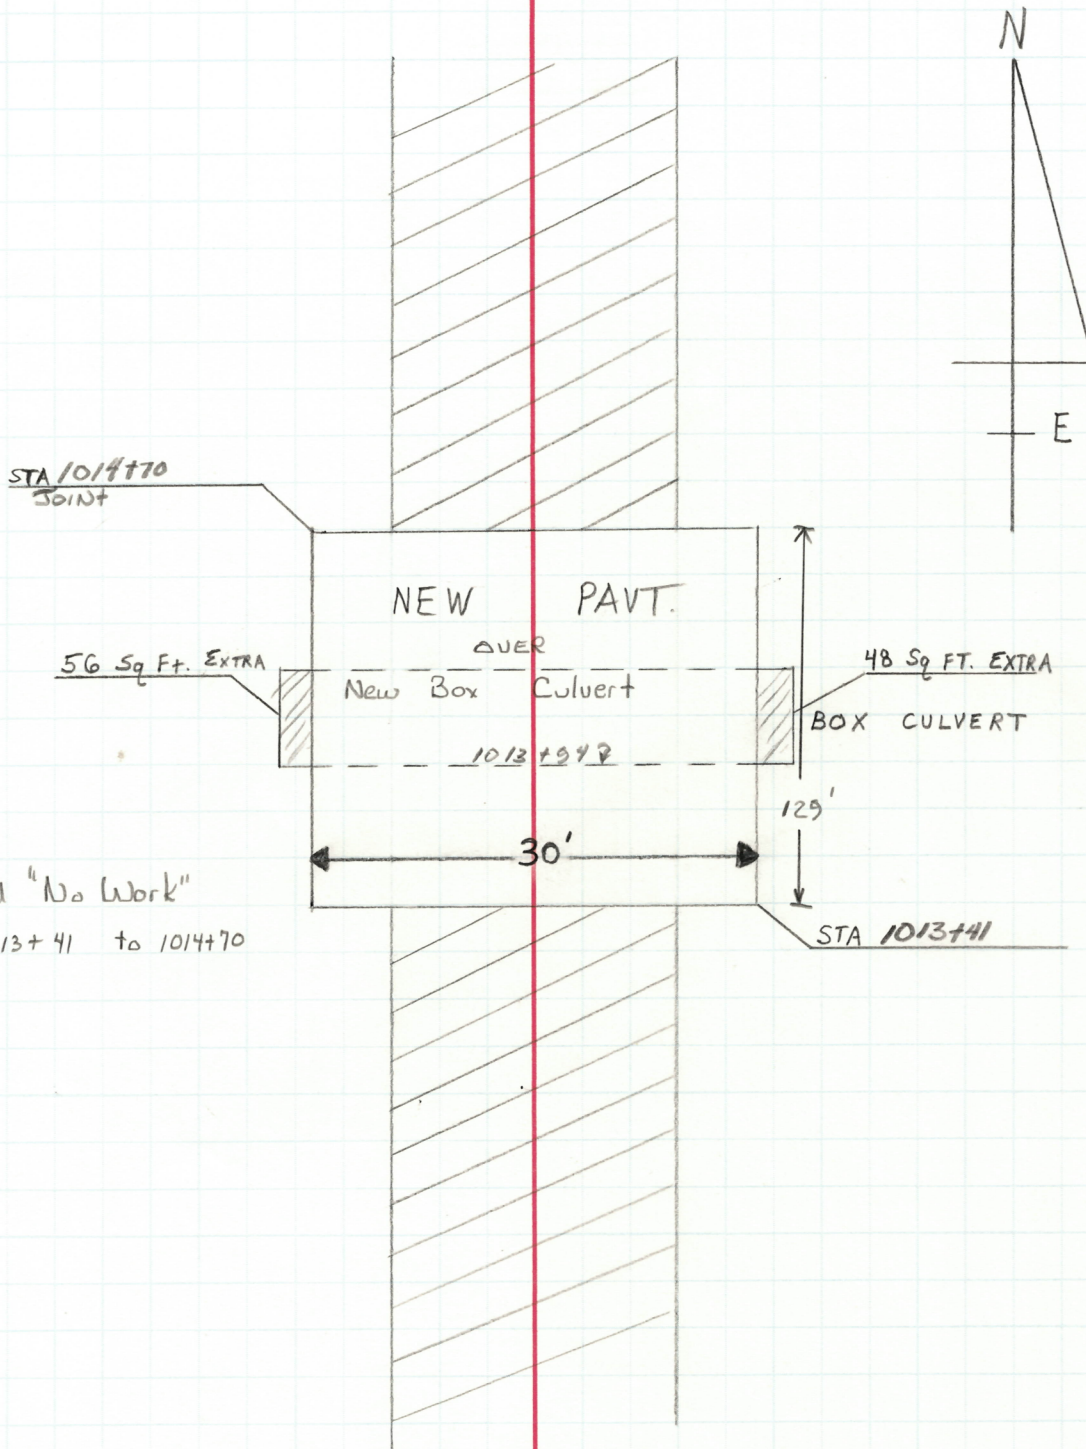

Recommend "No Work"
From Sta 1013+41 to 1014+70