


O.D.O.T. DISTRICT 2 SURVEY OFFICE (USE ONLY)

PERSONNEL \_\_\_\_\_ REFERENCE NO. I SHEET 9 OF 26  
 NOTES LEU DATE 8/8/17 ROUTE SR 295  
 H.C. HOMAN WEATHER \_\_\_\_\_ COUNTY LUCAS  
 R.C. LEU TEMP. \_\_\_\_\_ TOWNSHIP PROVIDENCE  
 \_\_\_\_\_ SECTION 5  
 DWG BY MILLER PID 83894 T 5 N R 9 E


TYPE MONUMENT MON BOX W/ 3/4" IPIN  
 ON SURFACE - ~~BELOW~~ ON  
 OFFSET CL PAVEMENT \_\_\_\_\_ ~~LT~~ ~~RT~~  
 \_\_\_\_\_ TO \_\_\_\_\_ EDGE PAVEMENT  
 STATION: 56+29.5

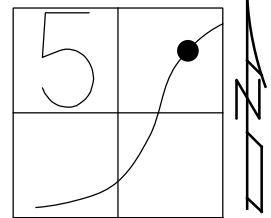

HORIZ.DATUM: NAD83(2011) GEOID: 2012A  
 GRID: NORTHING: 644015.987 EASTING: 1598424.279

RECORD:

NOTE: P.T.  
 REF: LUC-24-0.00  
 PID: 25490, 83984  
 NEW MON BOX SET PER PID  
 #83894 WITH STRADDLERS, NO  
 IRON PIN WAS FOUND INSIDE.  
 ODOT STAFF SET 3/4" IRON PIN  
 FROM STRADDLERS. SHOT W/GPS,  
 BUT DID NOT REFERENCE  
 YEAR 2017

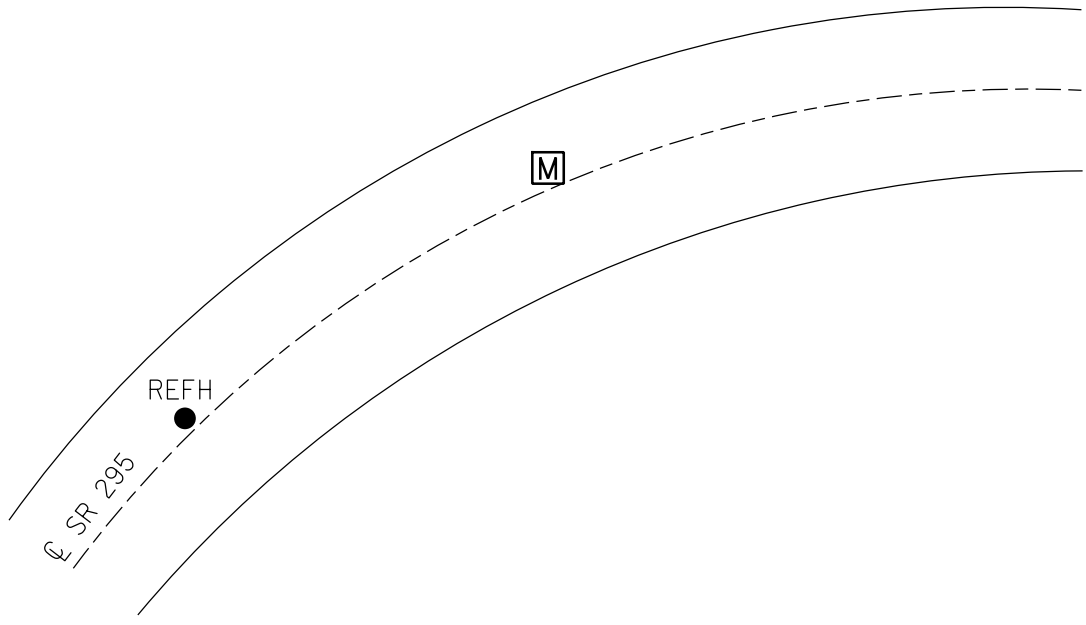

REFI-REFIJ= 116.81' REC