

O.D.O.T. DISTRICT 2 SURVEY OFFICE (USE ONLY)

PERSONNEL

REFERENCE NO. T

SHEET 19 OF 20

NOTES HUSS DATE 6/2/97
 H.C. VAN DUSEN WEATHER CLOUDY/RAIN
 R.C. CORDES TEMP. 57°
COX

ROUTE SR 295
 COUNTY LUCAS
 TOWNSHIP PROVIDENCE
 SECTION 33
 T 6 N R 9 E

DWG BY MILLER PID 83894

TYPE MONUMENT P.K./WASHER

ON SURFACE - ~~BELOW~~ ON

OFFSET 6.1' \perp PAVEMENT 5.6' ~~RT~~ : RT

6.1' TO RT EDGE PAVEMENT


STATION: 129+95

HORIZ.DATUM: NAD83(2011)

GEOID: 12A NAVD88


GRID: NORTHING: 647014.512

EASTING: 1605134.414

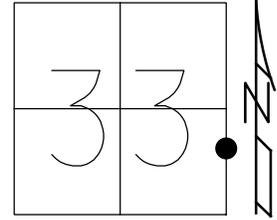

RECORD:
 PRIOR REF21-US24
 FD P.K.NAIL
 6/2/97, BVD
 SET P.K./WASHER
 10-21-97, SAH
 FD MONBOX
 W/ 3/4" IPIN
 REF20
 8-8-17, JLL

NOTE:
 REF: LUC-24-0.00
 PID: 25490, 83984

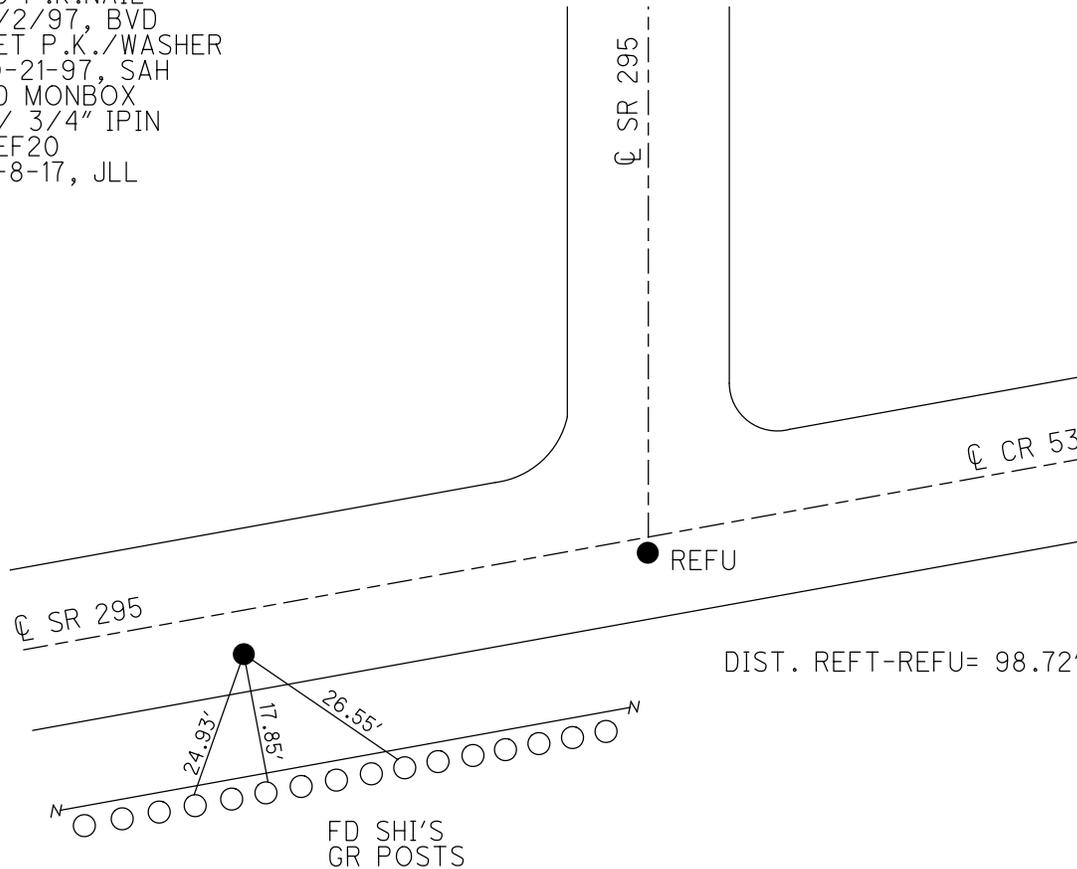

O.D.O.T. DISTRICT 2 SURVEY OFFICE

PERSONNEL

REFERENCE NO. 21

SHEET 27 OF 68

NOTES S. HUSS

H.C. B. VANDUSEN

R.C. B. CORDES

C. COX

DATE 6-2-97

WEATHER CLOUDY / RAIN

TEMP. + 57°F

ROUTE US -24

COUNTY Lucas

TOWNSHIP Providence

SECTION 33

T 6 N R 9 E

TYPE MONUMENT PK NAIL

ON SURFACE - ~~BELOW~~ ON SURFACE

~~LEFT - C PAV'T.~~ - RIGHT 5.6' RT

6.1 TO RT EDGE PAVEMENT

S.L.M. 109+17

