

O.D.O.T. DISTRICT 2 SURVEY OFFICE (USE ONLY)

PERSONNEL

REFERENCE NO. 3

SHEET 3 OF 45

NOTES AUBLE

DATE 5-3-23

ROUTE SR 295

H.C. NIESE

WEATHER WINDY

COUNTY LUCAS

R.C. MILLER

TEMP. 53°

TOWNSHIP PROVIDENCE

SECTION 33

DWG BY ASTON

PID CHIP SEAL

T 6 N R 9 E

TYPE MONUMENT MAG/ WASHER

ON SURFACE - ~~BELOW~~ ON

OFFSET 0.5' ~~LT~~ : RT

12' TO LT EDGE PAVEMENT


STATION: 165+11.69

HORZ. DATUM: NAD83(2011)

GEOID: NAVD88 2018


GRID: NORTHING: 650492.355

EASTING: 1605144.579

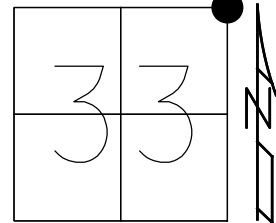

RECORD:  
 FD SM.R.R.SPIKE  
 8/28/02, DCH  
 SET MAG/WASHER  
 11/21/02, DCH  
 FD MAG NAIL  
 REF23  
 12/4/15, JLL  
 SET MAG/WASHER  
 7/17/17, DCH  
 FD MAG/ WASHER  
 REF3  
 5-3-23, TDN  
 FD MAG/ WASHER  
 2-29-23, JAM

LUCAS: LDP  
 N: 271486.208  
 E: 115952.847

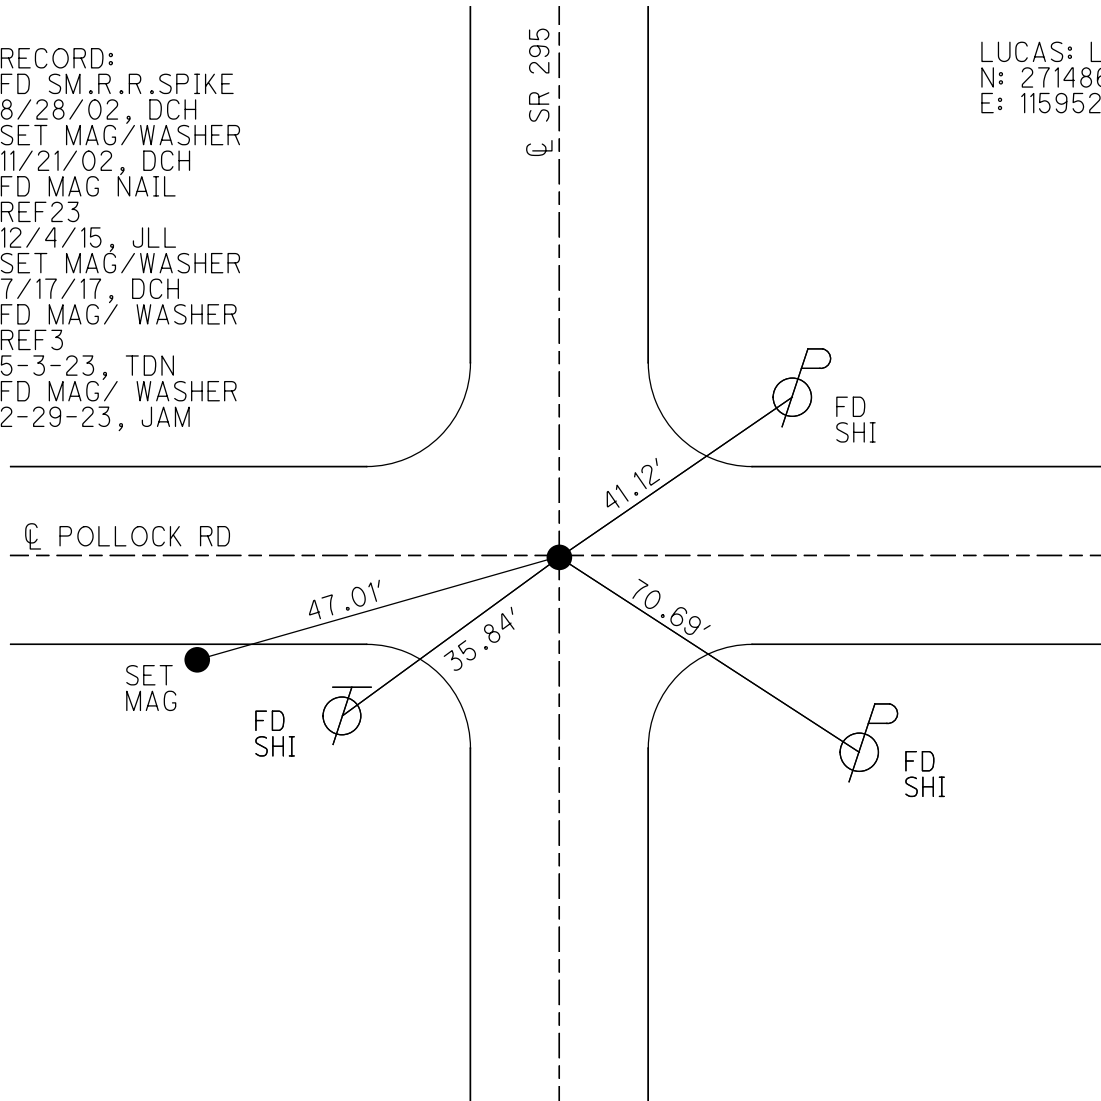

O.D.O.T. DISTRICT 2 SURVEY OFFICE (USE ONLY)

PERSONNEL \_\_\_\_\_ REFERENCE NO. 3 SHEET 3 OF 45

NOTES HOMAN DATE 3/17/17 ROUTE SR 295

H.C. HOMAN WEATHER CLOUDY COUNTY LUCAS

R.C. HELDMAN TEMP. 30° TOWNSHIP PROVIDENCE

SECTION 33

T 6 N R 9 E

TYPE MONUMENT MAG NAIL


~~ON SURFACE~~ - BELOW ON

~~LEFT~~ - CL PAV'T - RIGHT 0.5'


12' TO LT EDGE PAVEMENT

S.L.M. 165+11.69

GRID: NORTHING: 650492.355 EASTING: 1605144.579

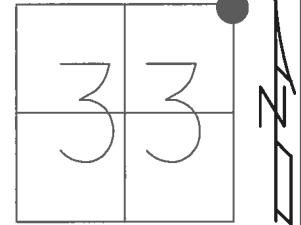

RECORD:  
 FD SM.R.R.SPIKE  
 8/28/02, DCH  
 SET MAG/WASHER  
 11/21/02, DCH  
 FD MAG NAIL  
 REF23  
 12/4/15, JLL  
 SET MAG/WASHER  
 7/17/17, DCH

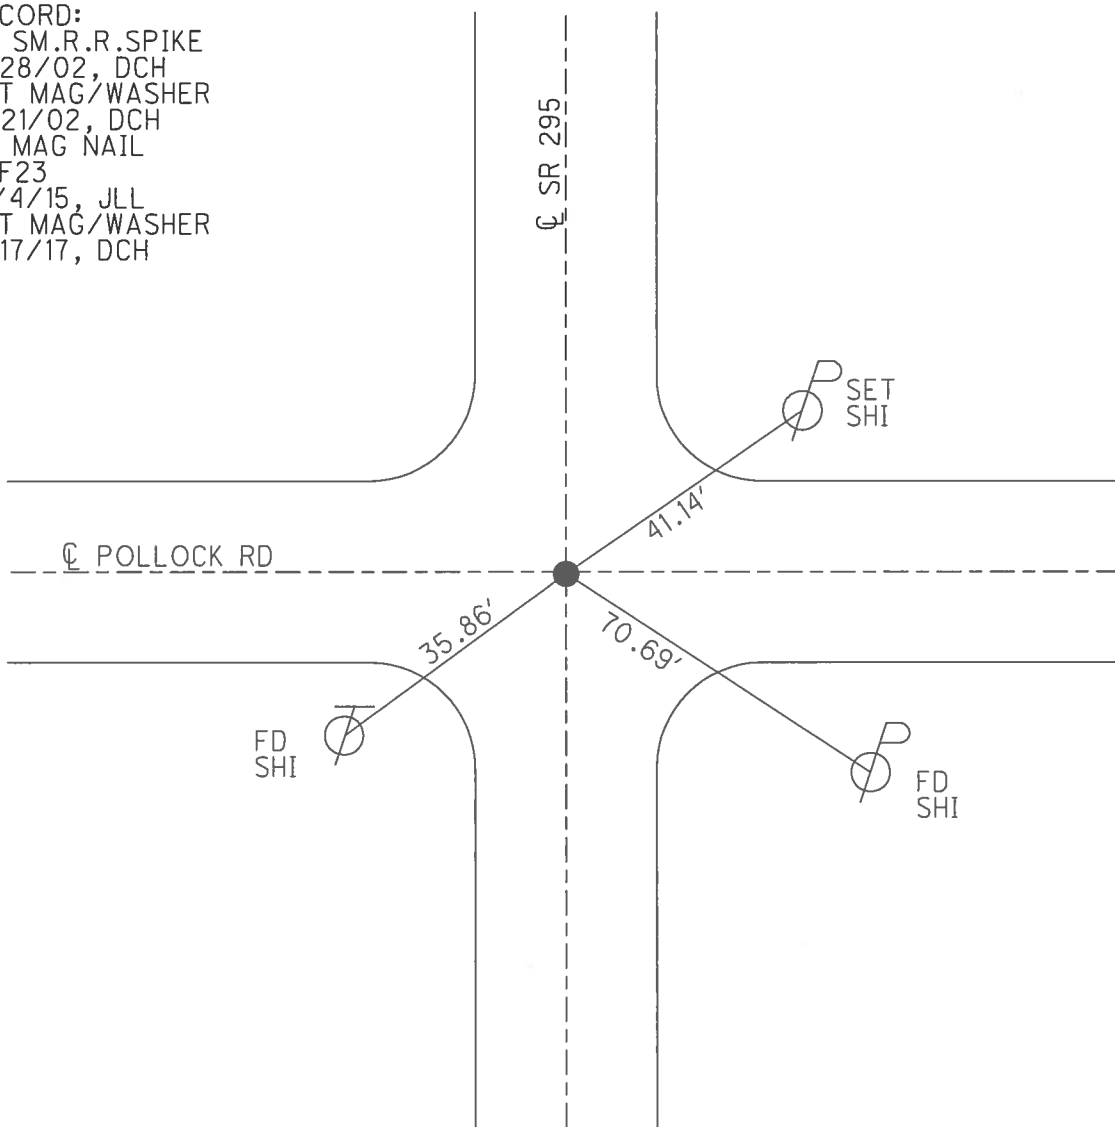

O.D.O.T. DISTRICT 2 SURVEY OFFICE

PERSONNEL \_\_\_\_\_

REFERENCE NO. 3

SHEET 3 OF 45

NOTES BEAUMONT

DATE 8-29-02

ROUTE S.R. 295

H.C. HOMAN

WEATHER SUNNY

COUNTY LUCAS

R.C. BEAUMONT

TEMP. 75°

TOWNSHIP PROVIDENCE

SECTION 33

T 6 N R 9 E

TYPE MONUMENT SMALL RR SPIKE


~~ON SURFACE~~ - BELOW 2"

~~LEFT~~ - Q PAV'T - RIGHT 0.5'


12' TOL'T. EDGE PAVEMENT

S.L.M. 34+70

28	27
33	34

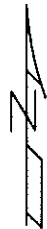

SET MAG &  
WASHER  
11-21-02  
DCH

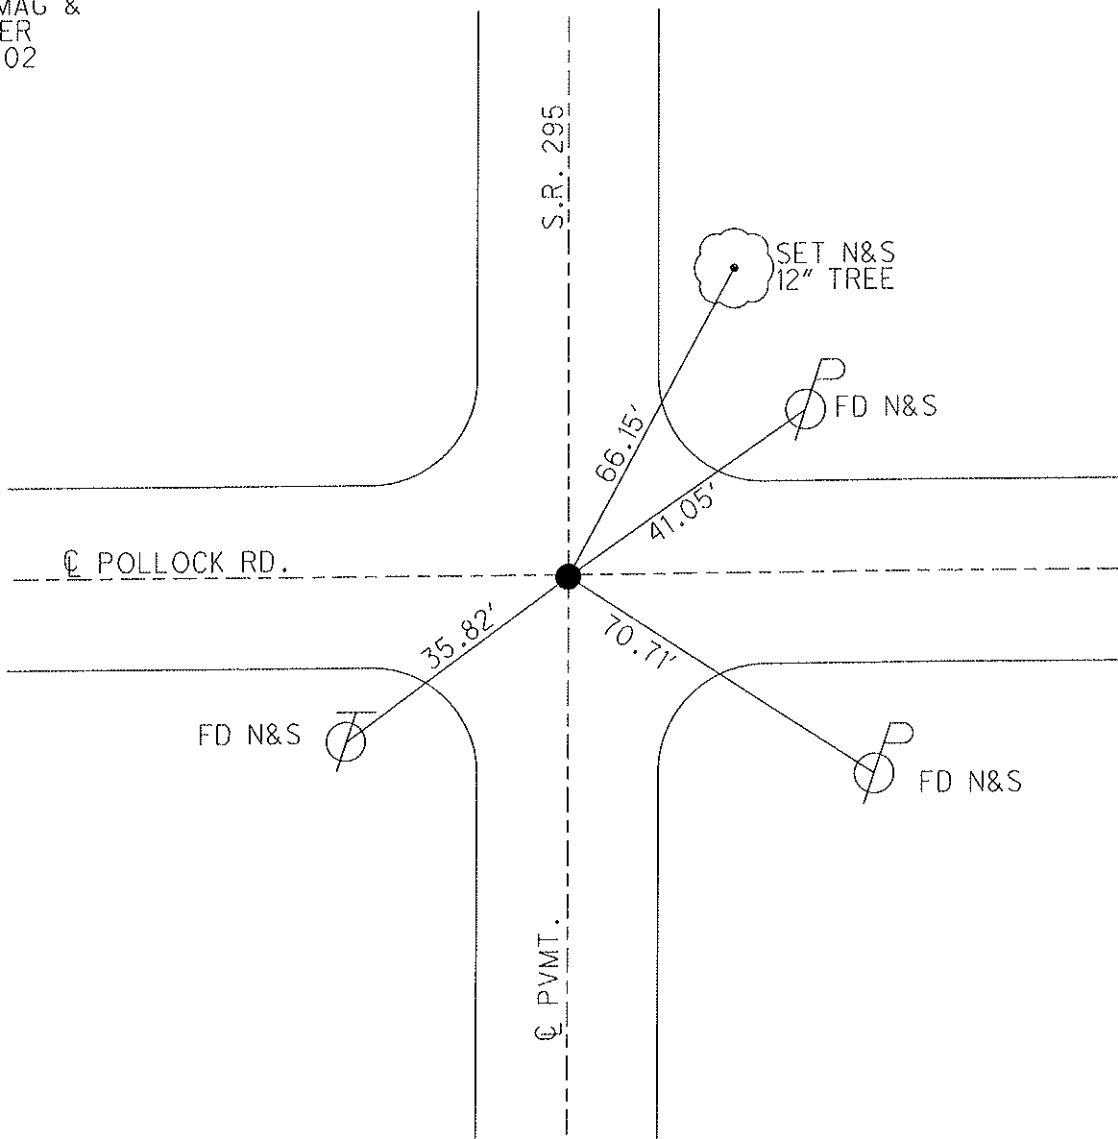

# O.D.O.T. DISTRICT 2 SURVEY OFFICE

PERSONNEL

REFERENCE NO. 3

SHEET 2 OF 35

NOTES LOEHRKE

H.C. CURTIS

R.C. LOEHRKE

DATE 8-15-91

WEATHER CLEAR

TEMP. +72

ROUTE S.R. 295

COUNTY LUCAS

TOWNSHIP PROVIDENCE

SECTION 33

T6 N R 9 E

TYPE MONUMENT Sm. R.R. Spike

ON SURFACE - BELOW YES


~~LEFT~~ - RIGHT PAV'T. - RIGHT YES

TO EDGE PAVEMENT

S.L.M. 34+70

Set P.K. Nail  
w/ WASHER  
3-24-92

28	27
33	34

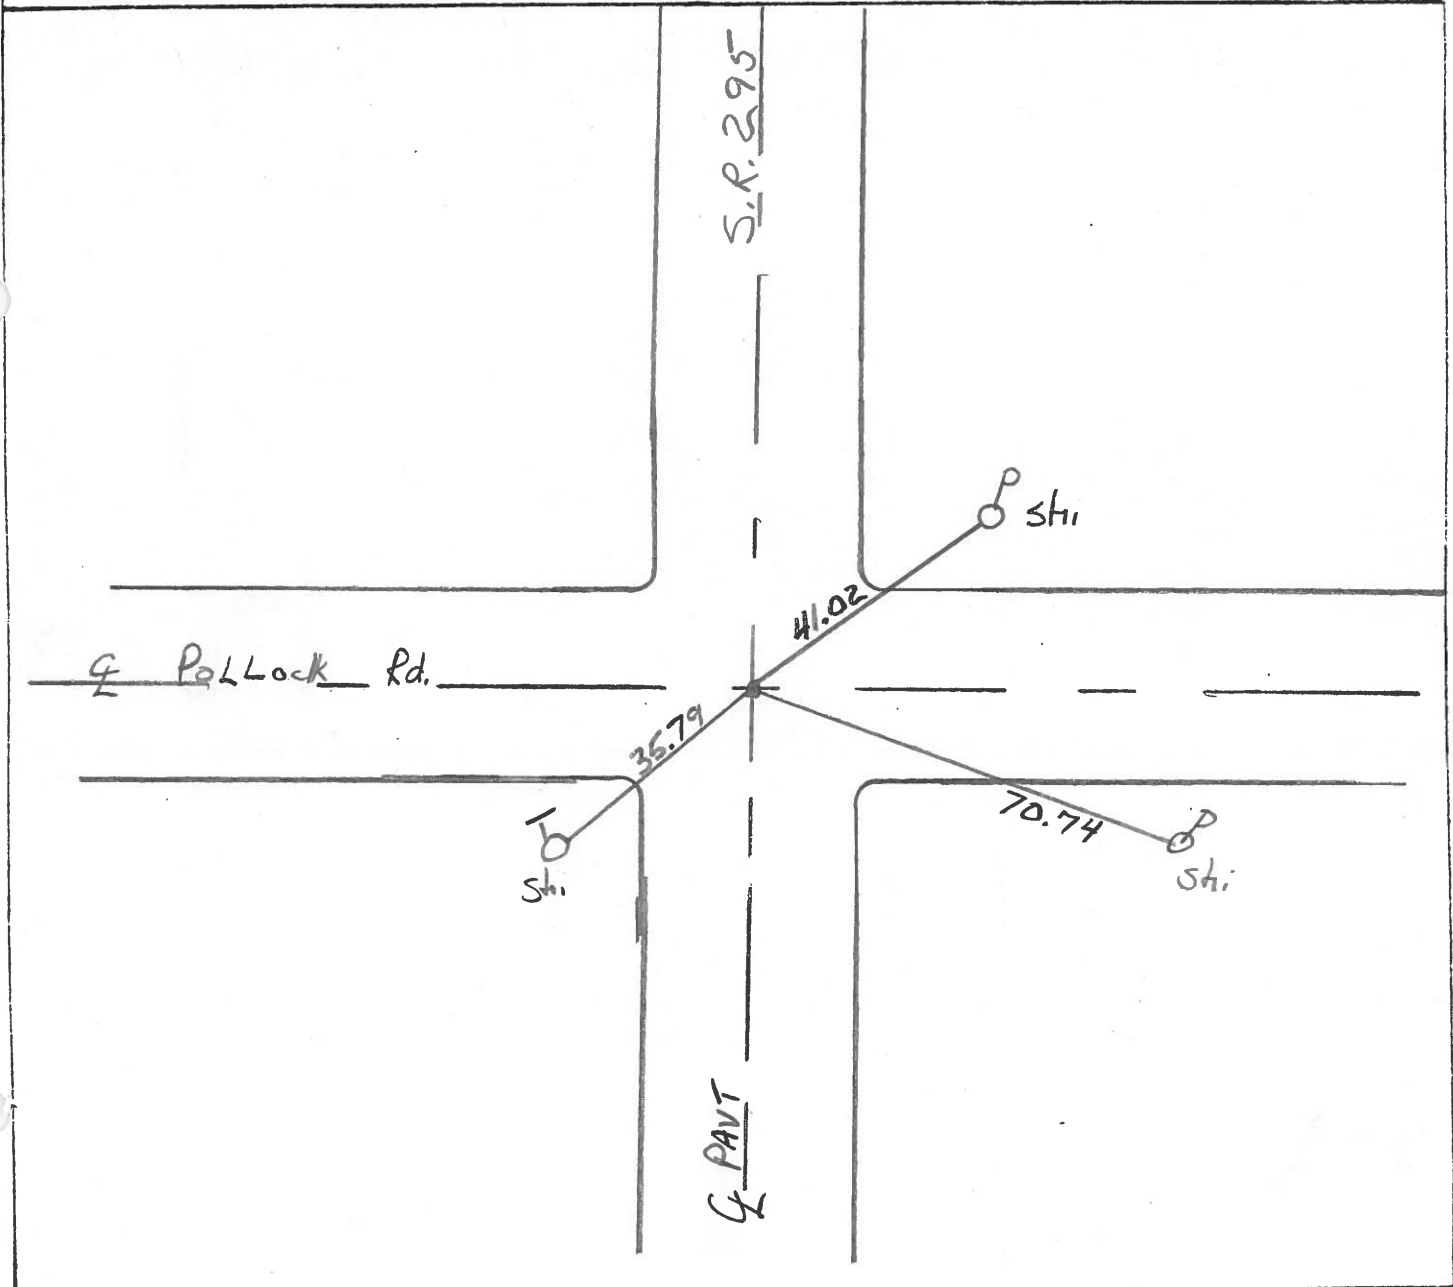

County Lucas S.R. 295

Township Providence

Section 27-28-33-34

T N, R E

Personnel 1. Stone

P. Neuser

D. Curtis

Date 3 April 84


Weather Cloudy

Temp. 45°

28	27
33	34




Ref. No. 3.

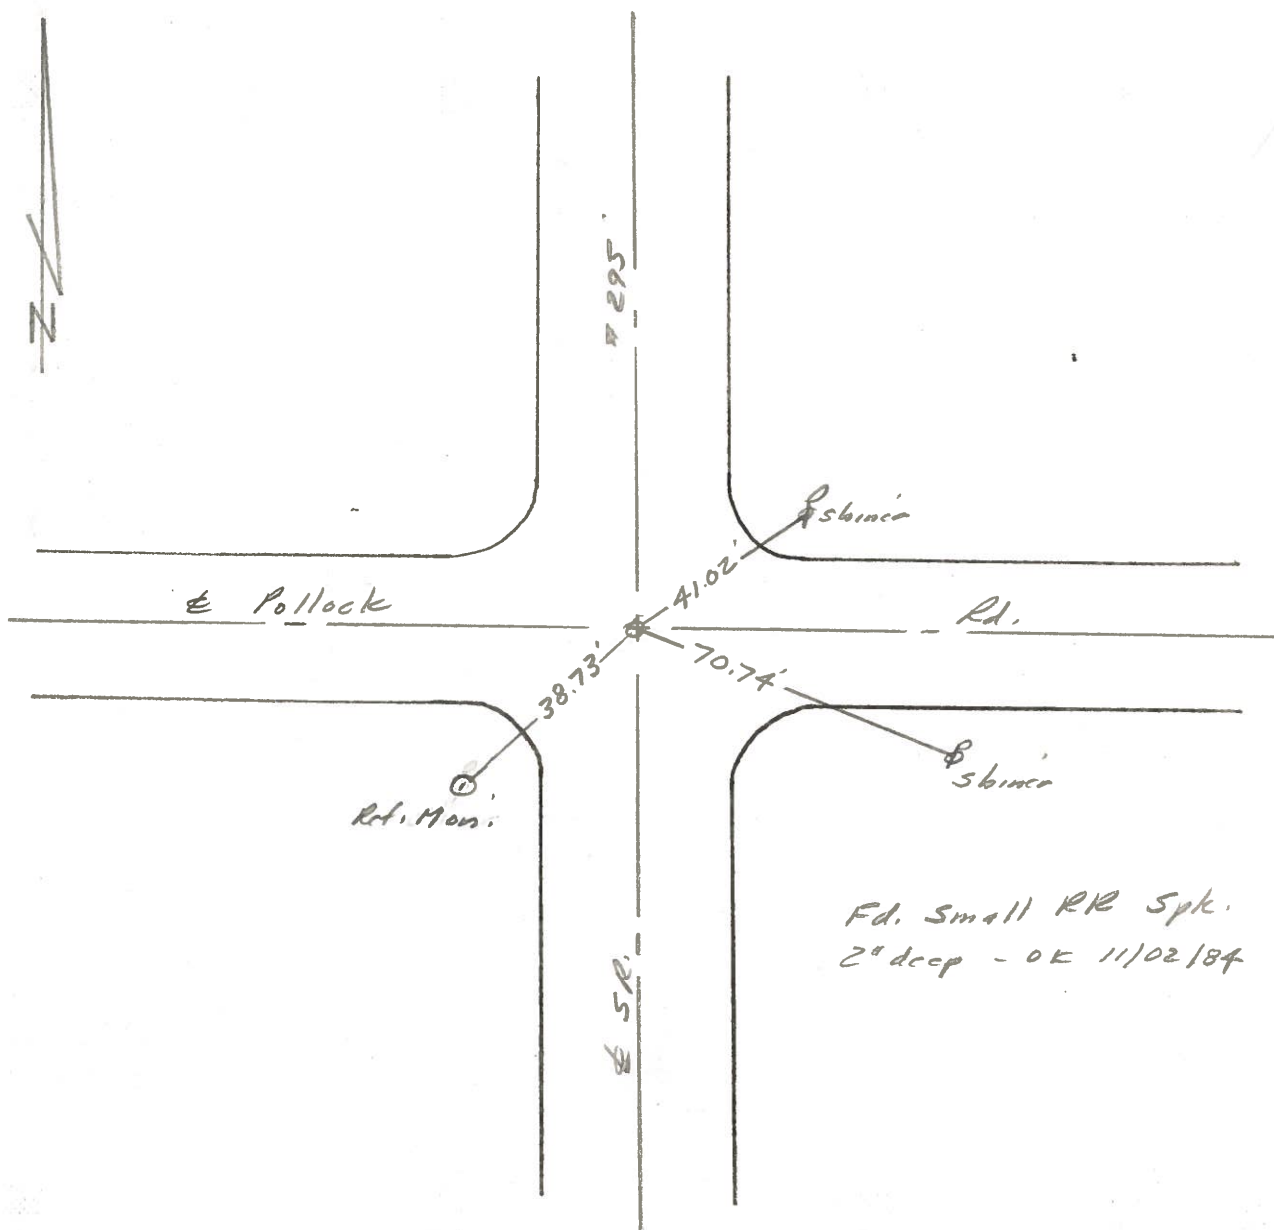

PERSONNEL	TITLE	PERSONNEL	TITLE	COUNTY	DATE	WEATHER	TEMP.
W. DENNO				LUCAS	JULY 13, 1971	CLOUDY	70±
D. CURTIS				S. R. #295			
D. STEVENS							
R. BRANNAN				SEC.			

DESCRIPTION	REFERENCES TO CONTROL POINTS	JOB NO.		
	LEFT	CENTER LINE	RIGHT	

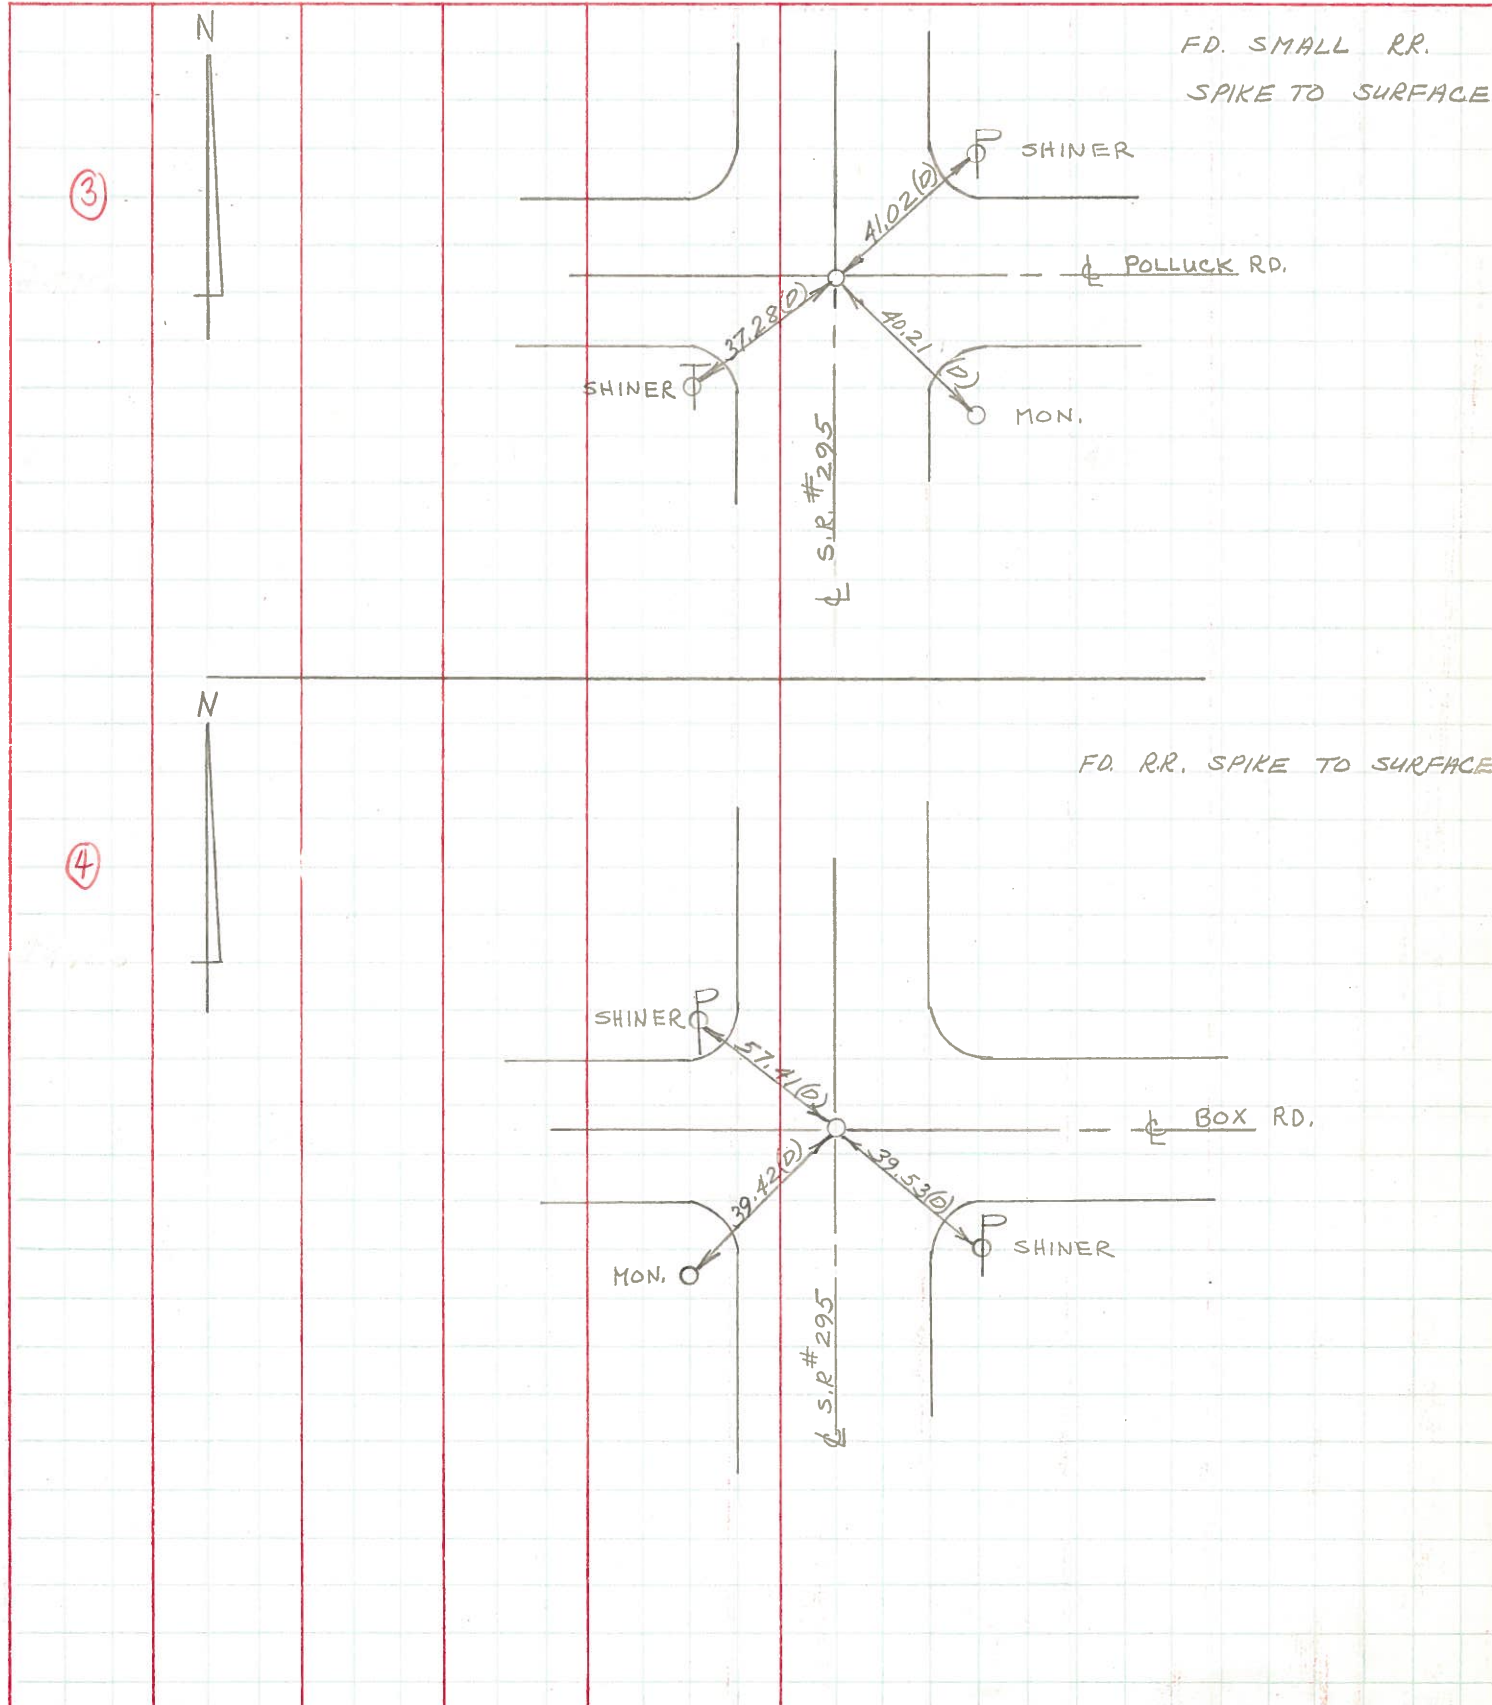

PERSONNEL	TITLE	PERSONNEL	TITLE	COUNTY	DATE
Stone	Notes			Lucas	6 June 68
Beck	Tape			S. R. # 295	WEATHER Hot
Michalale	Tape			SEC.	TEMP. 86°

DESCRIPTION References to control Points JOB NO. \_\_\_\_\_

