

O.D.O.T. DISTRICT 2 SURVEY OFFICE (USE ONLY)

PERSONNEL \_\_\_\_\_ REFERENCE NO. 10 SHEET 10 OF 45

NOTES AUBLE DATE 5-3-23 ROUTE SR 295

H.C. NIESE WEATHER WINDY COUNTY LUCAS

R.C. MILLER TEMP. 48° TOWNSHIP PROVIDENCE

DWG BY ASTON PID CHIP SEAL SECTION 15

TYPE MONUMENT MAG/WASHER

ON SURFACE - ~~BELOW~~ ON


OFFSET  $\varnothing$  PAVEMENT 5' LT : ~~RT~~

TO EDGE PAVEMENT

STATION: 297+75.45

HORZ.DATUM: NAD83(2011) GEOID: NAVD88 2018

GRID: NORTHING: 666412.988 EASTING: 1605084.271



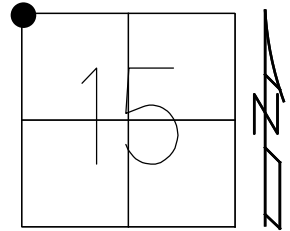


RECORD:  
 FD P.K.NAIL  
 8/29/02, DCH  
 SET MAG/WASHER  
 11/21/02, DCH  
 FD MAG NAIL  
 REF23  
 12/4/15, JLL  
 SET MAG/WASHER  
 7/17/17, DCH  
 FD MAG/WASHER  
 RE10  
 5-3-23, TDN  
 9-29-23, JAM

SET NOTCH  
 1' UP  
 SL 55 SIGN

LUCAS: LDP  
 N: 287405.655  
 E: 115682.910

FD "+"  
 CBS

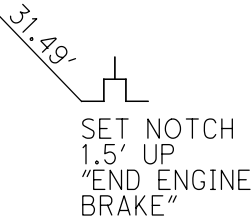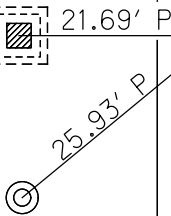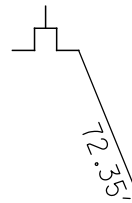


$\varnothing$  SR 295



O.D.O.T. DISTRICT 2 SURVEY OFFICE (USE ONLY)


PERSONNEL \_\_\_\_\_ REFERENCE NO. 10 SHEET 10 OF 45  
 NOTES HOMAN DATE 3/17/17 ROUTE SR 295  
 H.C. HOMAN WEATHER CLOUDY COUNTY LUCAS  
 R.C. HELDMAN TEMP. 33° TOWNSHIP PROVIDENCE  
 \_\_\_\_\_ SECTION 15  
 \_\_\_\_\_ T 6 N R 9 E

TYPE MONUMENT MAG NAIL  
 ON SURFACE - ~~BELOW~~ ON  
 LEFT - ☐ PAV'T - ~~RIGHT~~ 5'  
6.7' TOLT EDGE PAVEMENT  
 S.L.M. 324+32.46

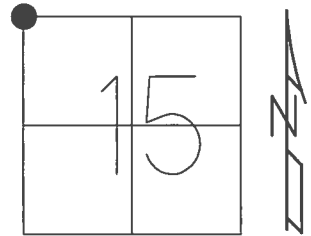

GRID: NORTHING: 666412.988 EASTING: 1605084.271

RECORD:  
 FD P.K.NAIL  
 8/29/02, DCH  
 SET MAG/WASHER  
 11/21/02, DCH  
 FD MAG NAIL  
 REF23  
 12/4/15, JLL  
 SET MAG/WASHER  
 7/17/17, DCH

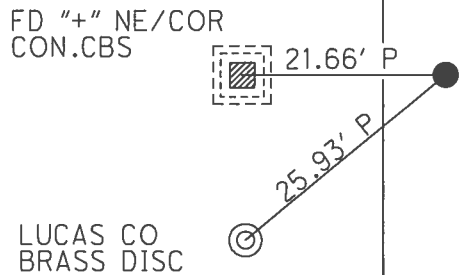

# O.D.O.T. DISTRICT 2 SURVEY OFFICE

PERSONNEL \_\_\_\_\_

REFERENCE NO. 10

SHEET 10 OF 45

NOTES BEAUMONT

DATE 8-29-02

ROUTE S.R. 295

H.C. HOMAN

WEATHER SUNNY

COUNTY LUCAS

R.C. BEAUMONT

TEMP. 79°

TOWNSHIP PROVIDENCE

SECTION 15

T 6 N R 9 E


TYPE MONUMENT P.K. NAIL

ON SURFACE - ~~BELOW~~ ON

LEFT - Q PAV'T - ~~RIGHT~~ 5'

6.7' TO LT EDGE PAVEMENT


S.L.M. 193+93

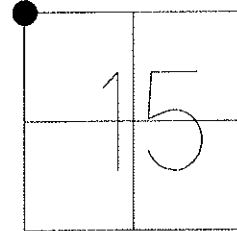

NOTE:  
1/2 MILE NORTH  
OF DORAN RD.


SET MAG &  
WASHER  
11-21-02  
DCH

S.W. CORNER  
CONC C.B.

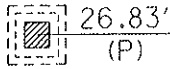


26.83'  
(P)

LUCAS CO.  
BRASS DISC

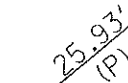

25.93'  
(P)

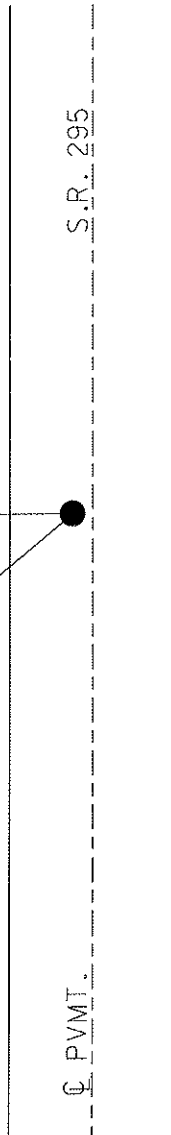

# O.D.O.T. DISTRICT 2 SURVEY OFFICE

PERSONNEL

REFERENCE NO. 10

SHEET 8 OF 35

NOTES LOEHRKE

H.C. STONE

R.C. CURTIS

DATE 8-17-91

WEATHER CLEAR

TEMP. +80

ROUTE S.R. 295

COUNTY LUCAS

TOWNSHIP PROVIDENCE

SECTION 15

T.L. N. R. 9 E

TYPE MONUMENT P.K. Nail


Set P.K./WASHER  
3-25-92

ON SURFACE - BELOW YES

LEFT - Q PAV'T. - RIGHT

5.0 TO LT EDGE PAVEMENT

S.L.M. 193+93

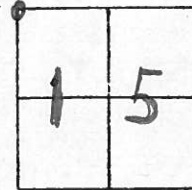

$\frac{1}{2}$  mile NORTH  
of DORAN Rd.

IRON Rod in  
Broken REF. Mon



F.B. 22.00

S.E. CORNER  
CONC. CATCH BASIN  
(NOT LID)

24.61

"+" TOP CENTER  
CONC. Hdwl.

Q PAVT

S.R. 295

O.D.O.T. DISTRICT 2 SURVEY OFFICE

SHEET \_\_\_\_\_ OF \_\_\_\_\_

County Lucas S.R. 295

Date 23 April 82

Township Providence

Weather Sunny

Section 9-10-15-16


Temp. 56°

T. N, R. E


Personnel I. Stone

R. Michalak

D. Curtis

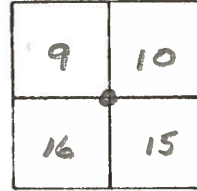

REF. No. 10

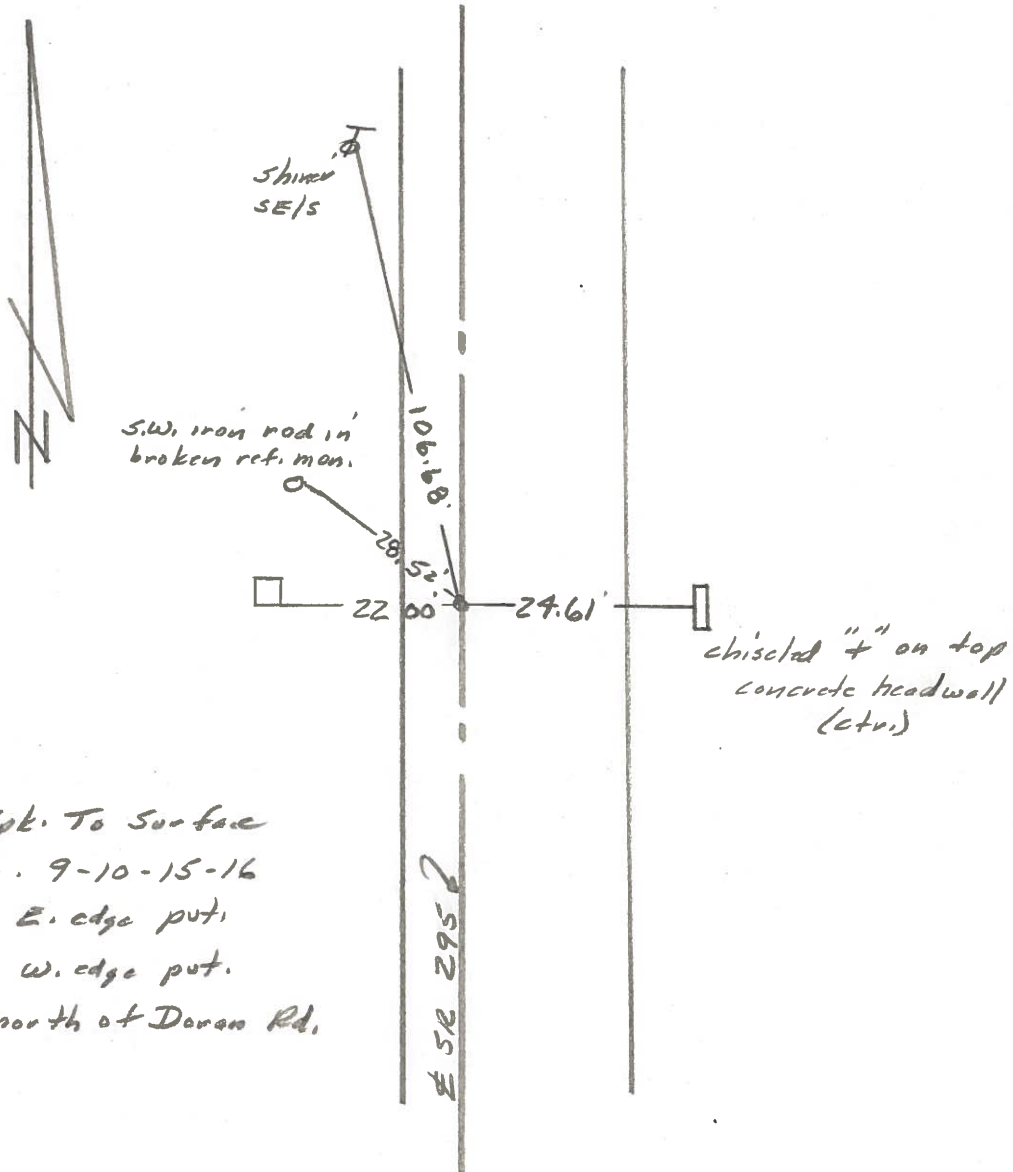

Fd. RR. Spk. To Surface  
 Sec. Cor. 9-10-15-16  
 13.2' to E. edge put.  
 5.0' to W. edge put.  
 1/2 mile north of Daran Rd.

PERSONNEL	TITLE	PERSONNEL	TITLE	COUNTY	DATE
Stone	Notes			Lucas	6 June 68
Beck	Tape			S. R. # 295	WEATHER Hot
Michalak	Tape			SEC.	TEMP. 88°

DESCRIPTION References to Control Points JOB NO. \_\_\_\_\_

LEFT CENTER LINE RIGHT

