


O.D.O.T. DISTRICT 2 SURVEY OFFICE (USE ONLY)

PERSONNEL _____ REFERENCE NO. 19 SHEET 22 OF 45


NOTES BEUAMONT DATE 9/3/02 ROUTE SR 295
 H.C. HOMAN WEATHER P CLOUDY COUNTY LUCAS
 R.C. BEAUMONT TEMP. 80° TOWNSHIP SWANTON
 _____ SECTION 33
 _____ T 7 N R 9 E

TYPE MONUMENT SQUARE RR SPIKE
 ON SURFACE - ~~BELOW~~ ON
 LEFT - CL PAV'T - ~~RIGHT~~ 8.0'
1.0' TO LT EDGE PAVEMENT
 S.L.M. 352+20

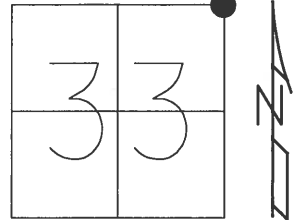

GRID: NORTHING: 681954.177 EASTING: 1605729.904

RECORD:
 SET MAG NAIL/WASHER
 11/25/02, DCH
 FD MAG NAIL
 REF41
 12/4/15, JLL
 FD MAG/WASHER
 REF19
 6/20/16, JFO
 UNCOVERED
 7/17/17, JFO

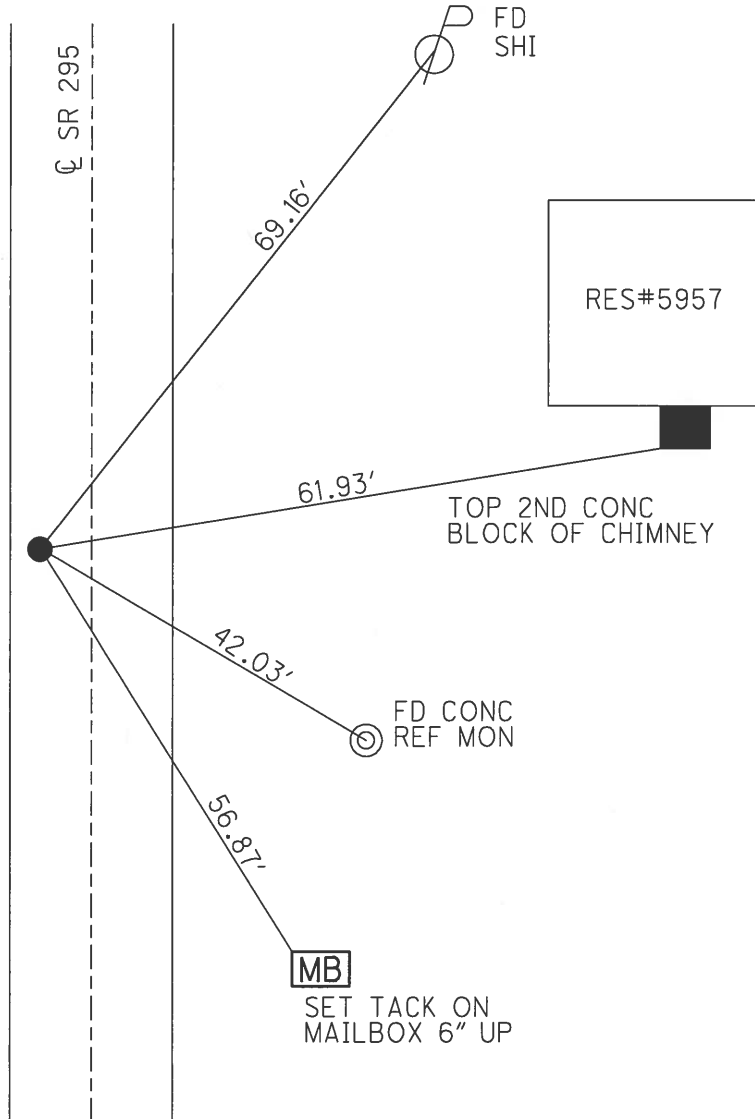

MB
 SET TACK ON
 MAILBOX 6" UP

O.D.O.T. DISTRICT 2 SURVEY OFFICE

PERSONNEL

REFERENCE NO. 19

SHEET 22 OF 45

NOTES BEAUMONT

DATE 9-3-02

ROUTE S.R. 295

H.C. HOMAN

WEATHER P. CLOUDY

COUNTY LUCAS

R.C. BEAUMONT

TEMP. 80°

TOWNSHIP SWANTON

SECTION 33

T. 7 N R. 9 E


TYPE MONUMENT SQUARE R.R. SPIKE

ON SURFACE - ~~BELOW~~ ON


LEFT - C PAV'T - ~~RIGHT~~ 8.0'

1.0 TO LT. EDGE PAVEMENT

S.L.M. 352+20

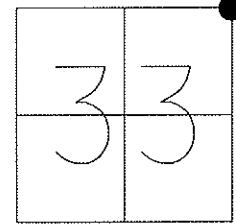

SET MAG NAIL
& WASHER
11-25-02
D.C.H.

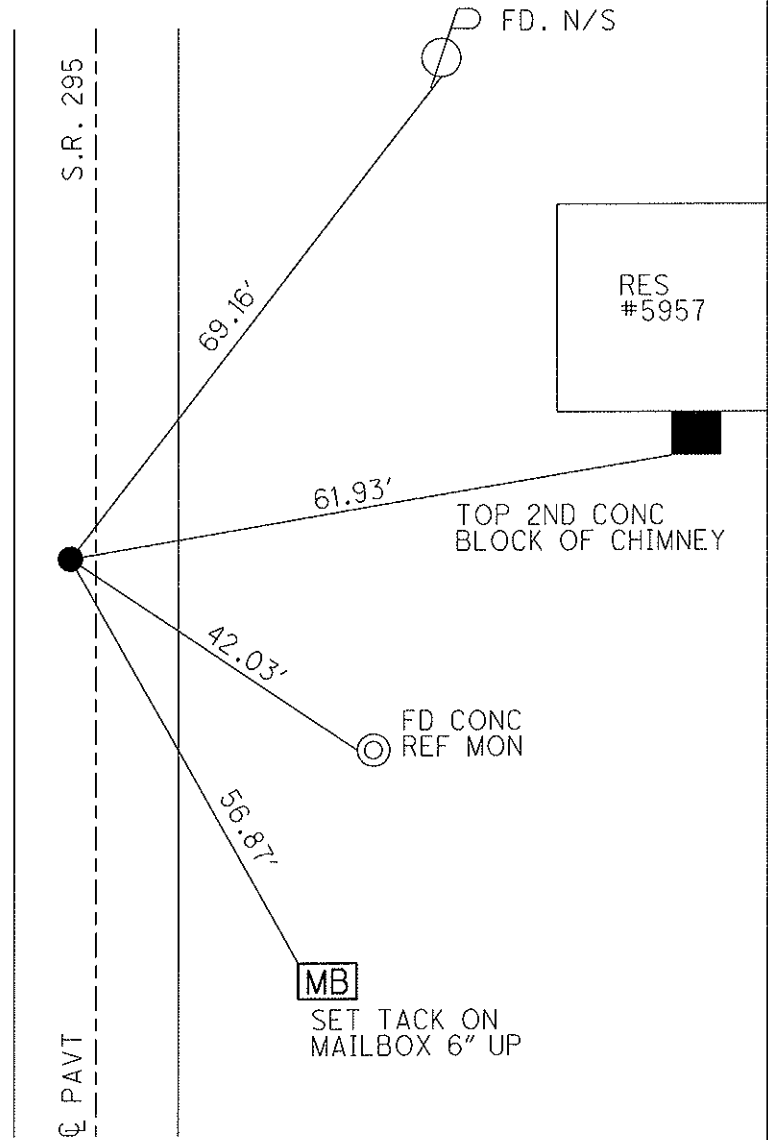

TOP 2ND CONC
BLOCK OF CHIMNEY

FD CONC
REF MON

MB
SET TACK ON
MAILBOX 6" UP

O.D.O.T. DISTRICT 2 SURVEY OFFICE

PERSONNEL

REFERENCE NO. 19

SHEET 10 OF 35

NOTES LOHRKE

H.C. CURTIS

R.C. LUCE

DATE 8-6-91

WEATHER CLOUDY

TEMP. +75

ROUTE S.R. 295

COUNTY LUCAS

TOWNSHIP SWANTON

SECTION 27

T 7 N R 9 E

TYPE MONUMENT Sq HEAD Spike

ON SURFACE - BELOW Yes


LEFT- & PAV'T. - RIGHT 8.0

I.O. TO Lt EDGE PAVEMENT

S.L.M. 352+20

P.K Nail
Set
As of
3-24-92

28	27
33	34

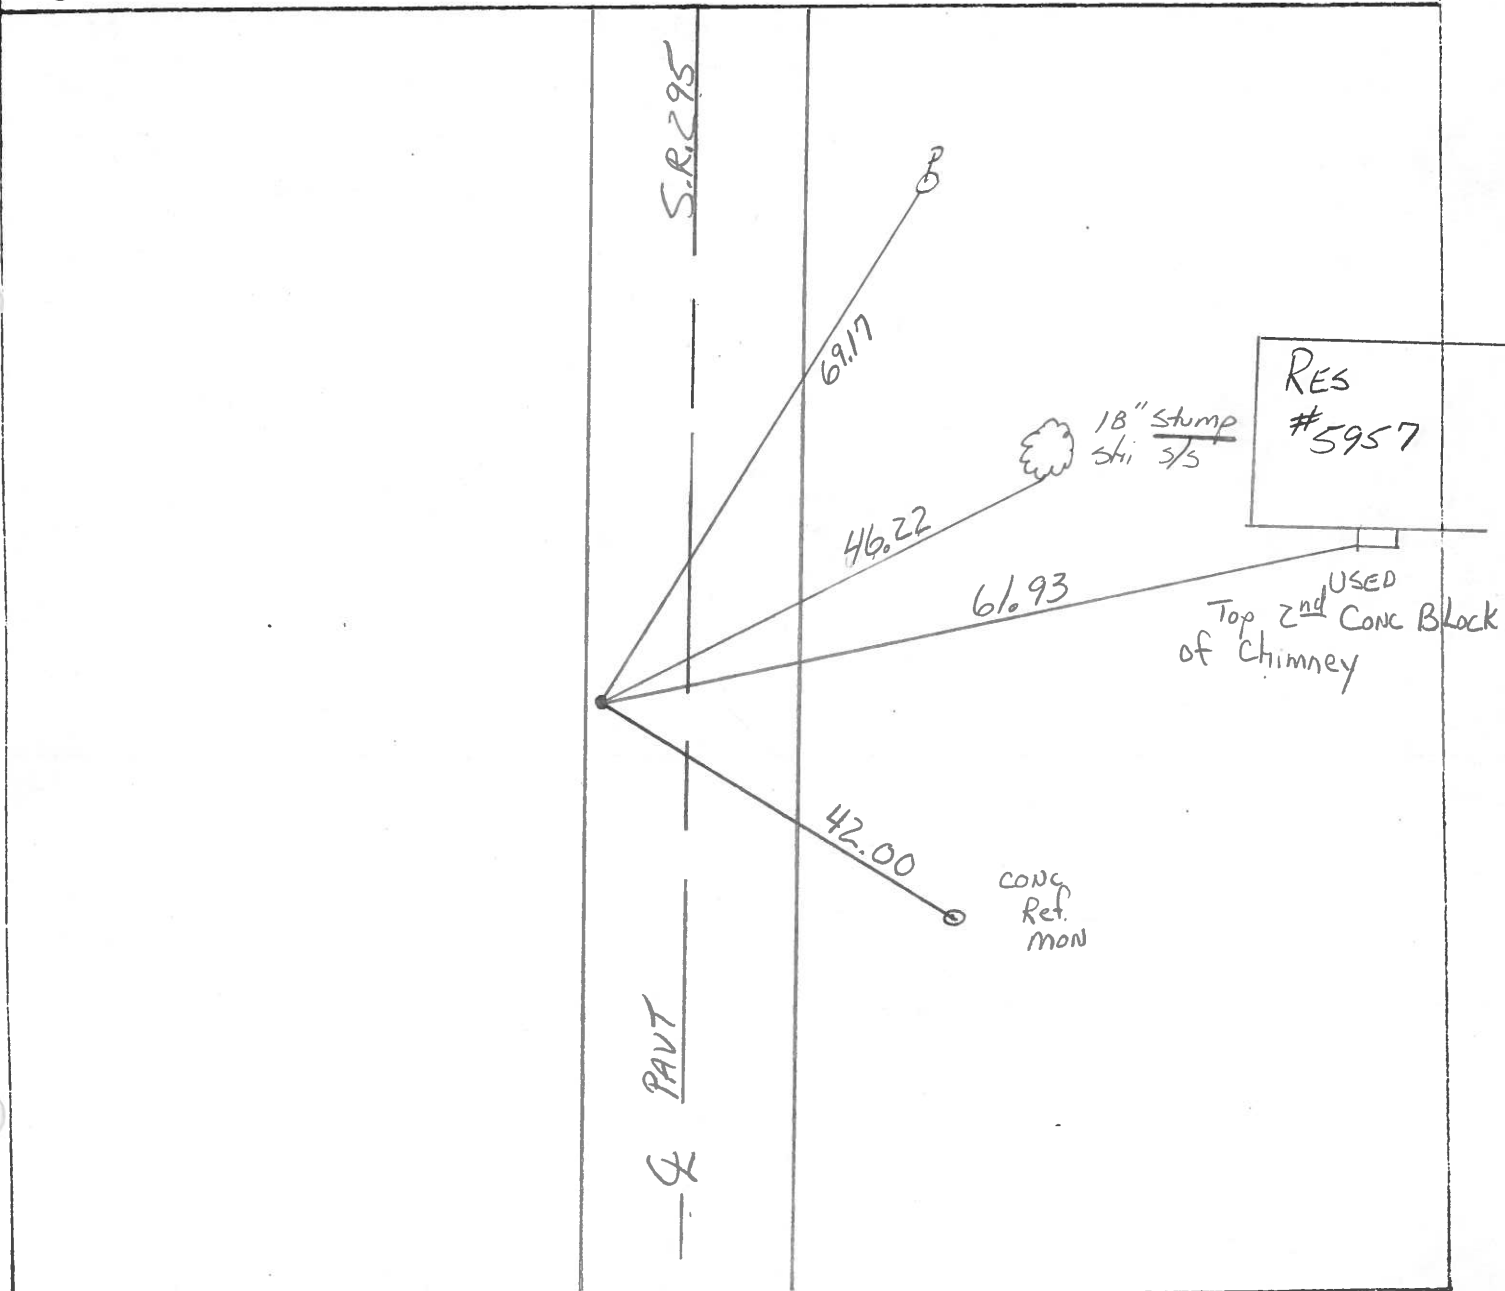

O.D.O.T. DISTRICT 2 SURVEY OFFICE

SHEET

OF

County Lucas S.R. 295

Date 26 April 82

Township Waterville

Weather Cloudy

Section 27-28-33-34

Temp. 60°

T N, R E

Personnel I. Stone

P. Newser

R. Michalak

28	27
33	34



REF. NO. 19



Shiner
SE15



E 5 R 295 S

Shiner SW15



69.18'

104.15'

41.95'

ref. mon.



Ed. PK Nail To Surface
 Sec. Cor. 27-28-33-34
 17.3' to E. edge pt.
 1.8' to W. edge pt.

PERSONNEL	TITLE	PERSONNEL	TITLE
Stone	Notes		
Beek	Flag		
Michalak	Tape		
Schroder	Tape		

COUNTY Lucas DATE 12 June 68
 S. R. #295 WEATHER Fair
 SEC. _____ TEMP. 74°

DESCRIPTION References to Control Points JOB NO. _____
 LEFT CENTER LINE RIGHT

