


O.D.O.T. DISTRICT 2 SURVEY OFFICE (USE ONLY)


PERSONNEL _____ REFERENCE NO. 24 SHEET 33 OF 45
 NOTES HOMAN DATE 9/9/02 ROUTE SR 295
 H.C. HOMAN WEATHER SUNNY COUNTY LUCAS
 R.C. BROWN TEMP. 85° TOWNSHIP SWANTON
 _____ SECTION 22
 _____ T 7 N R 9 E

TYPE MONUMENT P.K. NAIL
~~ON SURFACE~~ - BELOW 3"
 LEFT - ☉ PAV'T - RIGHT ON
11' TO LT EDGE PAVEMENT
 S.L.M. 419+25

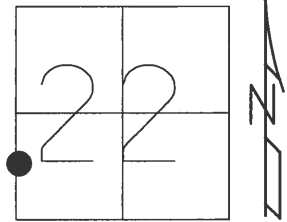

GRID: NORTHING: 688658.211 EASTING: 1605864.738

RECORD:
 SET MAG/WASHER
 11/26/02, DCH
 FD MAG/WASHER
 REF24
 6/20/16, JFO
 UNCOVERED
 7/17/17, JFO

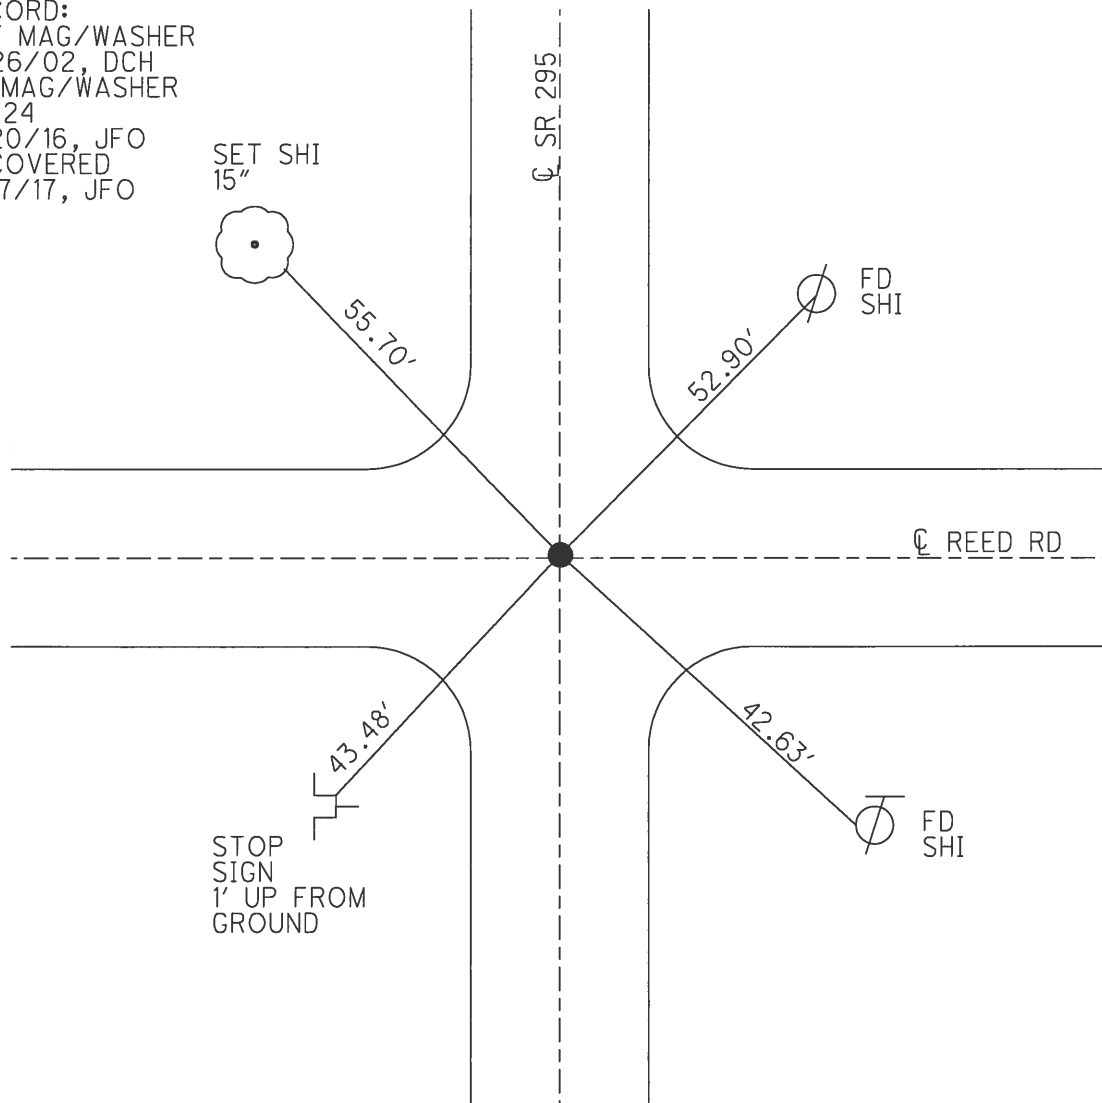

O.D.O.T. DISTRICT 2 SURVEY OFFICE

PERSONNEL

REFERENCE NO. 24

SHEET 33 OF 45

NOTES HOMAN

DATE 9-9-02

ROUTE S.R. 295

H.C. HOMAN

WEATHER SUNNY

COUNTY LUCAS

R.C. BROWN

TEMP. 85°

TOWNSHIP SWANTON

SECTION 22

T 7 N R 9 E


TYPE MONUMENT P.K. NAIL

~~ON SURFACE~~ - BELOW 3"


LEFT - ☉ PAV'T - RIGHT ON

11' TO LT. EDGE PAVEMENT

S.L.M. 419+25

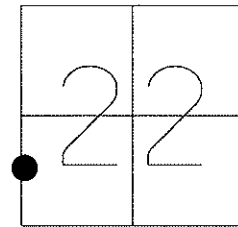

SET MAG/WASHER
DCH, 11-26-02

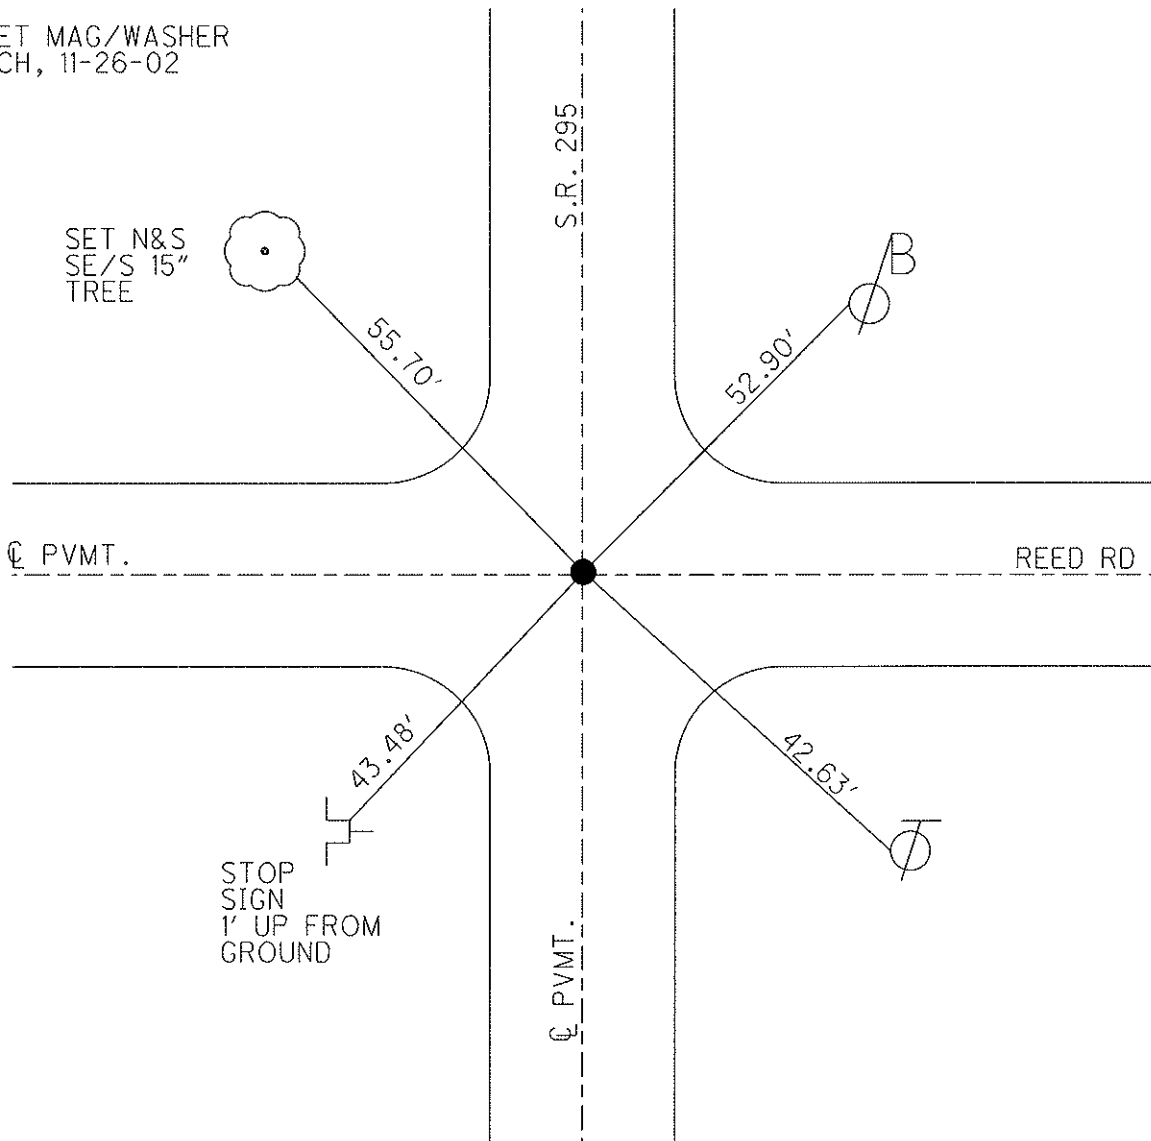

O.D.O.T. DISTRICT 2 SURVEY OFFICE

PERSONNEL _____

REFERENCE NO. 24-11

SHEET 25 OF 35

NOTES LOEHKE

H.C. CURTIS

DATE 8-5-91

ROUTE S.R. 295

R.C. Luce

WEATHER Clear

COUNTY LUCAS

TEMP. +72

TOWNSHIP SWANTON

SECTION 22

T. 7 N R. 9 E

TYPE MONUMENT P.K. Nail. 3" + P.K. WASHER



ON SURFACE - ~~BELOW~~ YES

3-25-92

~~LEFT~~ - C. PAVT. - RIGHT YES

9.0 TO RT EDGE PAVEMENT

S.L.M. 419+25

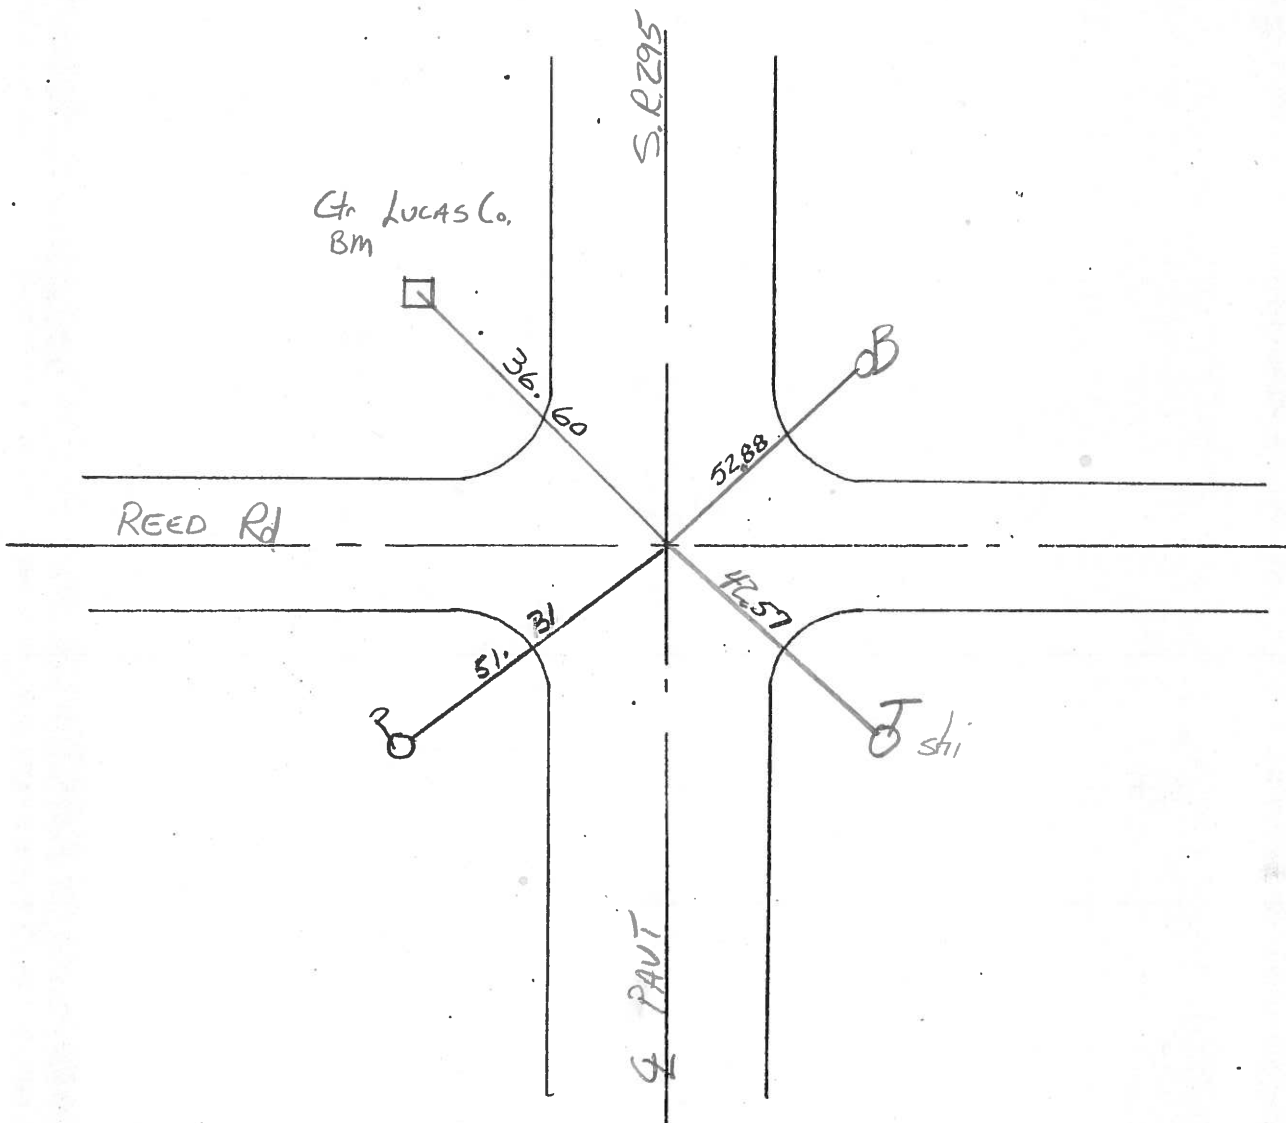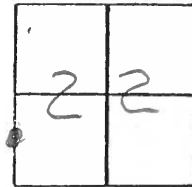

County Lucas S. R. 295

Township Swanston

Section 22

T, N, R, E

Personnel 1. Stone

P. Newser

R. Michalake


Date 27 April 82

Weather Cool

Temp. 42°



REF. NO. 24

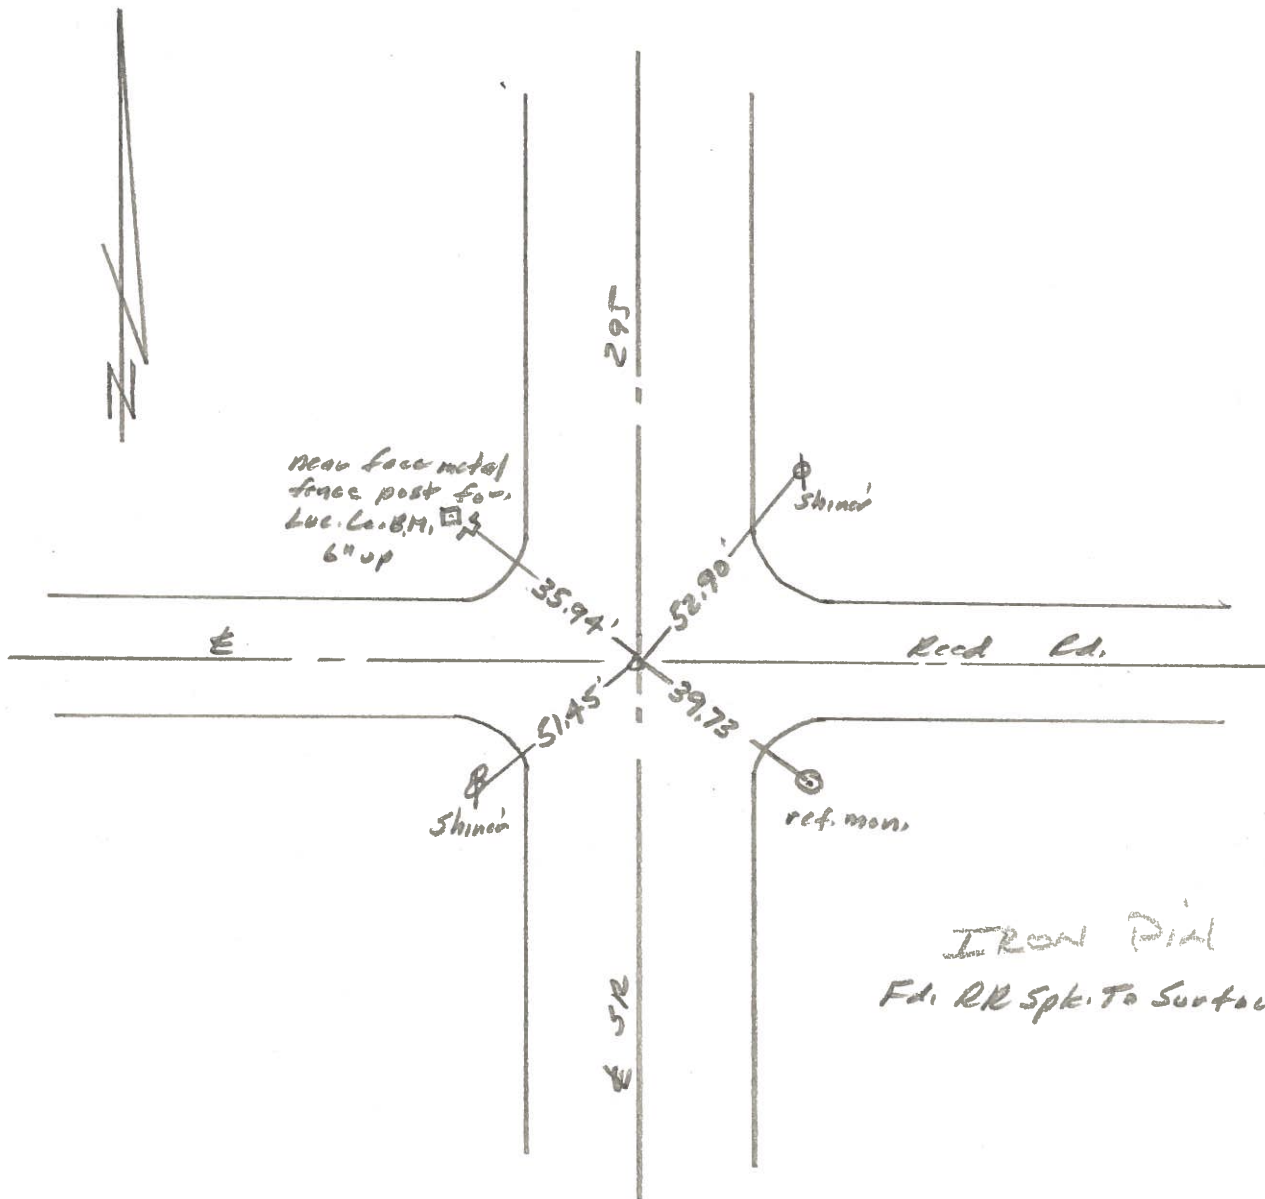


IRON PIAL
Fd. RR Spk. To Surface

PERSONNEL	TITLE	PERSONNEL	TITLE	COUNTY	DATE
Stone	Notes			Locust	12 June 68
Beck	Flag			S. R. # 295	WEATHER Fair
Michalak	Tape				TEMP. 76°
Schroder	Tape			SEC.	

DESCRIPTION References to Control Points JOB NO. _____

LEFT CENTER LINE RIGHT

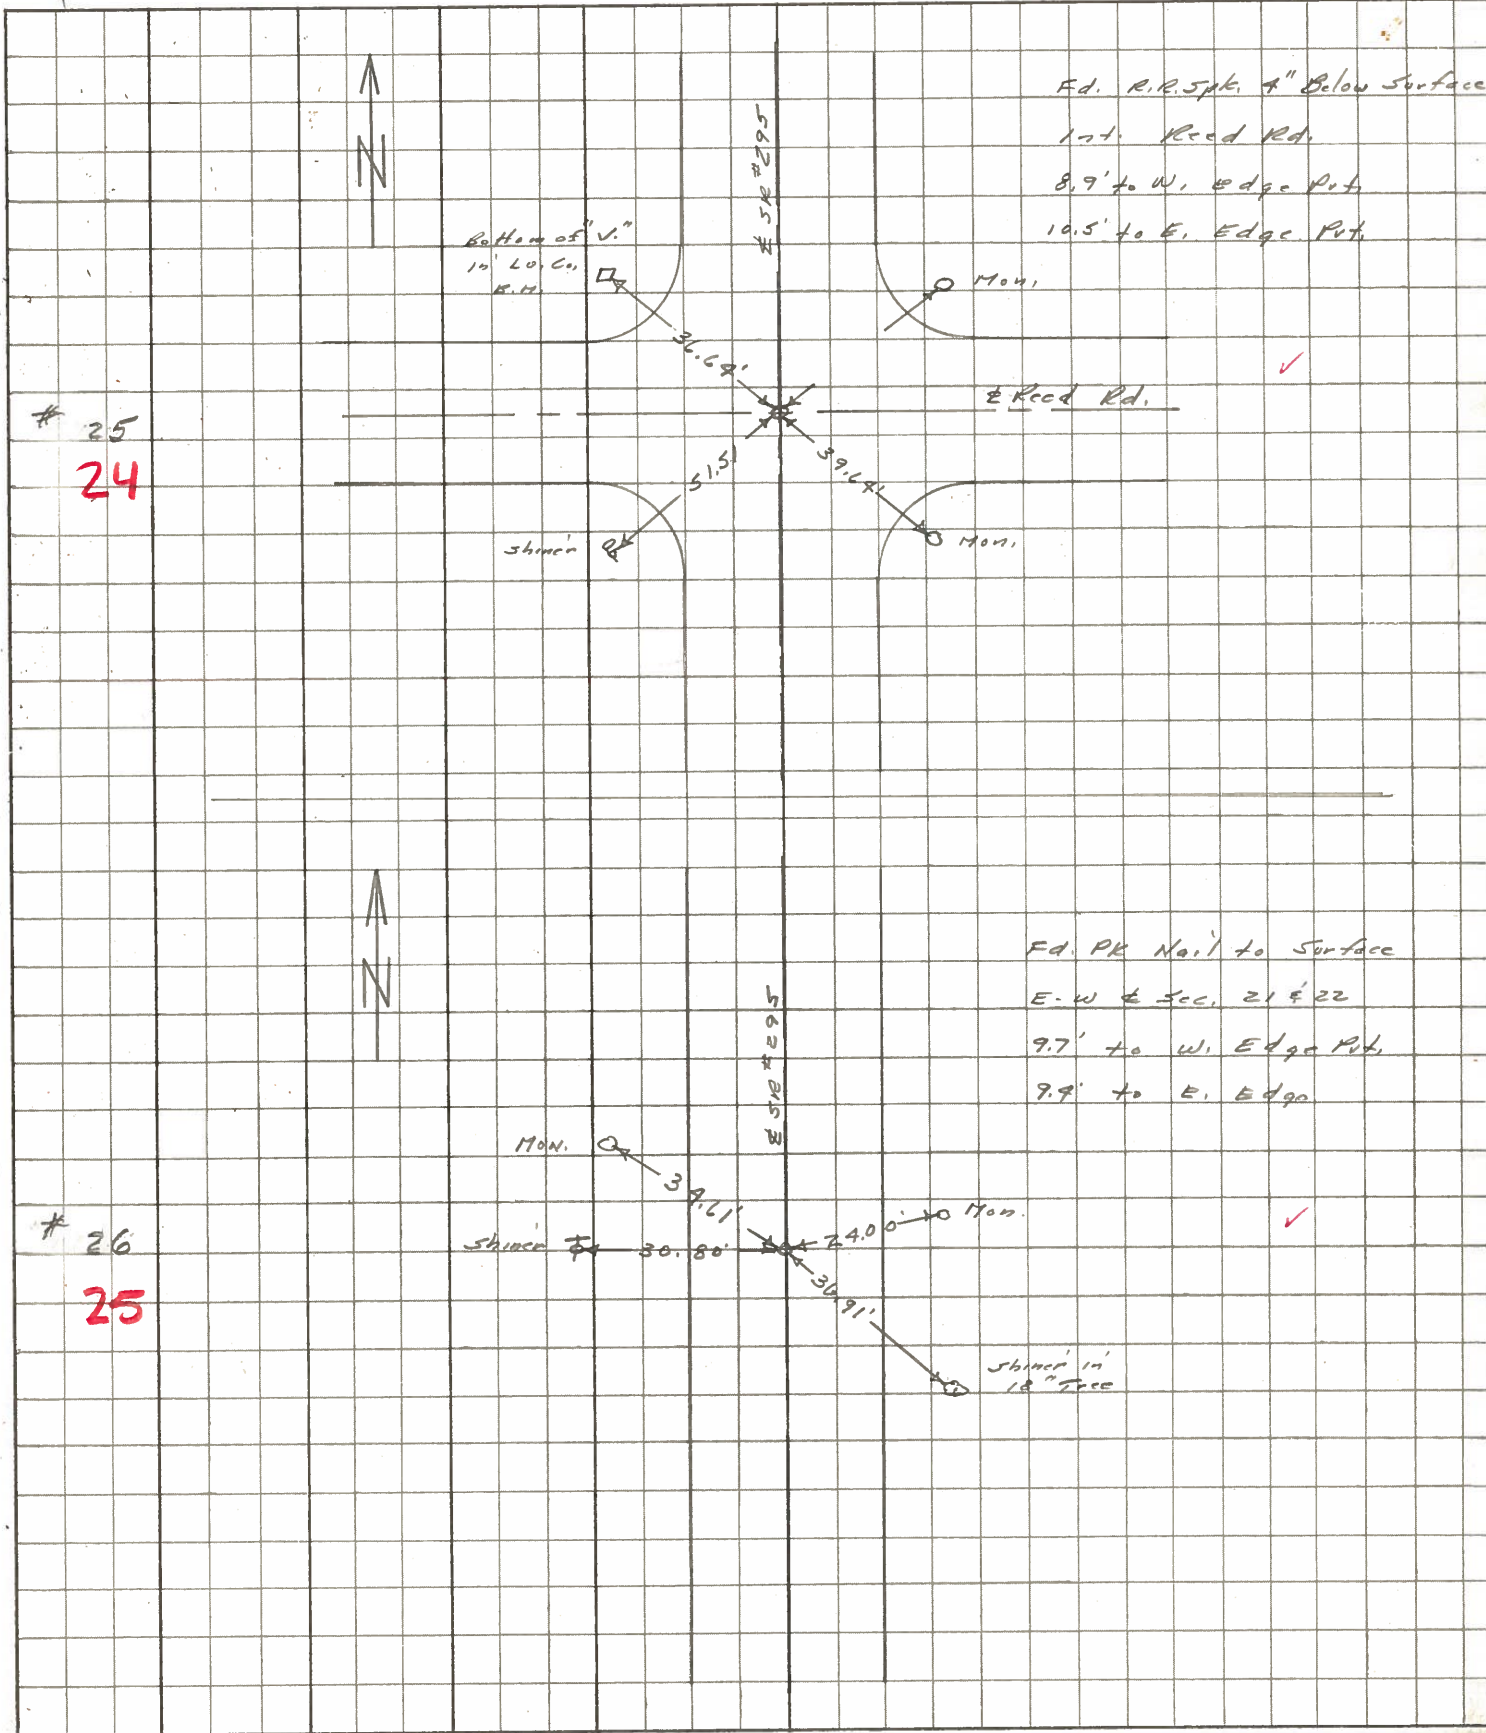

25
24

26
25