



O.D.O.T. DISTRICT 2 SURVEY OFFICE (USE ONLY)

PERSONNEL _____ REFERENCE NO. 25 SHEET 37 OF 45
 NOTES HOMAN DATE 9/9/02 ROUTE SR 295
 H.C. HOMAN WEATHER SUNNY COUNTY LUCAS
 R.C. BROWN TEMP. 90° TOWNSHIP SWANTON
 _____ SECTION 22
 _____ T 7 N R 9 E

TYPE MONUMENT P.K. NAIL
 ON SURFACE - ~~BELOW~~ _____ ON _____
~~LEFT~~ - ☉ PAV'T - RIGHT 1.5'
11' TO LT EDGE PAVEMENT
 S.L.M. 432+54

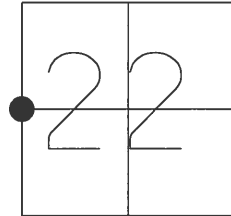

GRID: NORTHING: 689986.352 EASTING: 1605876.833

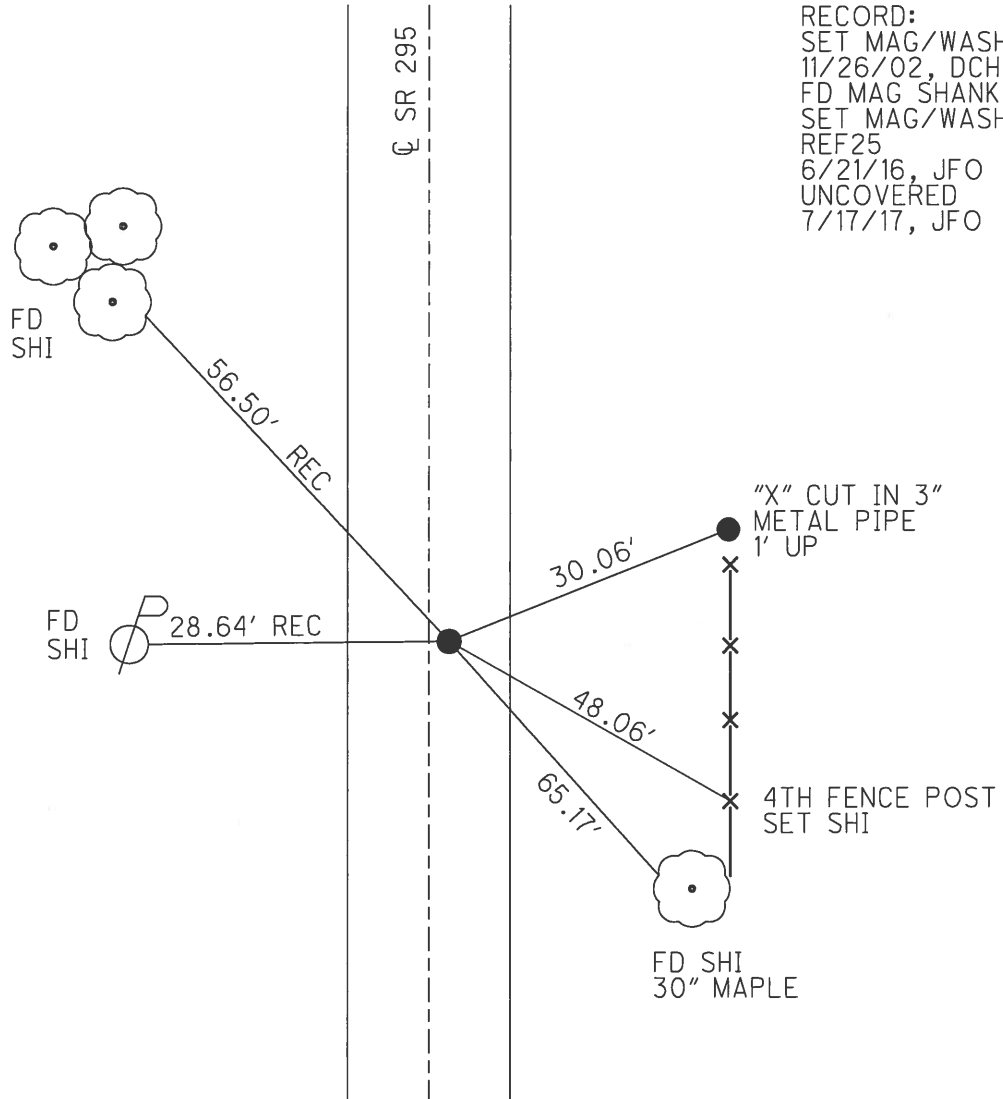

RECORD:
 SET MAG/WASHER
 11/26/02, DCH
 FD MAG SHANK
 SET MAG/WASHER
 REF25
 6/21/16, JFO
 UNCOVERED
 7/17/17, JFO

O.D.O.T. DISTRICT 2 SURVEY OFFICE

PERSONNEL _____

REFERENCE NO. 25

SHEET 37 OF 45

NOTES HOMAN

DATE 9-9-02

ROUTE S.R. 295

H.C. HOMAN

WEATHER SUNNY

COUNTY LUCAS

R.C. BROWN

TEMP. 90°

TOWNSHIP SWANTON

SECTION 22

T 7 N R 9 E



TYPE MONUMENT PK NAIL

ON SURFACE - ~~BELOW~~ ON


~~LEFT~~ - Q PAV'T - RIGHT .5'

.11' TO LT EDGE PAVEMENT

S.L.M. 432+54

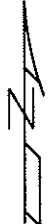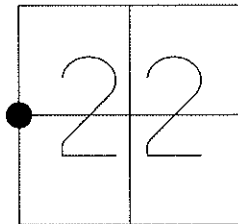

SET MAG/WASHER
DCH, 11-26-02

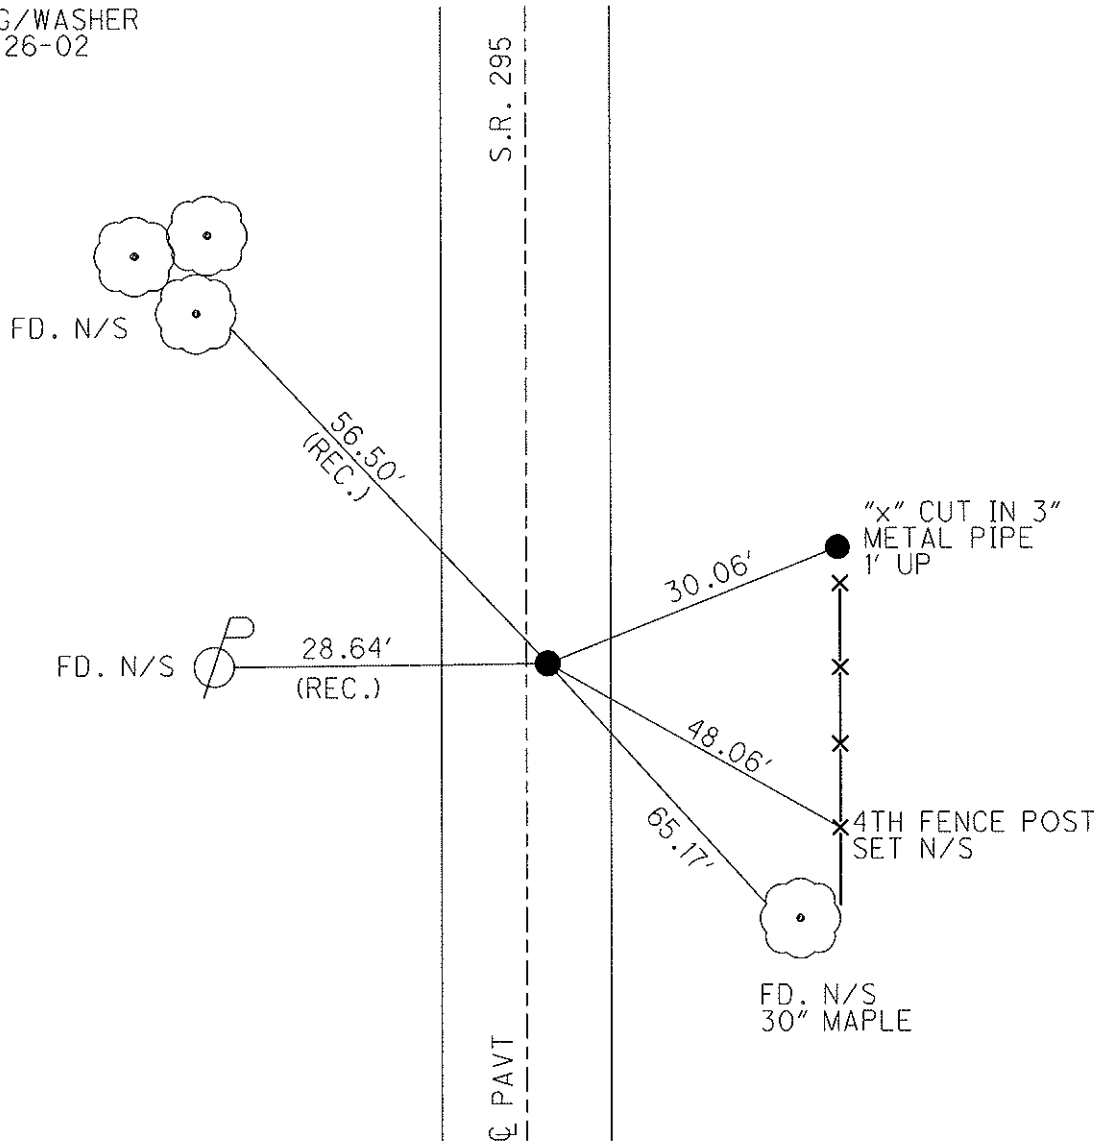

O.D.O.T. DISTRICT 2 SURVEY OFFICE

PERSONNEL _____

REFERENCE NO. 25

SHEET 29 OF 35

NOTES LOHRKE

H.C. Curtis

R.C. Luce

DATE 8-5-91

WEATHER Clear

TEMP. +70

ROUTE S.R. 295

COUNTY LUCAS

TOWNSHIP SWANTON

SECTION 22



T 7 N R 9 E

TYPE MONUMENT 1/4" IRON Rod Set P.K. / WASHER
ON SURFACE - ~~BELOW~~ 1/2" 3-25-92

~~LEFT - & PAV'T. - RIGHT~~

9.8 TO LT EDGE PAVEMENT

S.L.M. 432+54

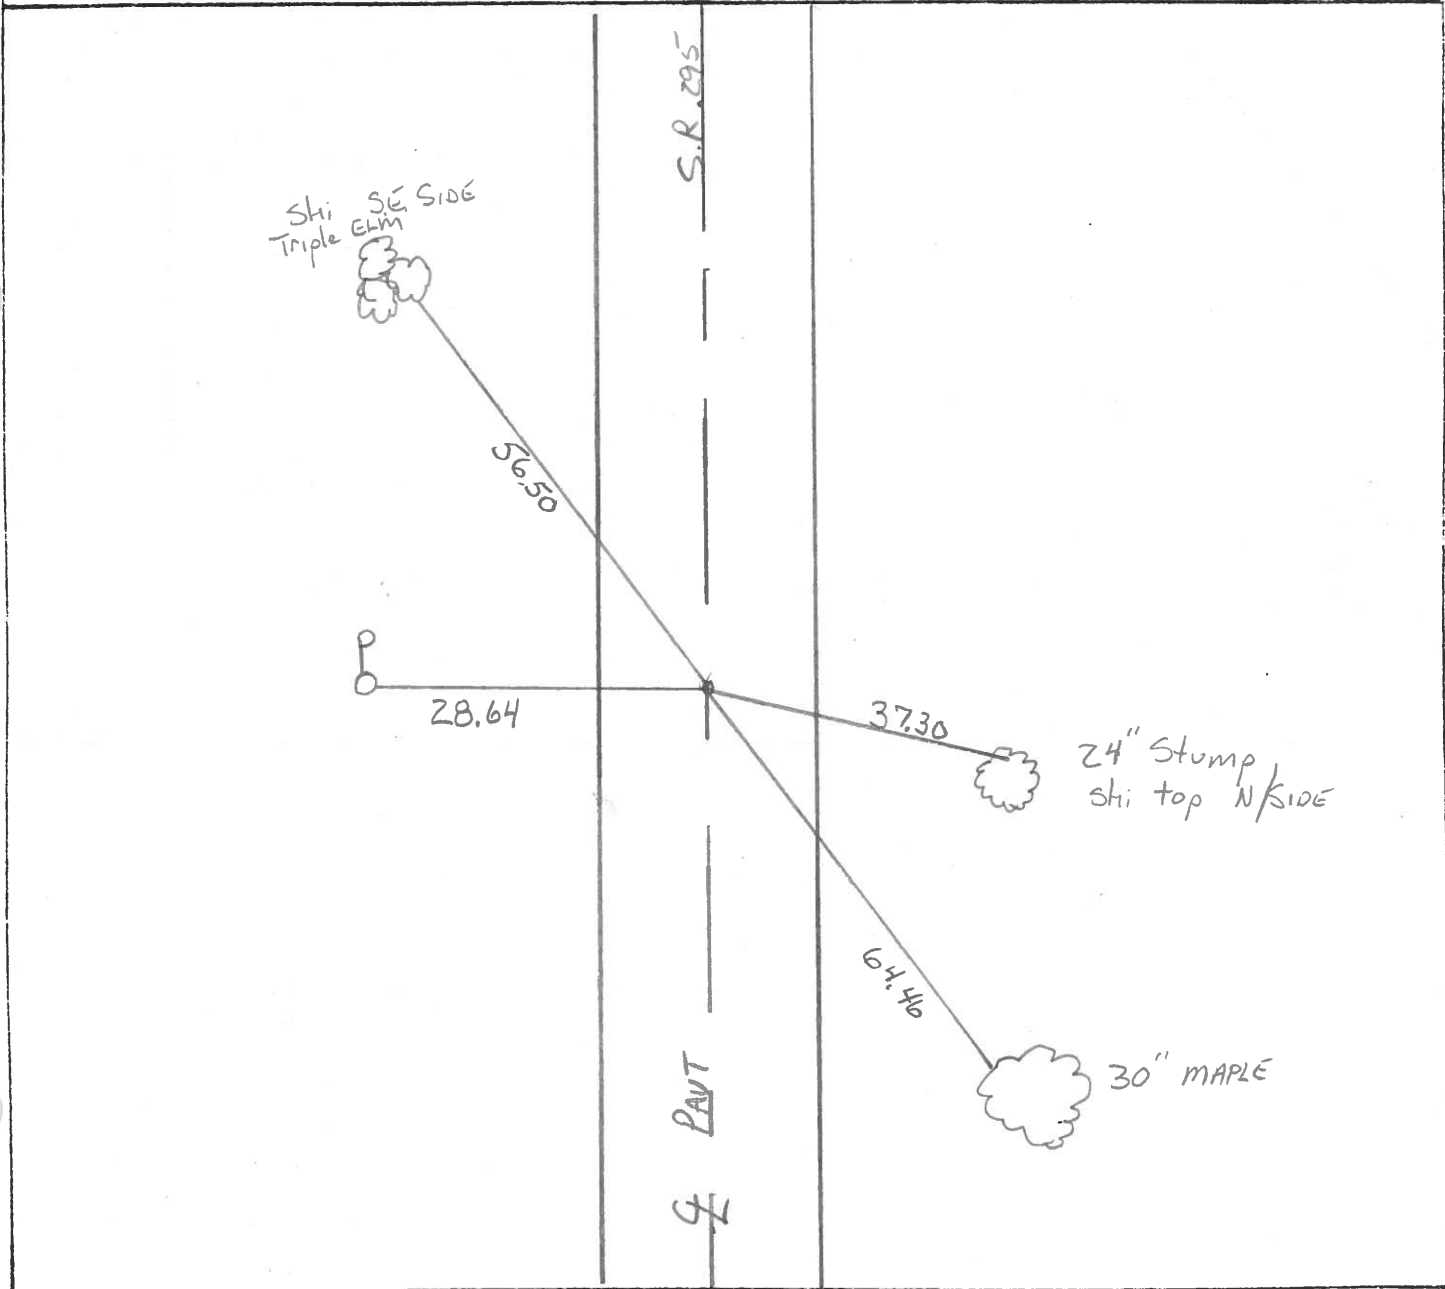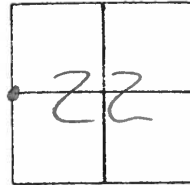

County Lucas S.R. 295

Date 27 April 82

Township Swanton

Weather Cool

Section 21-22


Temp. 45°

T, N, R, E


Personnel I. Stone

P. Newson

R. Michalak

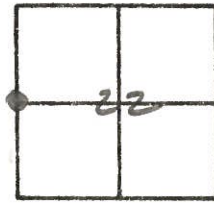

REF. NO. 25

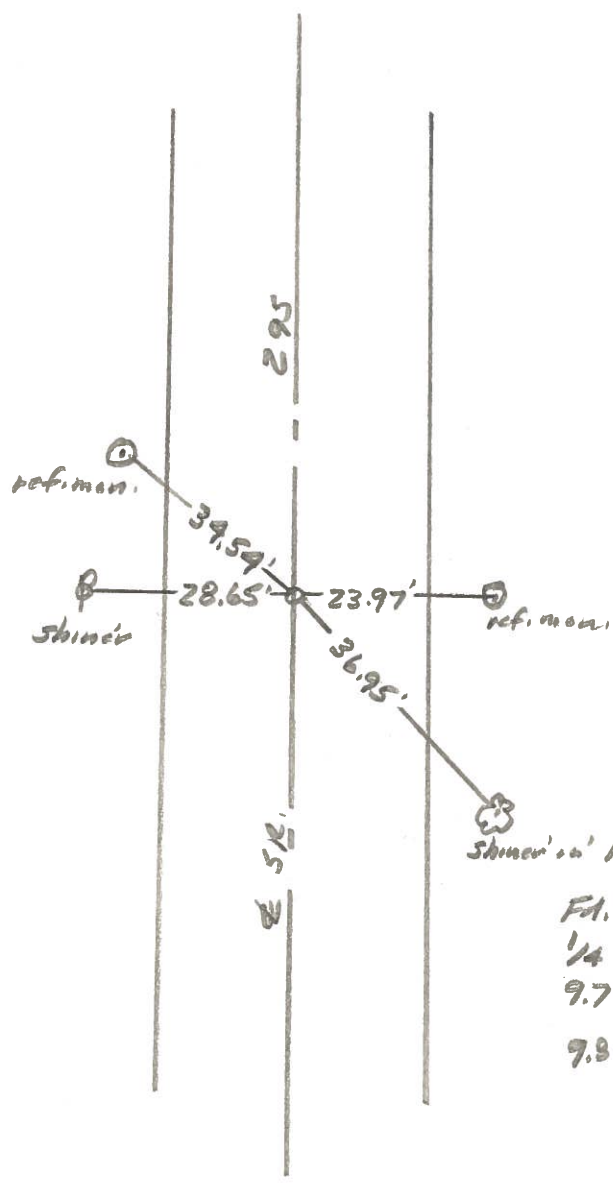

Shiner's 18" Tree

Ft. 1/4" I. pin 1" deep
 1/4 Cor. Sec. 21-22
 9.7' To W. edge put.
 9.8' To E. edge put.

PERSONNEL	TITLE	PERSONNEL	TITLE	COUNTY	DATE
Stone	Notes			Locust	12 Feb 68
Beck	Flag			S. R. # 295	WEATHER Fair
Michalak	Tape			SEC.	TEMP. 76°
Schroder	Tape				

DESCRIPTION References to Control Points JOB NO. _____

