


O.D.O.T. DISTRICT 2 SURVEY OFFICE (USE ONLY)


|           |               |             |               |           |                |           |
|-----------|---------------|-------------|---------------|-----------|----------------|-----------|
| PERSONNEL | REFERENCE NO. | <u>28 B</u> | SHEET         | <u>44</u> | OF             | <u>45</u> |
| NOTES     | <u>BROWN</u>  | DATE        | <u>9/9/02</u> | ROUTE     | <u>SR 295</u>  |           |
| H.C.      | <u>HOMAN</u>  | WEATHER     | <u>SUNNY</u>  | COUNTY    | <u>LUCAS</u>   |           |
| R.C.      | <u>BROWN</u>  | TEMP.       | <u>87°</u>    | TOWNSHIP  | <u>SWANTON</u> |           |
|           |               |             |               | SECTION   | <u>15</u>      |           |
|           |               |             |               | T         | <u>7</u>       | N         |
|           |               |             |               | R         | <u>9</u>       | E         |

TYPE MONUMENT P.K. SHANK  
 ON SURFACE - ~~BELOW~~ ON  
 LEFT - CL PAV'T - ~~RIGHT~~ 1'  
10' TO LT EDGE PAVEMENT  
 S.L.M. 498+68

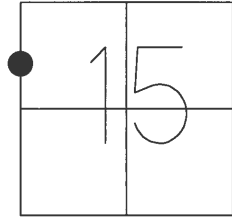

GRID: NORTHING: 696599.838 EASTING: 1605955.365

RECORD:  
 SET MAG/WASHER  
 11/26/02, DCH  
 FD MAG/WASHER  
 REFB28  
 6/22/16, JFO  
 UNCOVERED  
 7/27/17, JFO

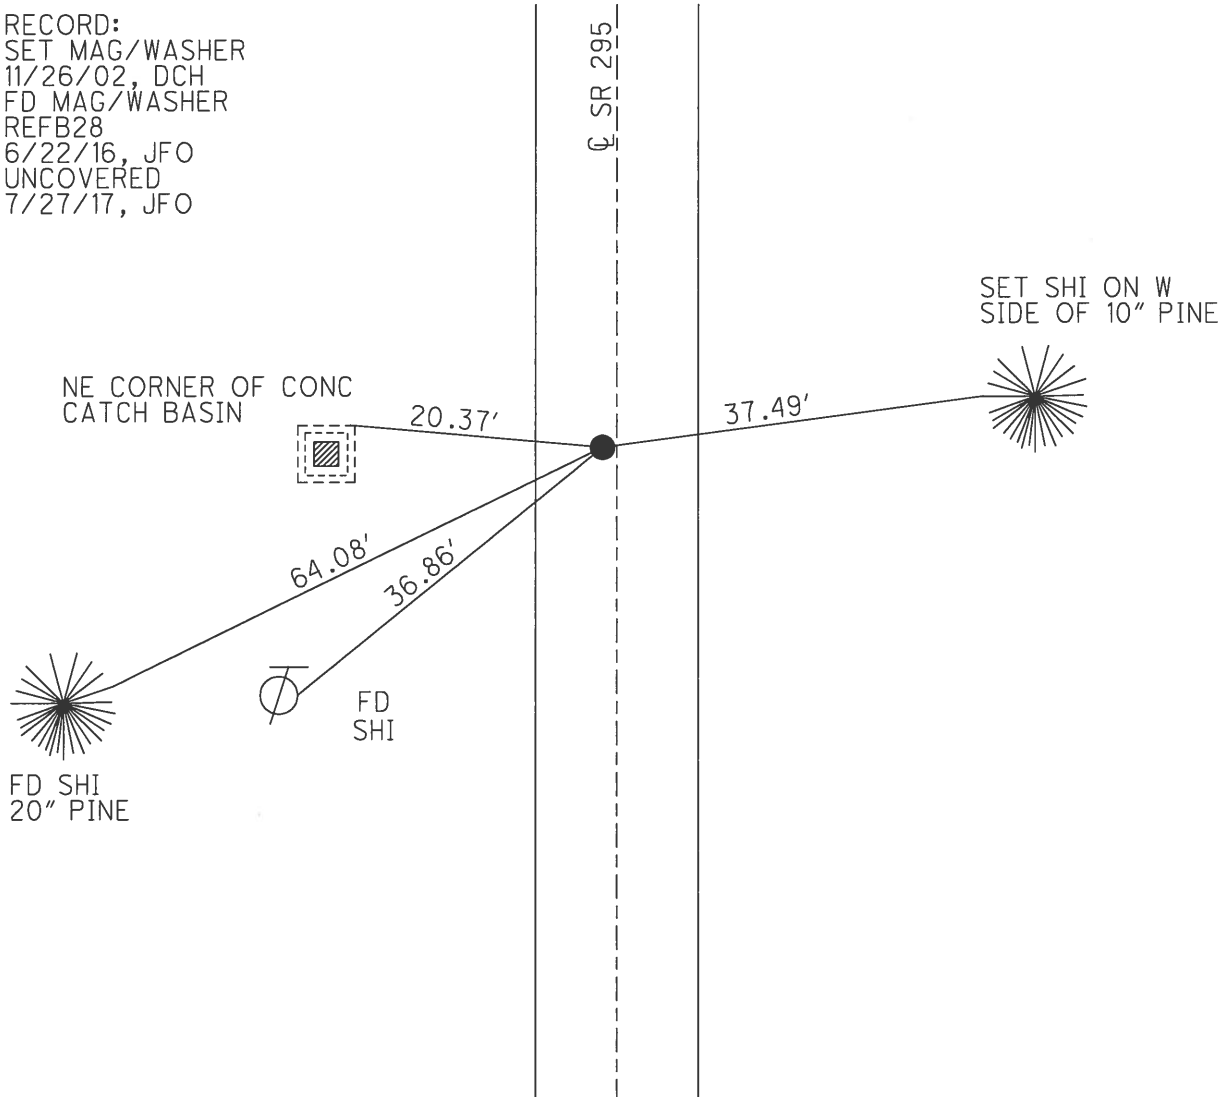

O.D.O.T. DISTRICT 2 SURVEY OFFICE

PERSONNEL

REFERENCE NO. 28 B

SHEET 44 OF 45

NOTES BROWN

DATE 9-9-02

ROUTE S.R. 295

H.C. HOMAN

WEATHER SUNNY

COUNTY LUCAS

R.C. BROWN

TEMP. 87°

TOWNSHIP SWANTON

SECTION 15

T 7 N R 9 E



TYPE MONUMENT PK SHANK

ON SURFACE - ~~BELOW~~ ON


LEFT - Q PAV'T - ~~RIGHT~~ 1'

10' TO LT EDGE PAVEMENT

S.L.M. 498+68

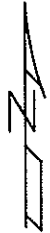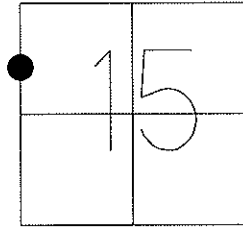

SET MAG/WASHER  
DCH, 11-26-02

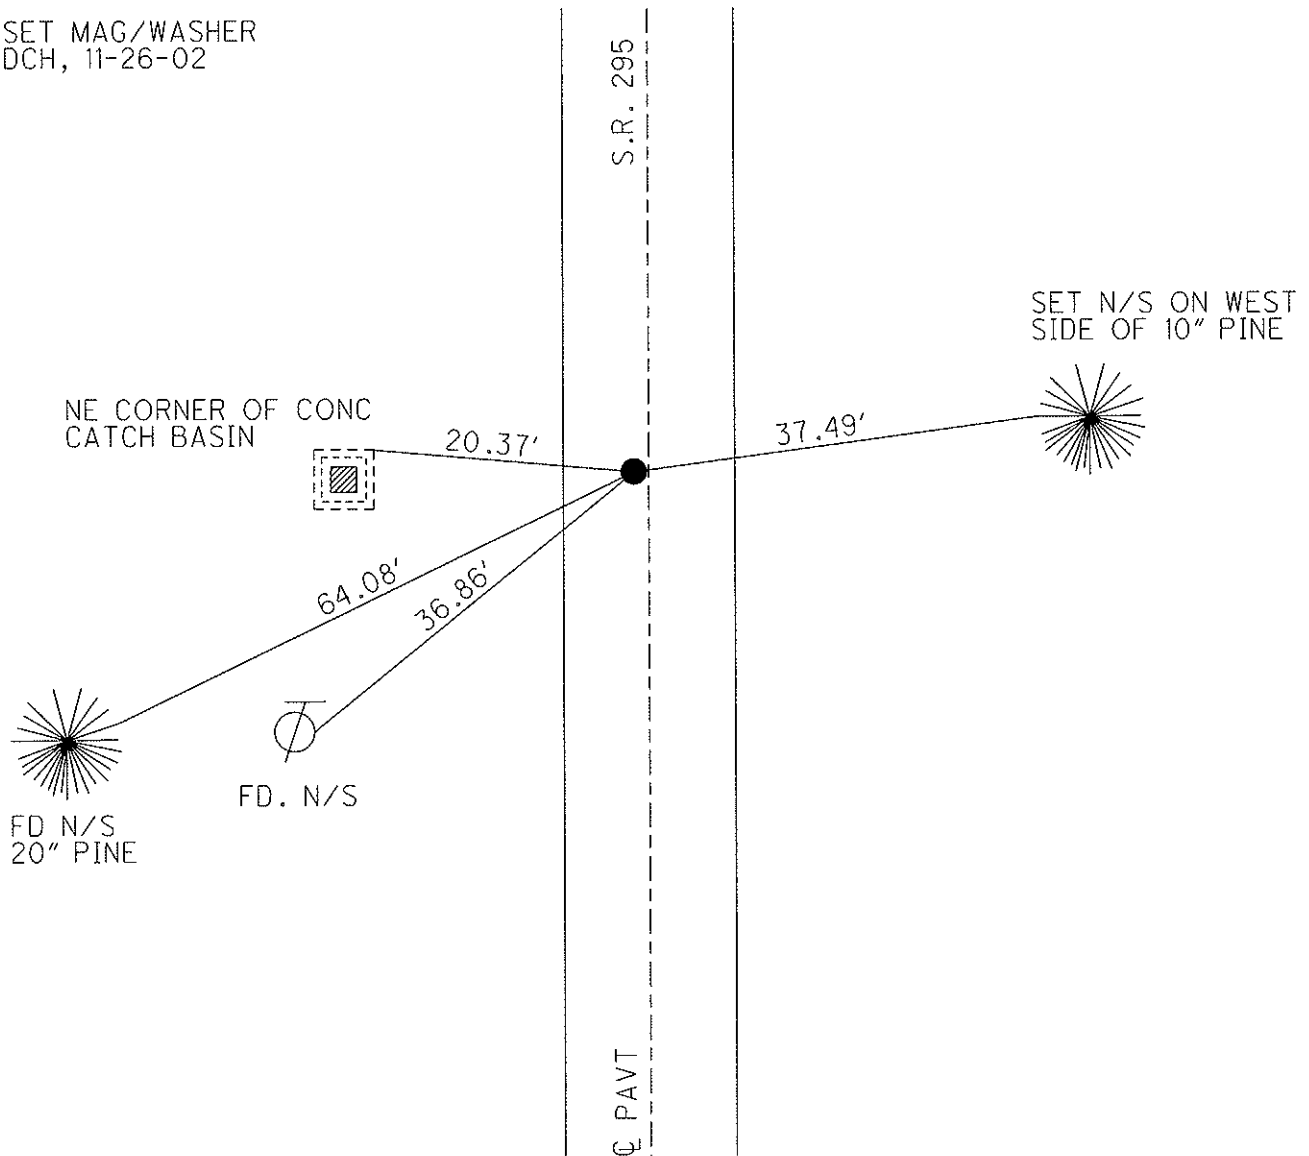

# O.D.O.T. DISTRICT 2 SURVEY OFFICE

PERSONNEL \_\_\_\_\_

REFERENCE NO. 28.B

SHEET 35 OF 35

NOTES LOEHRKE

H.C. RIPLLE

R.C. GEYMAN

DATE 8-2-91

WEATHER CLEAR

TEMP. \_\_\_\_\_

ROUTE S.R. 295

COUNTY LUCAS

TOWNSHIP SWANTON

SECTION 15

T. 7 N. R. 9 E.

TYPE MONUMENT R.R. SPIKE

ON SURFACE - ~~BELOW~~ YES



LEFT - &lt;del>PAV'T. - RIGHT</del> YES

8.3 TO Lt EDGE PAVEMENT

S.L.M. 498 + 68

set P.K. / WASHER

1/4-1/4  
CORNER

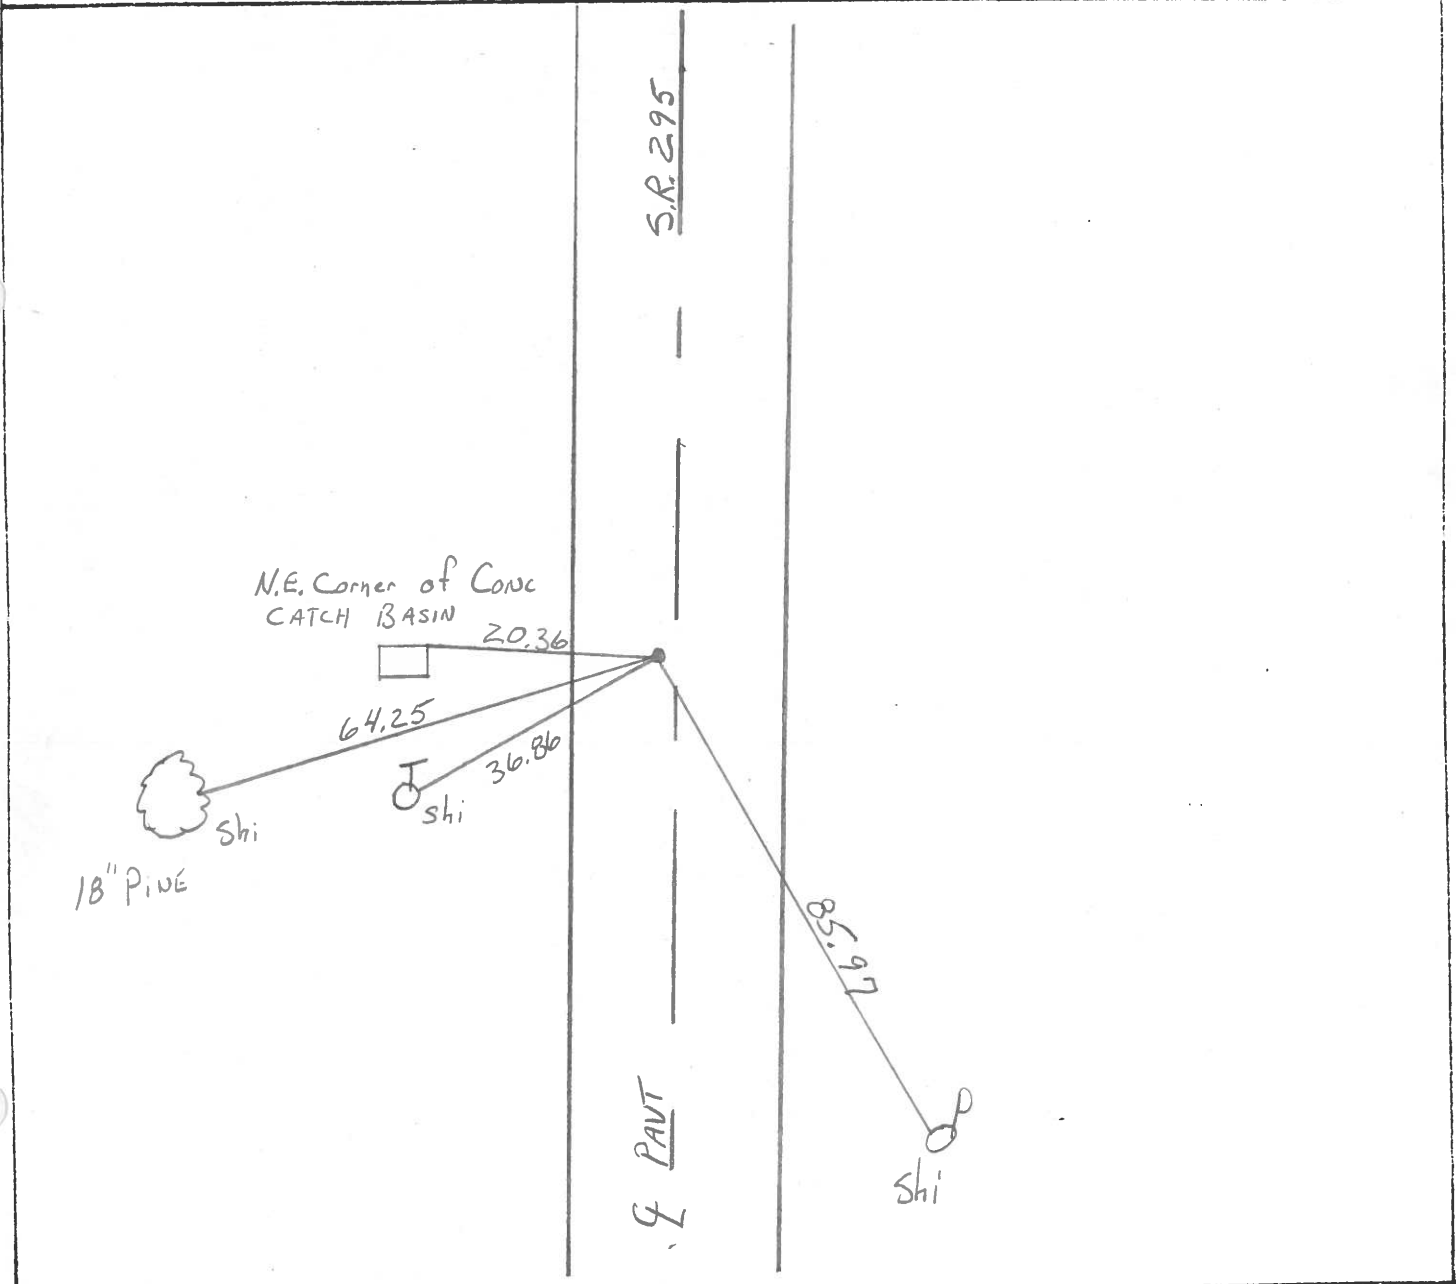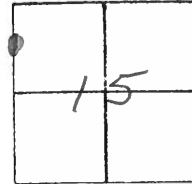

County Lucas S.R. 295

Date 27 April 02

Township Sweeton


Weather Cloud

Section 15

Temp. 51°


T\_N, R\_E

Personnel L. Stone

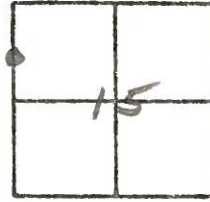

P. Newser  
R. Michalak

REF. NO. 288

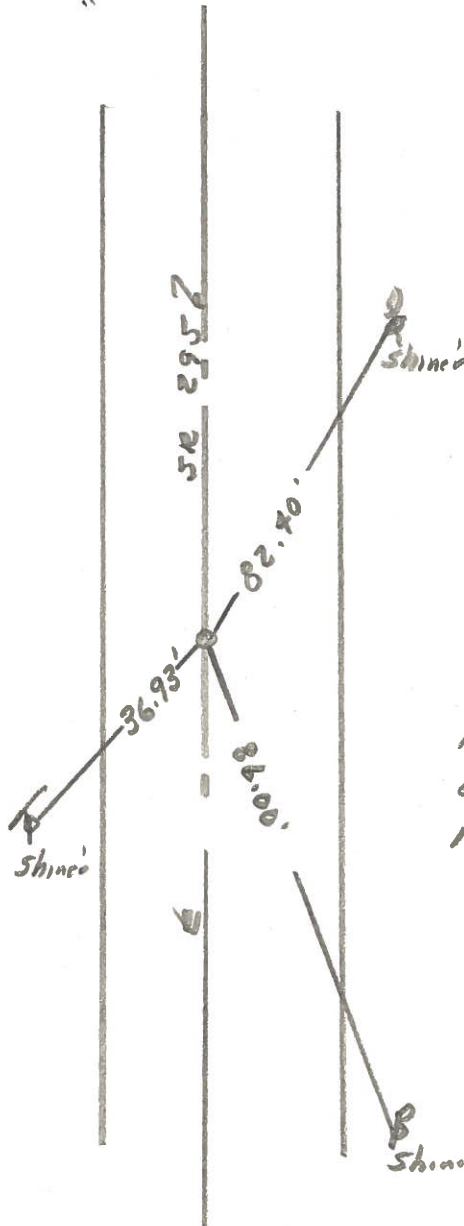

Fd. RR Spk. To Surface  
8.2' To W. edge put.  
11.0' To E. edge put.  
1/16 Cor. Sec. 15-16