


O.D.O.T. DISTRICT 2 SURVEY OFFICE (USE ONLY)

PERSONNEL _____ REFERENCE NO. 28 F SHEET 9 OF 9

NOTES HOMAN DATE 7/29/16 ROUTE SR 295
 H.C. HOMAN WEATHER SUNNY COUNTY LUCAS
 R.C. RYALL TEMP. 84°F TOWNSHIP SWANTON
 _____ SECTION 9
 _____ T 7 N R 5 E


TYPE MONUMENT MONBOX W/ IPIN
 ON SURFACE - ~~BELOW~~ _____ ON _____
 LEFT - ☉ PAV'T - RIGHT _____ ON _____
 _____ TO _____ EDGE PAVEMENT
 S.L.M. 623+96

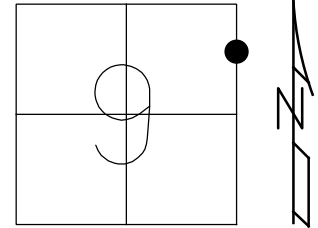

GRID: NORTHING: 702942.925 EASTING: 1605937.436

RECORD:
 CL1
 3/25/10, KPM
 FD MON BOX
 W/ IPIN
 REF8
 7/29/16, DCH

NOTE: REF 8 SR 2

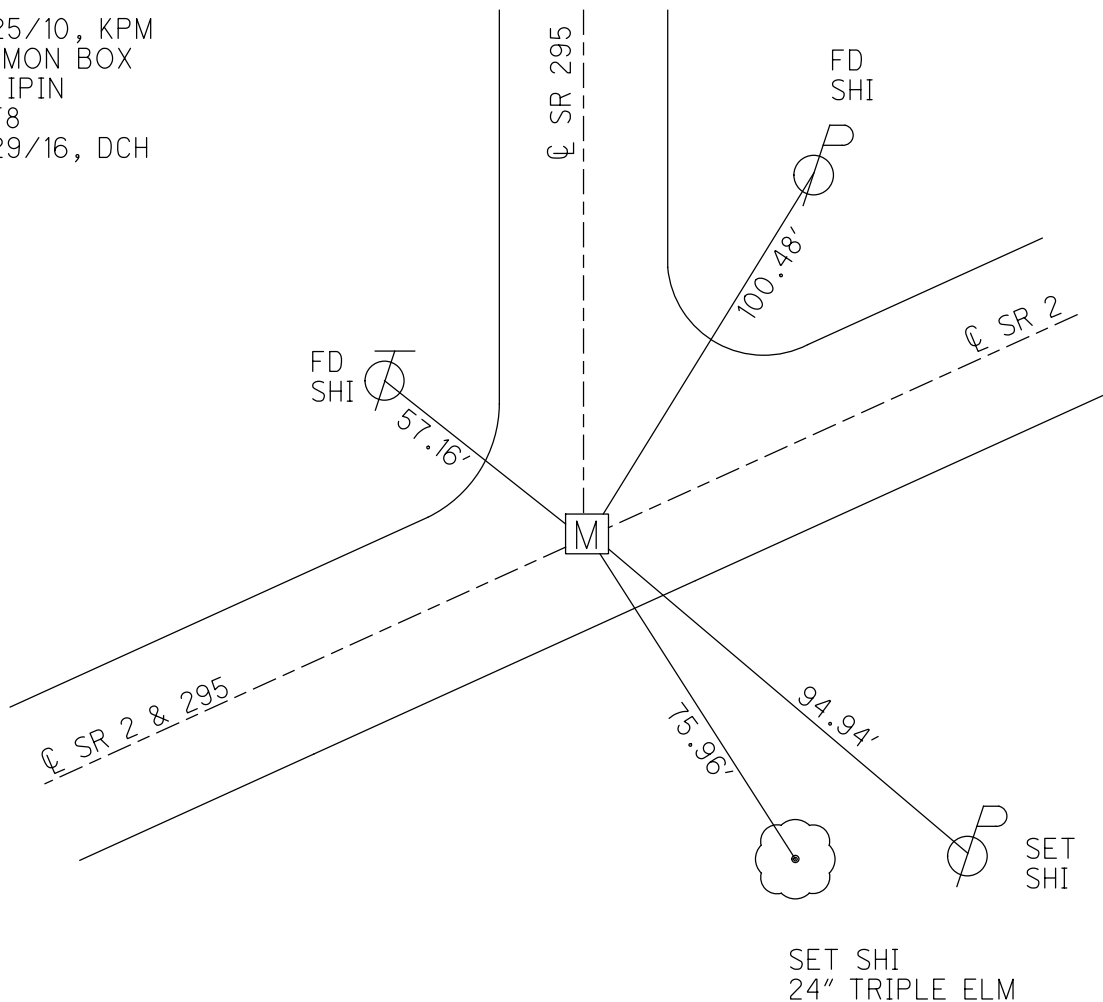


SET SHI
 24" TRIPLE ELM

O.D.O.T. DISTRICT 2 SURVEY OFFICE (USE ONLY)

PERSONNEL _____ REFERENCE NO. 28 F SHEET 3 OF 3
 NOTES HOMAN DATE 6/15/03 ROUTE SR 295
 H.C. HOMAN WEATHER RAIN COUNTY LUCAS
 R.C. RYALL TEMP. 75° TOWNSHIP SWANTON
 _____ SECTION 9
 _____ T 7 N R 5 E

TYPE MONUMENT MON.BOX
~~ON SURFACE~~ - BELOW 2"
 LEFT - Q PAV'T - RIGHT ON
- TO - EDGE PAVEMENT
 S.L.M. -

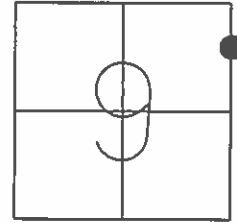

GRID: NORTHING: 702942.924 EASTING: 1605937.393

GPS, CL1
 3/25/10, KPM

