


O.D.O.T. DISTRICT 2 SURVEY OFFICE (USE ONLY)


PERSONNEL \_\_\_\_\_ REFERENCE NO. 31 SHEET 3 OF 24  
 NOTES HUSS DATE 6/28/12 ROUTE SR 295  
 H.C. HUSS WEATHER CLEAR/HOT COUNTY LUCAS  
 R.C. CANTERBURY TEMP. 94° TOWNSHIP SWANTON  
 \_\_\_\_\_ SECTION 4  
 \_\_\_\_\_ T 7 N R 9 E

TYPE MONUMENT \_\_\_\_\_ RR SPIKE \_\_\_\_\_  
 ON SURFACE - ~~BELOW~~ ON \_\_\_\_\_  
 LEFT - Q PAV'T - ~~RIGHT~~ 1.4'  
9.4' TO LT EDGE PAVEMENT  
 S.L.M. 652+24.68

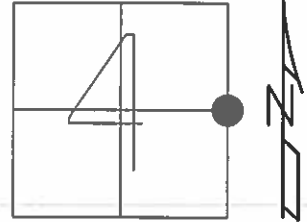

GRID: NORTHING: 705862.923 EASTING: 1606002.424

RECORD:  
 FD RR SPK  
 1.5" DEEP  
 8/11/86  
 FD RR SPK  
 9/15/10, JMH  
 GPS REF31,  
 10/13/10, JMH  
 GPS  
 3/25/10, CL4, KPM  
 1 SHOT TAKEN ONLY  
 SET MAG/WASHER  
 10/16/12, SDC  
 GPS, NEWREF31  
 11/30/12, SDC

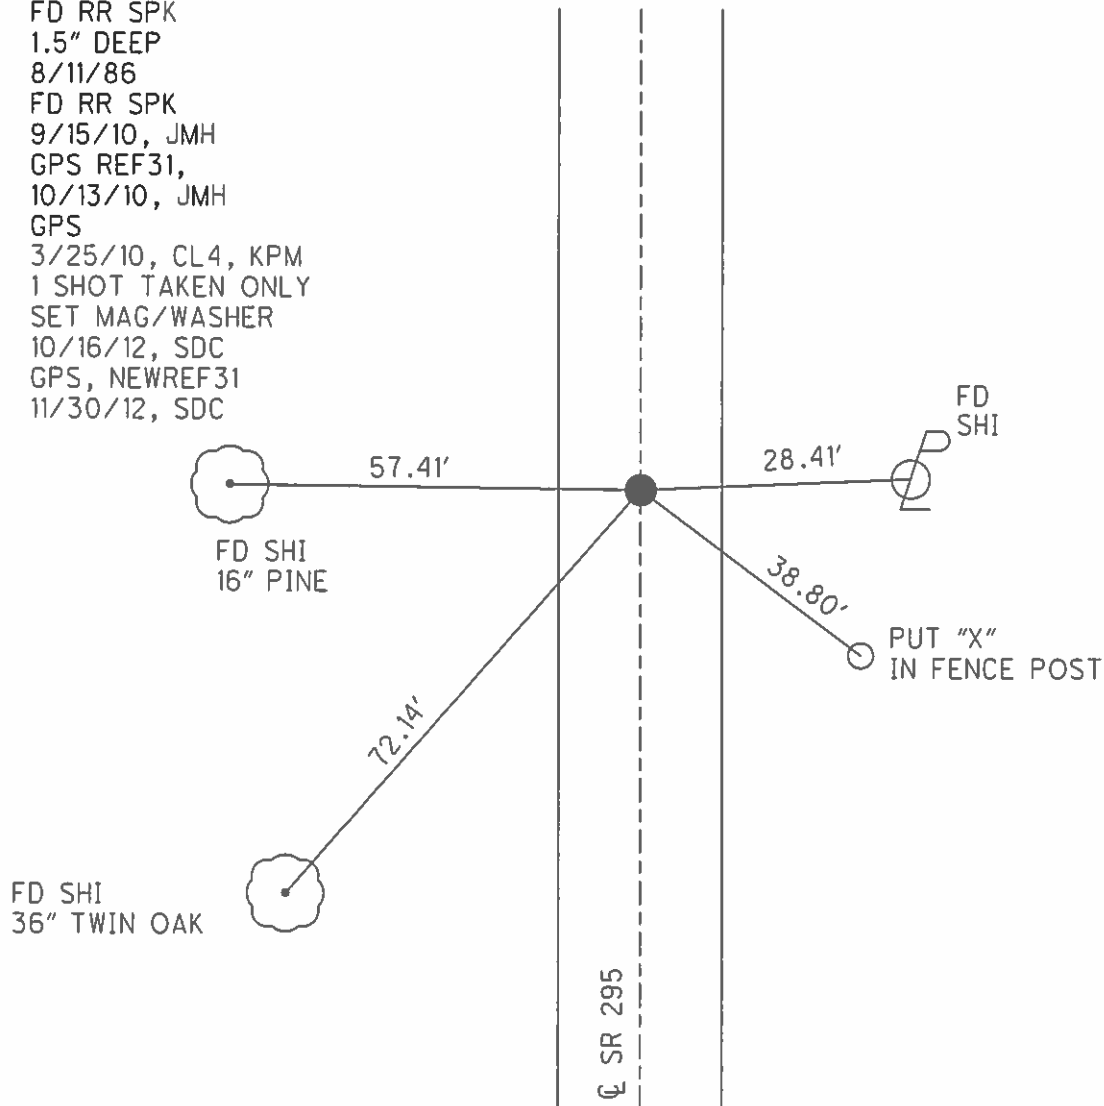

O.D.O.T. DISTRICT 2 SURVEY OFFICE (USE ONLY)

PERSONNEL \_\_\_\_\_

REFERENCE NO. 31

SHEET 3 OF 24

NOTES HUSS

DATE 6-28-12

ROUTE SR#295

H.C. HUSS

WEATHER CLEAR/HOT

COUNTY LUCAS

R.C. CANTERBURY

TEMP. 94°F

TOWNSHIP SWANTON

SECTION 4

T 7 N R 9 E


TYPE MONUMENT \_\_\_\_\_ R.R. SPIKE \_\_\_\_\_

ON SURFACE - ~~BELOW~~ ON \_\_\_\_\_

LEFT - Q PAV'T - ~~RIGHT~~ 1.4'  
9.4' TO LT. EDGE PAVEMENT


S.L.M. 652+24.68

Grid: Northing: 705862.923 Easting: 1606002.424

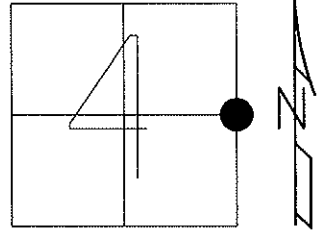

RECORD:  
 FD RR SPK  
 1.5" DEEP 8-11-86  
  
 FD RR SPK 9-15-10 JMH  
  
 GPS REF31,  
 10-13-10 JMH  
 GPS 3-25-10 CL4 KPM  
 1 SHOT TAKEN ONLY

SET MAG/WASHER  
 10/16/12, SDC  
  
 GPS, NEWREF31  
 11/30/12, SDC

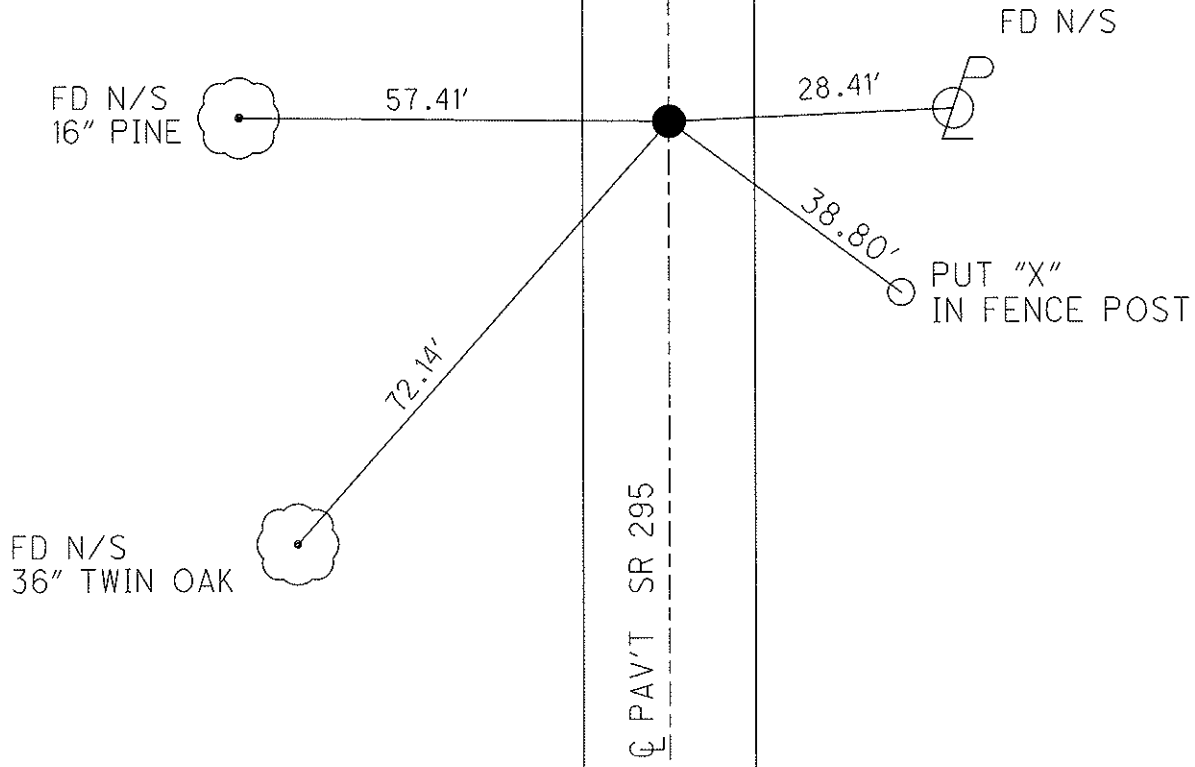

# O.D.O.T. DISTRICT 2 SURVEY OFFICE

PERSONNEL

REFERENCE NO. 31

SHEET 3 OF     

NOTES 1. Stone

H.C. D. Curtis

R.C. J. Haushalter

R. Michelak

DATE 6 May 86

WEATHER Cloudy

TEMP. 77°

ROUTE SR # 295

COUNTY Lucas

TOWNSHIP Swanton

SECTION 4

T      R     


TYPE MONUMENT RR Spk.

ON SURFACE - BELOW Surface


LEFT -      PAV'T. - RIGHT     

     TO      EDGE PAVEMENT

S.L.M. 591+00

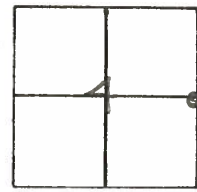


Fd. R.R. Spk. 1 1/2" Deep -  
8-11-86

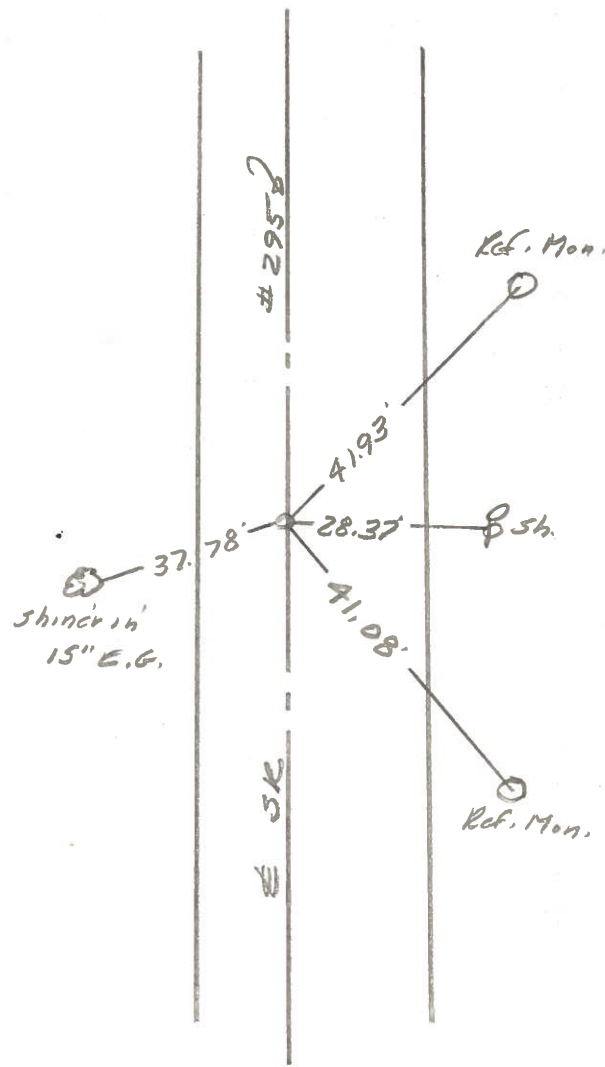

PERSONNEL	TITLE	PERSONNEL	TITLE	COUNTY	<u>LUCAS</u>	DATE	<u>JULY 16, 1971</u>
<u>W. DENNO</u>				S. R.	<u>#295</u>	WEATHER	<u>FAIR</u>
<u>D. CURTIS</u>				SEC.		TEMP.	<u>70±</u>
<u>D. STEVENS</u>							
<u>R. BRANNAN</u>							

DESCRIPTION	<u>REFERENCES TO CONTROL POINTS</u>	JOB NO.	
	LEFT	CENTER LINE	RIGHT

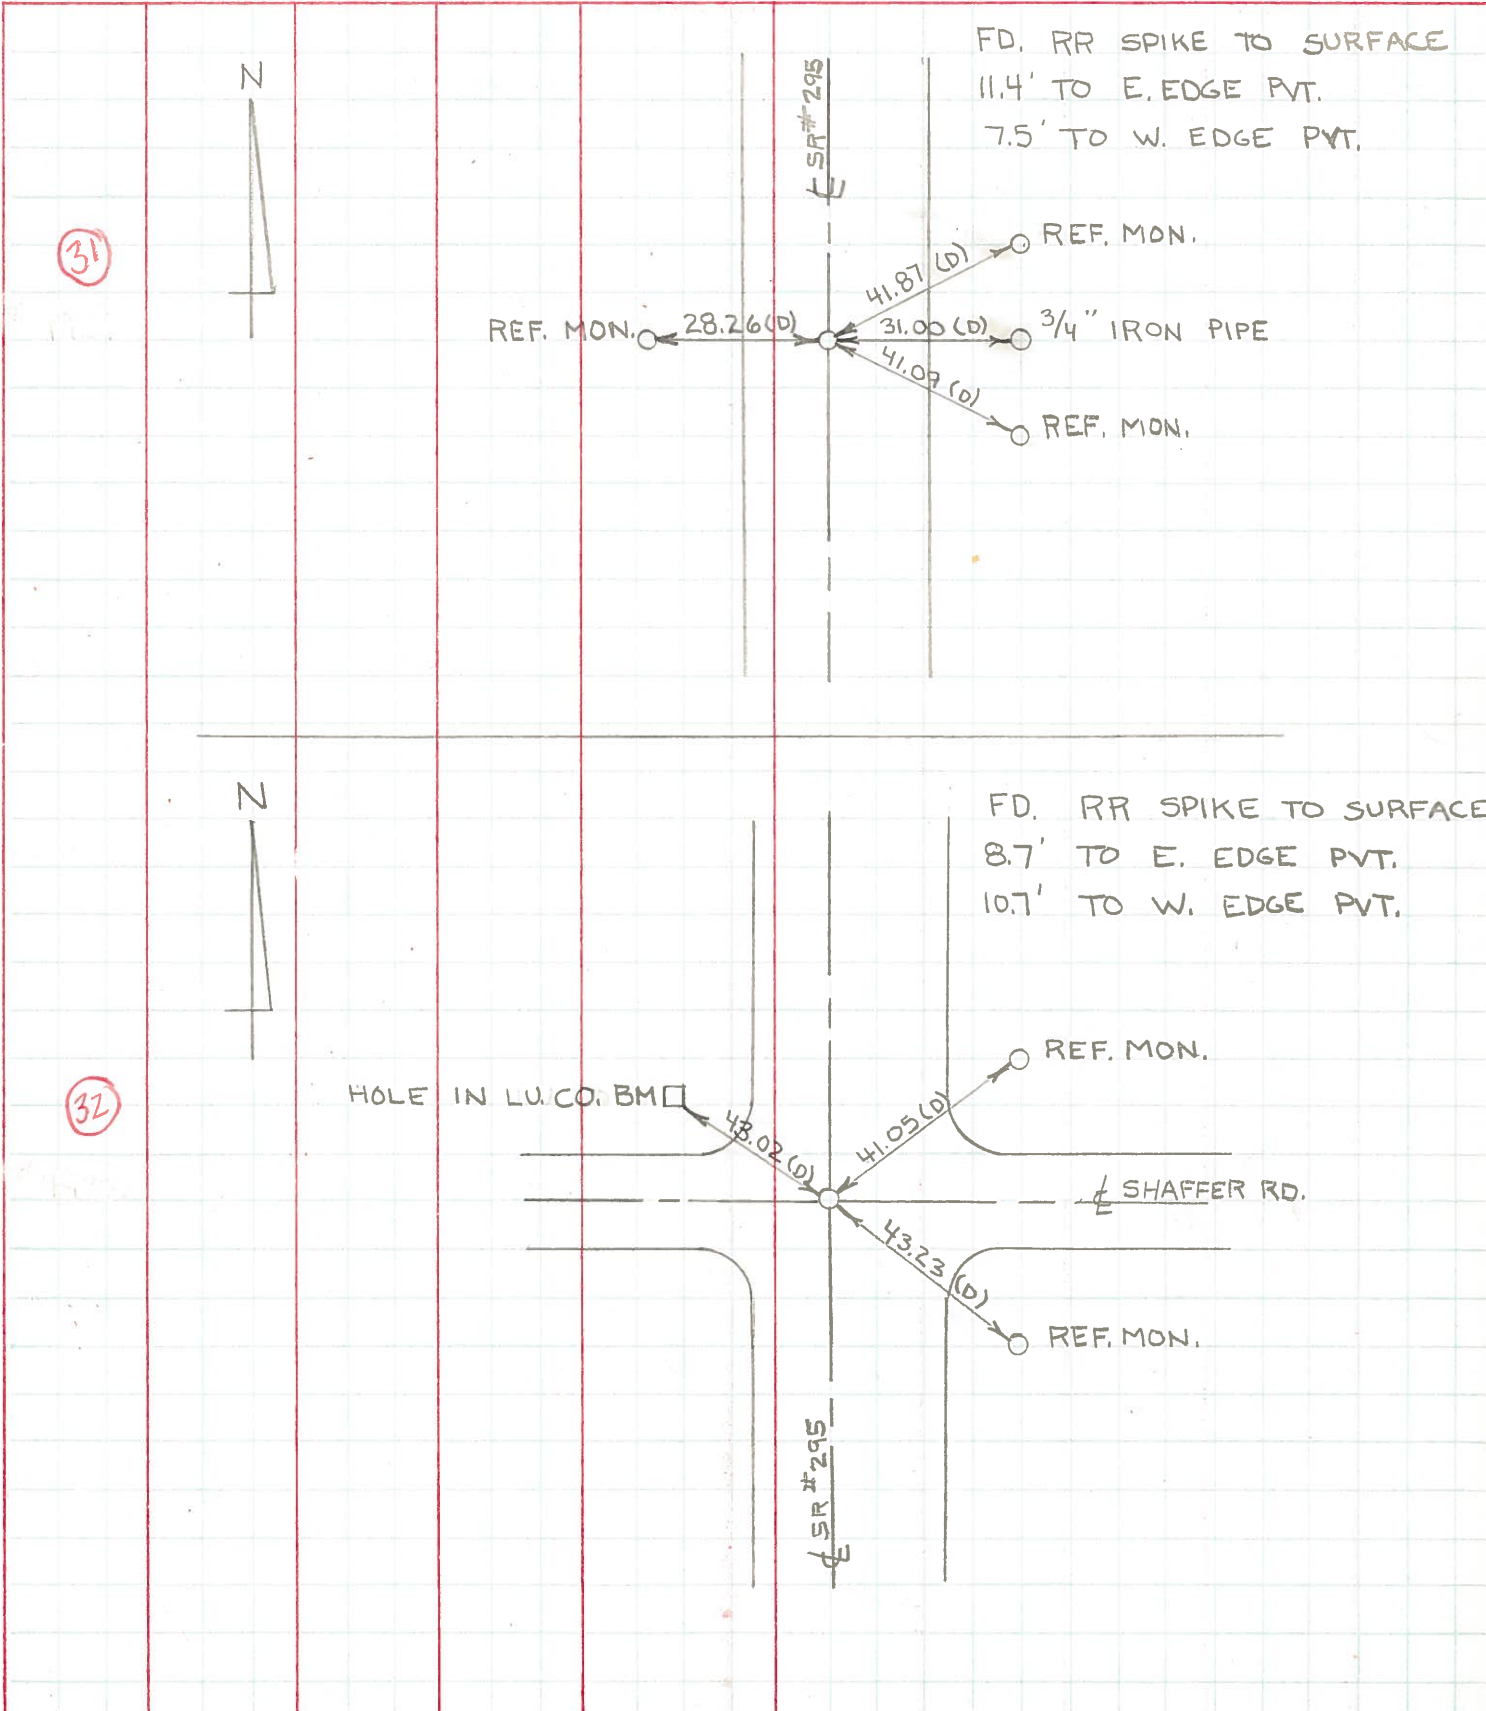

PERSONNEL	TITLE	PERSONNEL	TITLE	COUNTY	DATE
Stone	Notes			Lucas	13 June 68
Beck	Flag			S. R. #295	WEATHER Cool
Michalak	Tape			SEC.	TEMP. 55°
Schroder	Tape				

DESCRIPTION References to Control Points JOB NO. \_\_\_\_\_

