

O.D.O.T. DISTRICT 2 SURVEY OFFICE (USE ONLY)

PERSONNEL _____ REFERENCE NO. 32 SHEET 5 OF 24
 NOTES HUSS DATE 6/29/12 ROUTE SR 295
 H.C. HUSS WEATHER CLEAR/FAIR COUNTY LUCAS
 R.C. COUTCHER TEMP. 80° TOWNSHIP SWANTON
HARBAUGH SECTION 3-4, 33-34
 T 8 N R 9 E


TYPE MONUMENT SM RR SPIKE
 ON SURFACE - ~~BELOW~~ ON
~~LEFT~~ - Q PAV'T - RIGHT 2.45'
TO EDGE PAVEMENT
 S.L.M. 678+86.06

33	34
4	3



GRID: NORTHING: 708523.333 EASTING: 1606071.105


RECORD:
 SET SM RR SPK
 AT SURFACE 8/11/86
 FD SM RR SPK 9/15/10, JMH
 GPS REF32,
 10/13/10, JMH
 SET MAG/WASHER
 10/16/12, SDC
 GPS, NEWREF32
 11/30/12, SDC

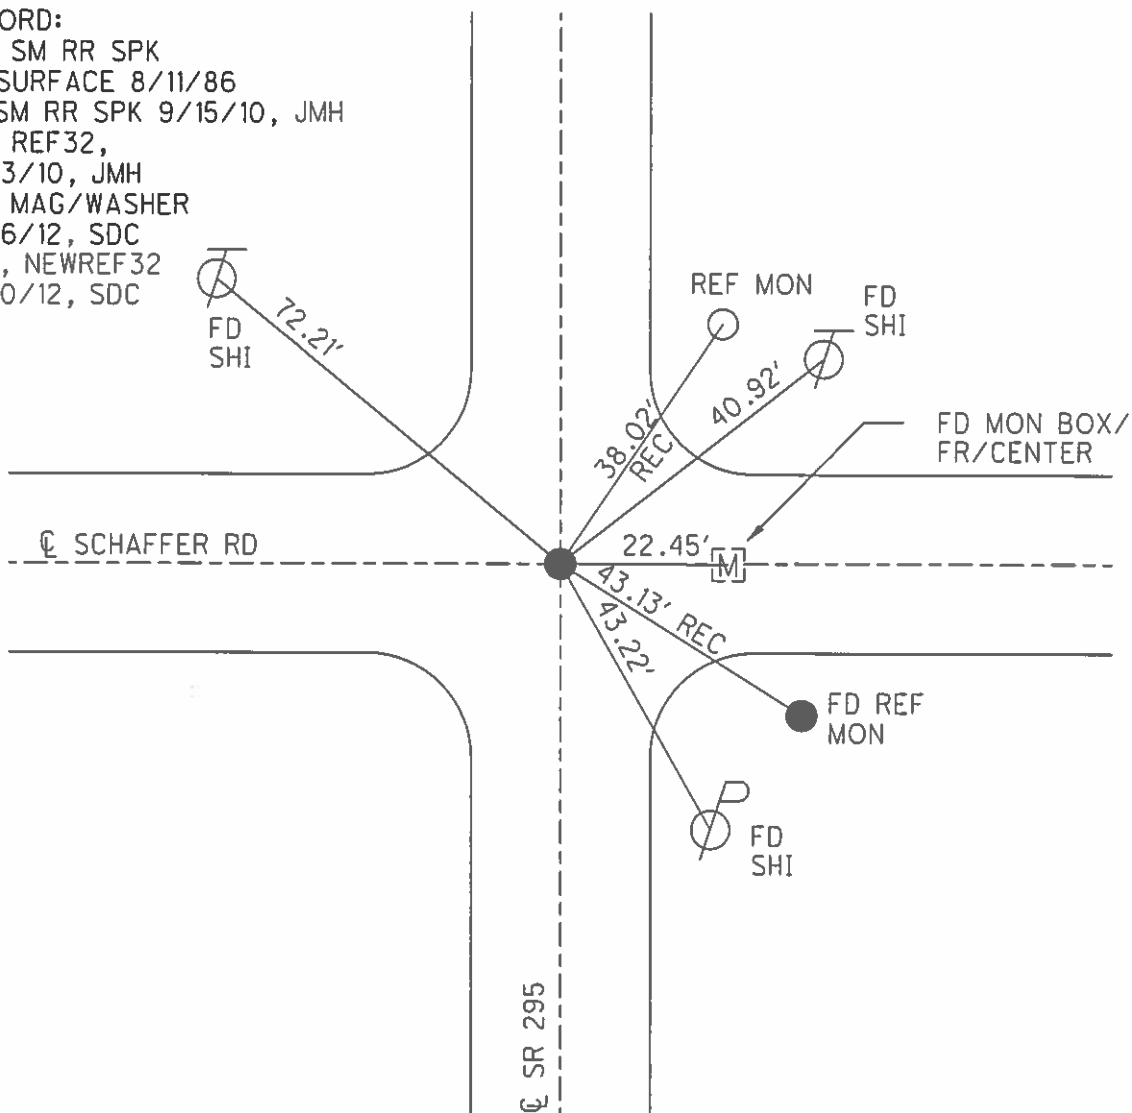

O.D.O.T. DISTRICT 2 SURVEY OFFICE (USE ONLY)

PERSONNEL _____ REFERENCE NO. 32 SHEET 5 OF 24
NOTES HUSS DATE 6-29-12 ROUTE SR#295
H.C. HUSS WEATHER CLEAR/FAIR COUNTY LUCAS
R.C. COUCHER TEMP. 80°F TOWNSHIP SWANTON
HARBAUGH SECTION 3-4, 33-34
T 8 N R 9 E

TYPE MONUMENT _____ SM.R.R.SPIKE
ON SURFACE - ~~BELOW~~ _____ ON
~~LEFT~~ - Q PAV'T - RIGHT 2.45'
_____ TO _____ EDGE PAVEMENT
S.L.M. 678+86.06
Grid: Northing: 708523.333 Easting: 1606071.105

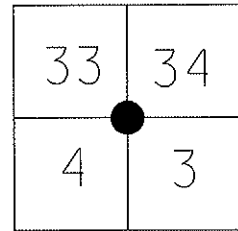


RECORD:

SET SM RR SPK
AT SURFACE 8-11-86

FD SM RR SPK 9-15-10 JMH

GPS REF32,
10/13/10 JMH

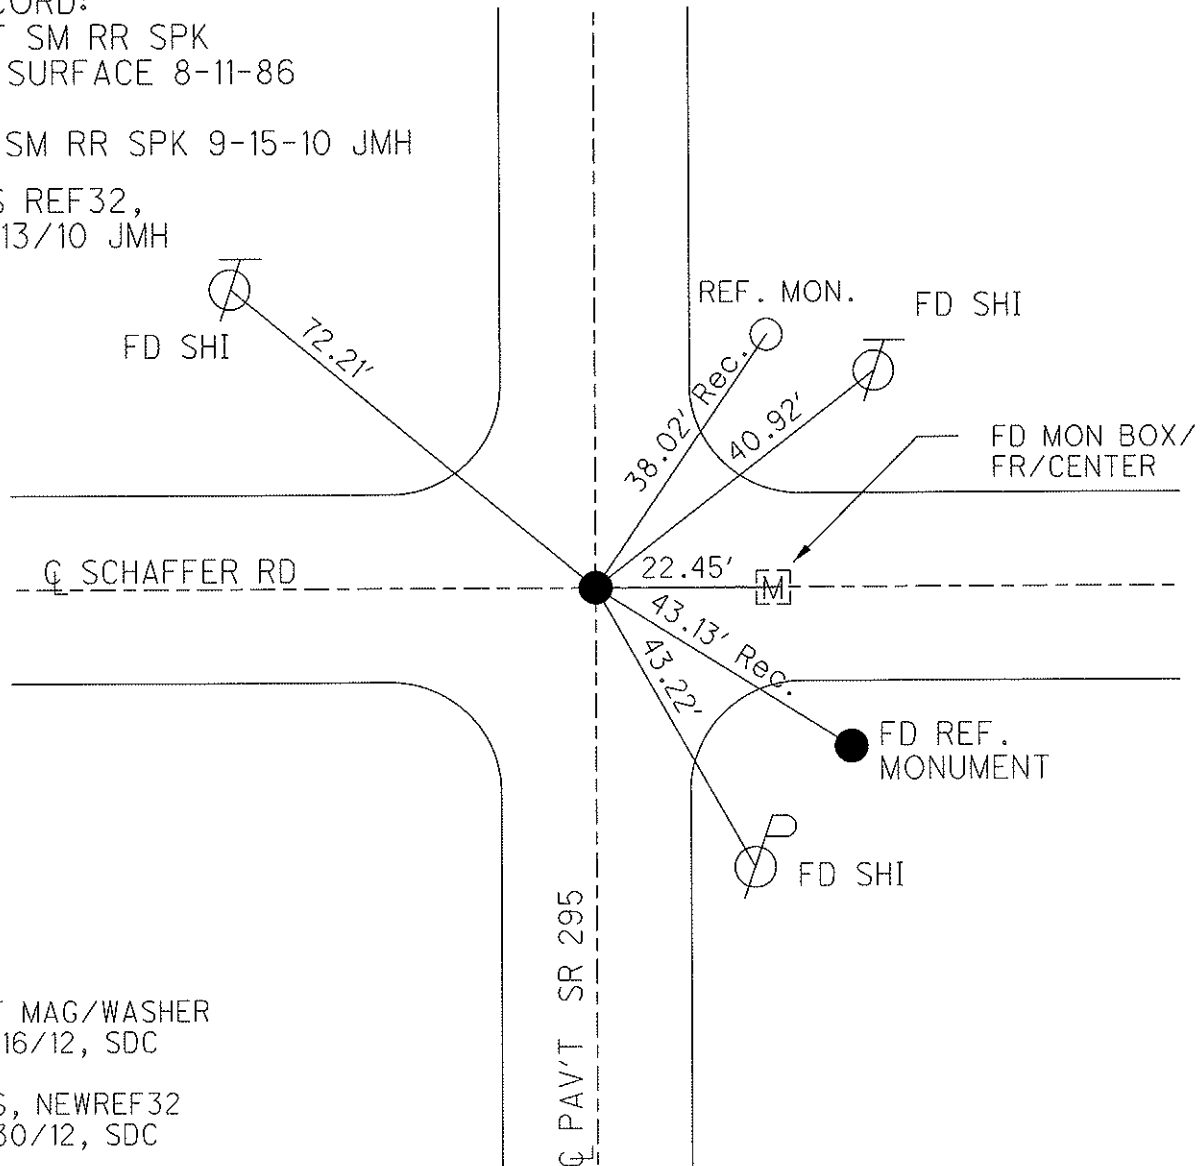

SET MAG/WASHER
10/16/12, SDC

GPS, NEWREF32
11/30/12, SDC

O.D.O.T. DISTRICT 2 SURVEY OFFICE

PERSONNEL

REFERENCE NO. 32

SHEET 5 OF

NOTES 1. Stone

H.C. D. Curtis

R.C. J. Housholder

R. Michalek

DATE 6 May 86

WEATHER Cloudy

TEMP. 78°

ROUTE SR # 295

COUNTY Lucas

TOWNSHIP Swanton

SECTION 3-4-33-34

T. R.

TYPE MONUMENT Sm. RR Spt.

ON SURFACE - BELOW Surface

LEFT - & PAV'T. - RIGHT


 TO EDGE PAVEMENT

S.L.M. 617+62

33	34
4	3




Set Sm. R.R. Spt. To Surface -
8-11-80

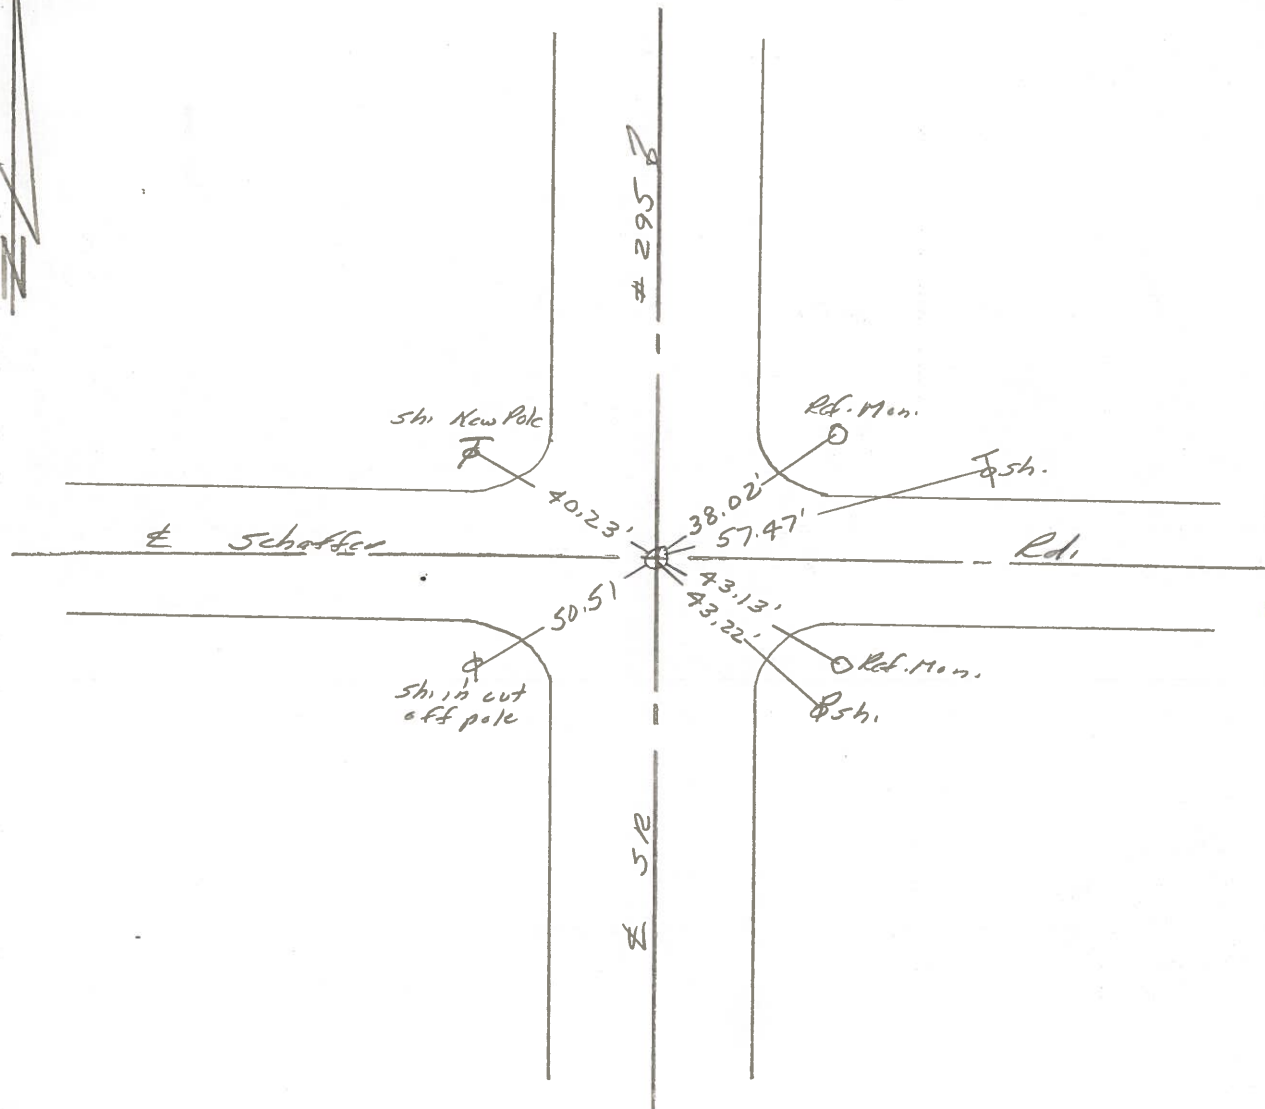

PERSONNEL TITLE PERSONNEL TITLE
W. DENNO _____
D. CURTIS _____
D. STEVENS _____
R. BRANNAM _____


COUNTY LUCAS DATE JULY 16, 1971
 S. R. #295 WEATHER FAIR
 SEC. _____ TEMP. 70±

DESCRIPTION REFERENCES TO CONTROL POINTS JOB NO. _____

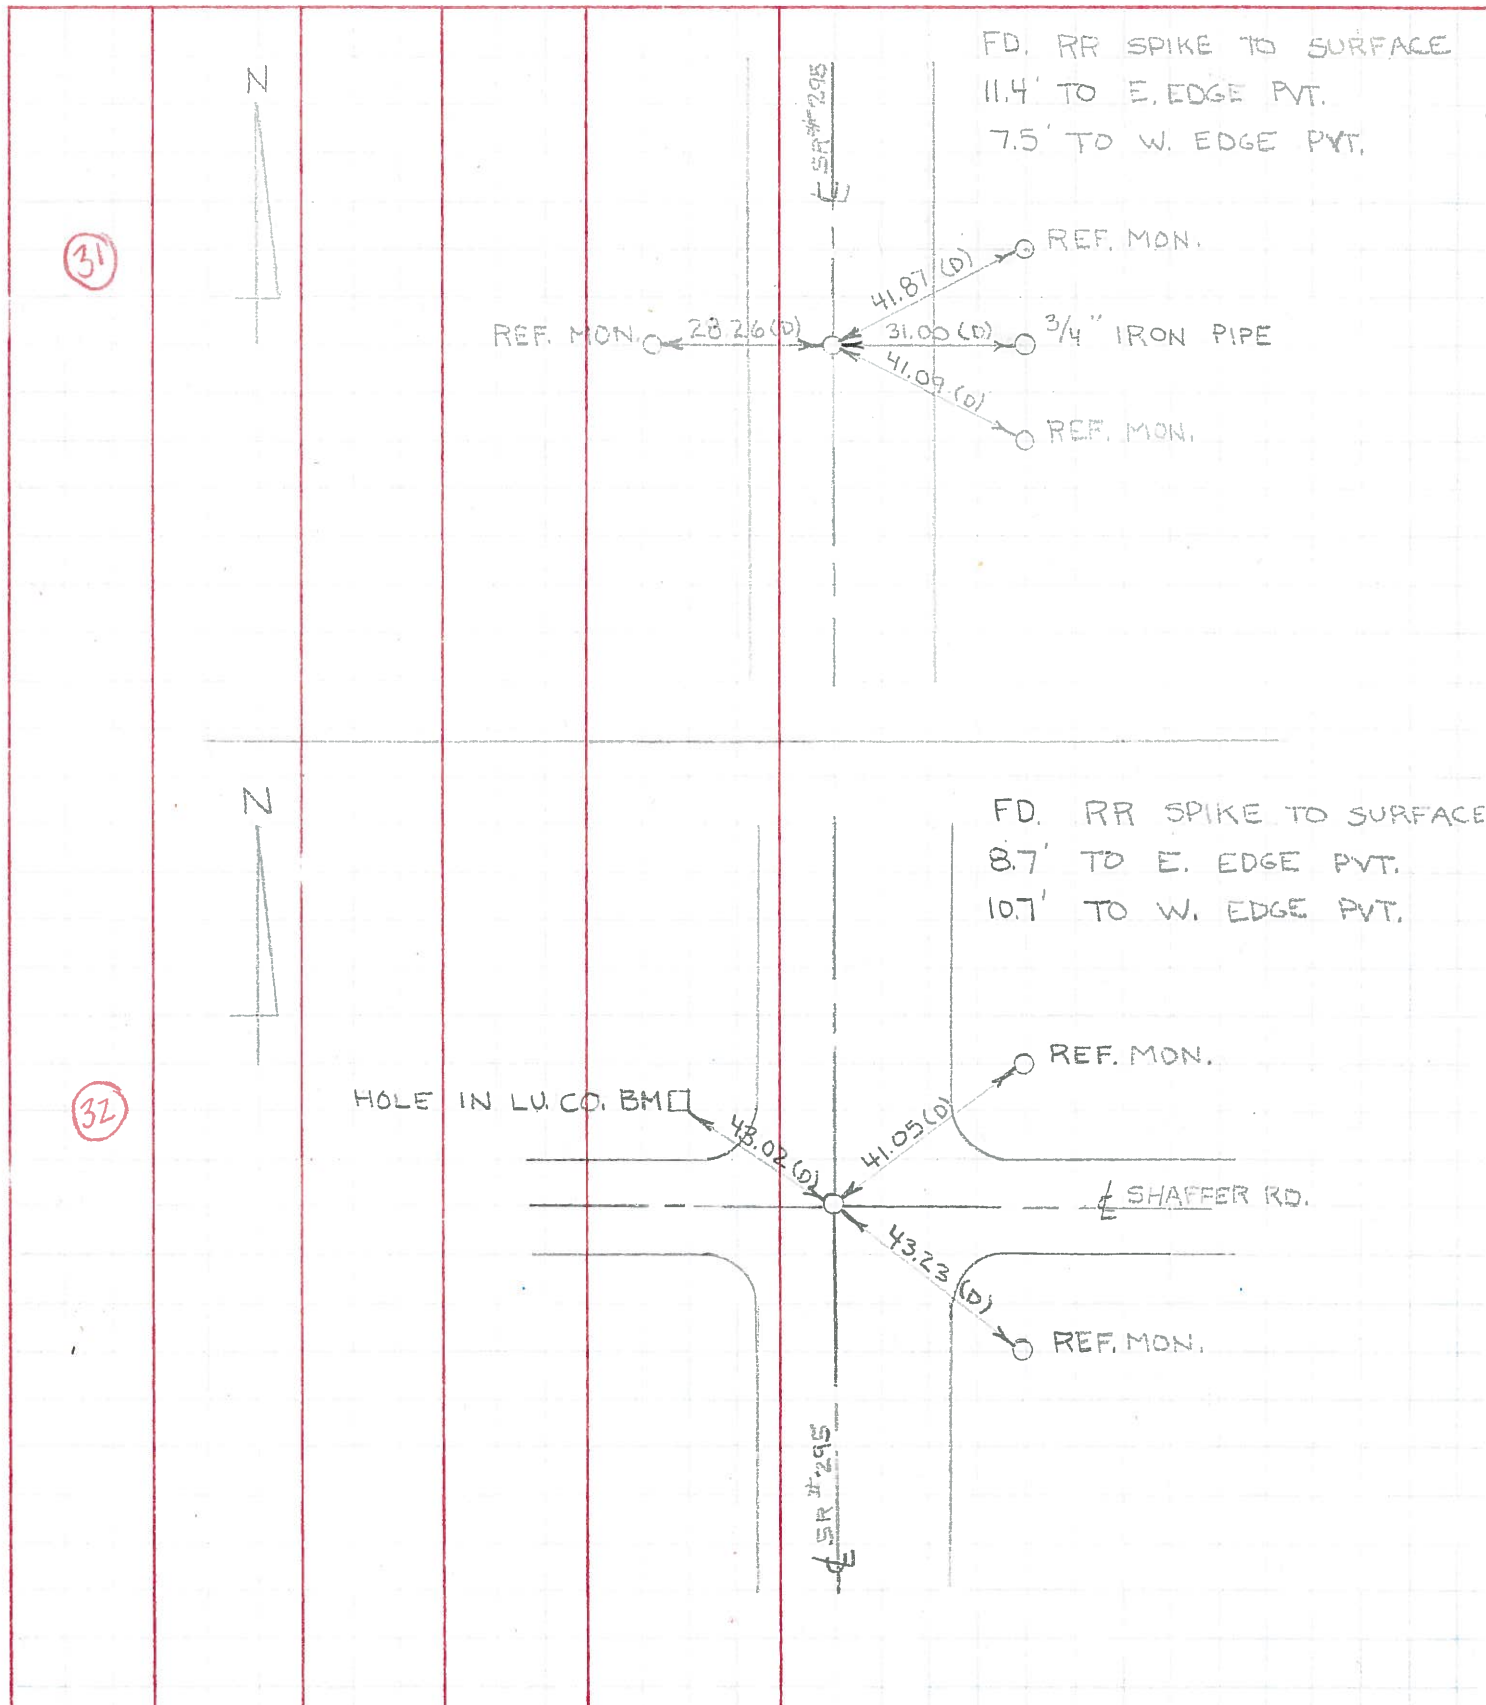

PERSONNEL	TITLE	PERSONNEL	TITLE	COUNTY	DATE
Stone	Notes			Lucas	13 June 68
Beck	Flag			S. R. # 295	WEATHER Cool
Michalak	Tape			SEC.	TEMP. 55°
Schroder	Tape				

DESCRIPTION References to Control Points JOB NO. _____

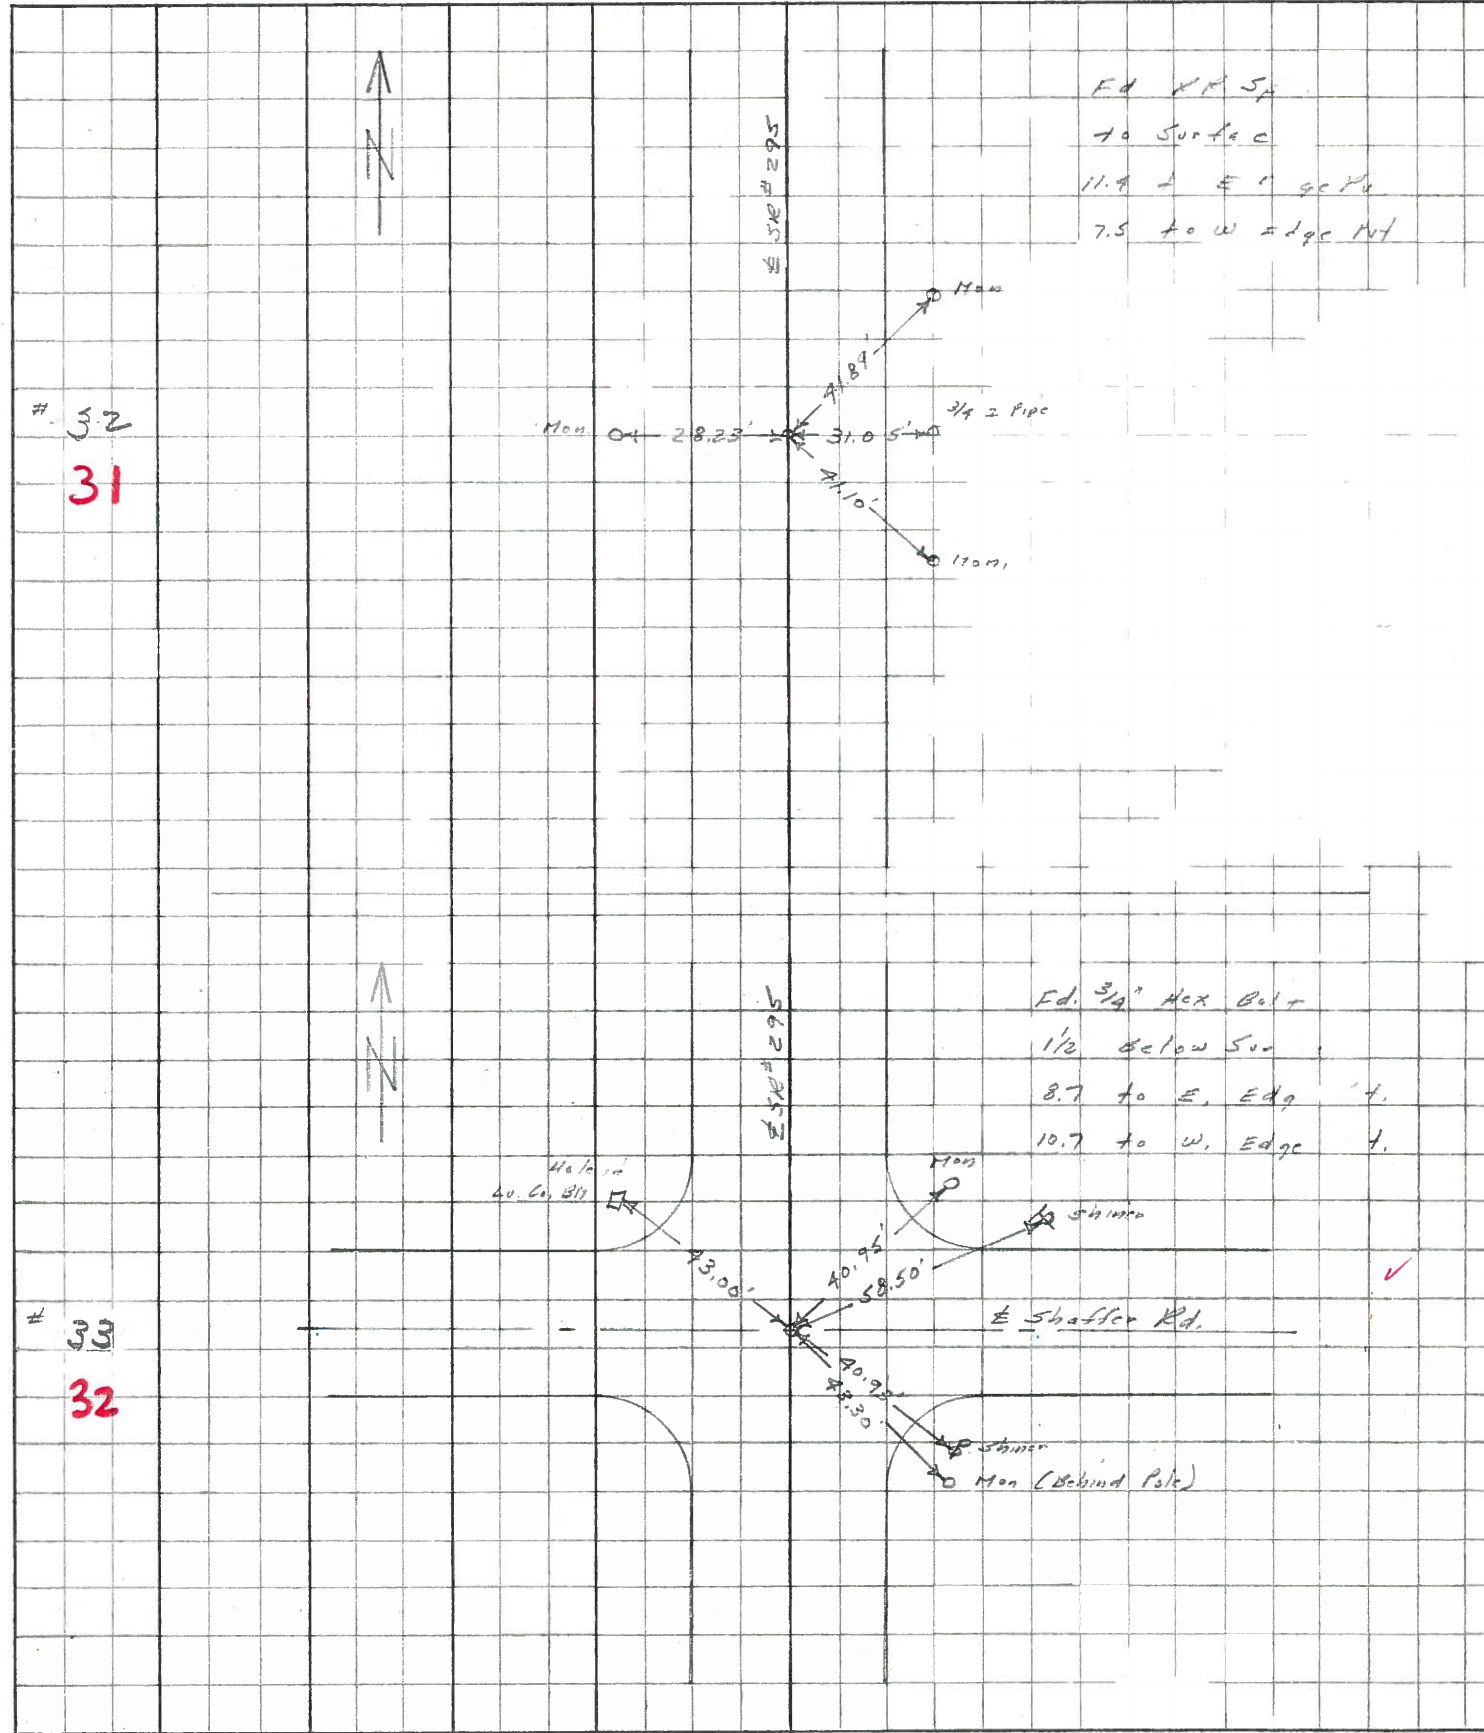

32
31

32
32