


O.D.O.T. DISTRICT 2 SURVEY OFFICE (USE ONLY)


PERSONNEL _____ REFERENCE NO. 34 A SHEET 9 OF 24
 NOTES HARBAUGH DATE 6/29/12 ROUTE SR 295
 H.C. HUSS WEATHER SUNNY COUNTY LUCAS
 R.C. COUTCHER TEMP. 80° TOWNSHIP HARDING
 _____ SECTION 33
 _____ T 8 S R 9 E

TYPE MONUMENT _____ MON BOX _____
 ON SURFACE - ~~BELOW~~ ON _____
 LEFT - ☉ PAV'T - ~~RIGHT~~ 0.5'
10.2' TO LT EDGE PAVEMENT
 S.L.M. 750+41.97

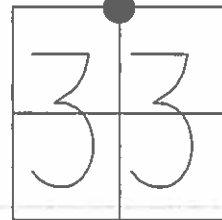

GRID: NORTHING: 713501.592 EASTING: 1603642.178

NOTE:
 MONBOX NOT FD
 TIES PULLED TO BRIDGE
 TO NEW EXPANSION JOINT
 10/16/12, SDC

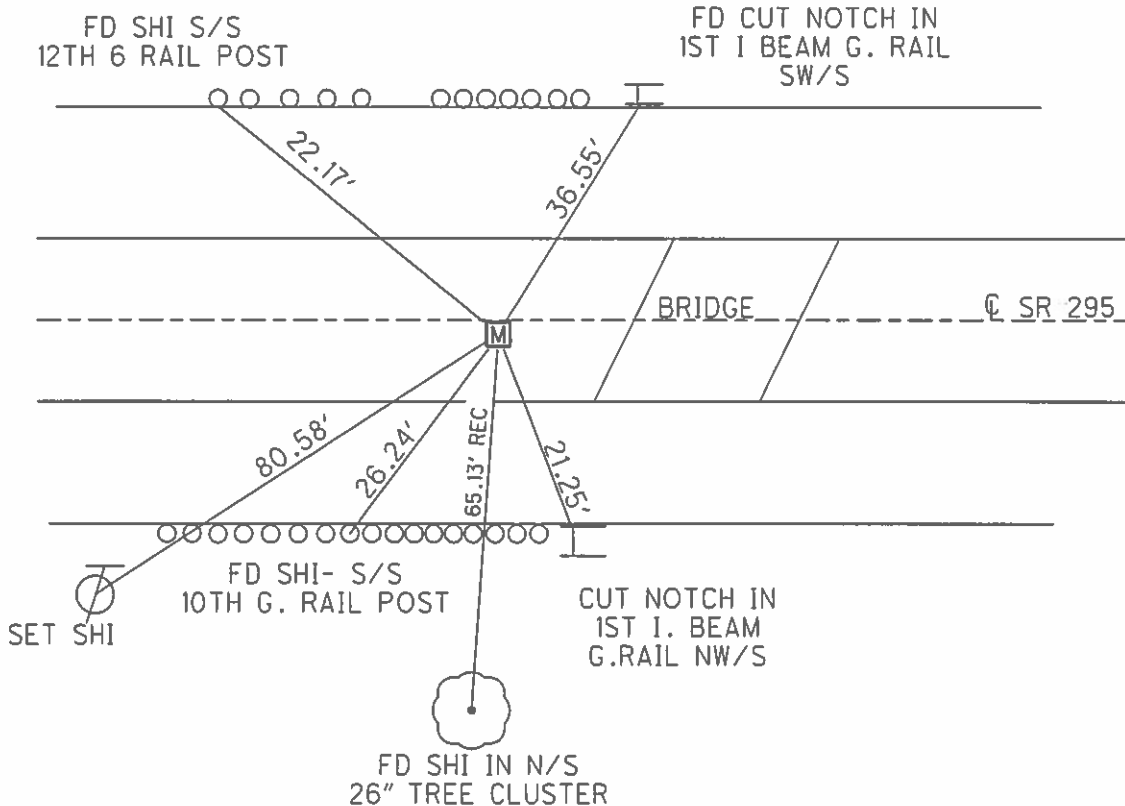

O.D.O.T. DISTRICT 2 SURVEY OFFICE (USE ONLY)

PERSONNEL _____

REFERENCE NO. 34-A

SHEET 9 OF 24

NOTES HARBAUGH

DATE 6-29-12

ROUTE SR#295

H.C. HUSS

WEATHER SUNNY

COUNTY LUCAS

R.C. COUTCHER

TEMP. 80°F

TOWNSHIP HARDING

SECTION 33

T 8 S R 9 E

TYPE MONUMENT _____ MON BOX _____


ON SURFACE - ~~BELOW~~ ON _____

LEFT - CL PAV'T - ~~RIGHT~~ 0.5'

10.2' TO LT EDGE PAVEMENT

S.L.M. 750+41.97

Grid: Northing: 713501.592 Easting: 1603642.178

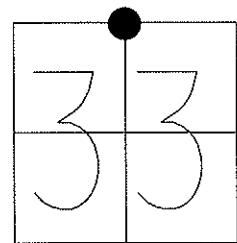

NOTE: MONBOX NOT FND.
TIES PULLED TO BRIDGE
TO NEW EXPANSION JOINT.
10/16/12, SDC

