



O.D.O.T. DISTRICT 2 SURVEY OFFICE (USE ONLY)

PERSONNEL _____ REFERENCE NO. 39 SHEET 14 OF 24
 NOTES HARBAUGH _____ DATE 12/29/10 ROUTE SR 295
 H.C. HUSS _____ WEATHER FAIR COUNTY LUCAS
 R.C. COUTCHER _____ TEMP. 25° TOWNSHIP HARDING
 _____ SECTION 9
 _____ T 10 N R 5 E

TYPE MONUMENT _____ MAG NAIL _____
 ON SURFACE ~~BELOW~~ _____ ON _____
 LEFT - ☉ PAV'T ~~RIGHT~~ 1.3', ON ☉ W-E
 _____ TO _____ EDGE PAVEMENT
 S.L.M. 797+30.22
 GRID: NORTHING: 717875.717 EASTING: 1603055.930

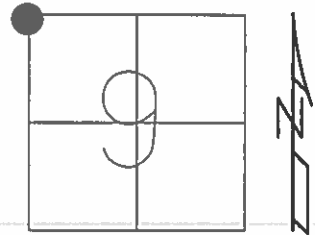


RECORD:
 SET PK NAIL
 TO SURFACE
 8/11/86
 FD PK NAIL
 10/06/10, JMH
 REF, 12/29/10, RJL
 GPS REF 39
 SET MAG/WASHER
 10/16/12, SDC
 GPS, NEWREF39
 12/13/12, SDC

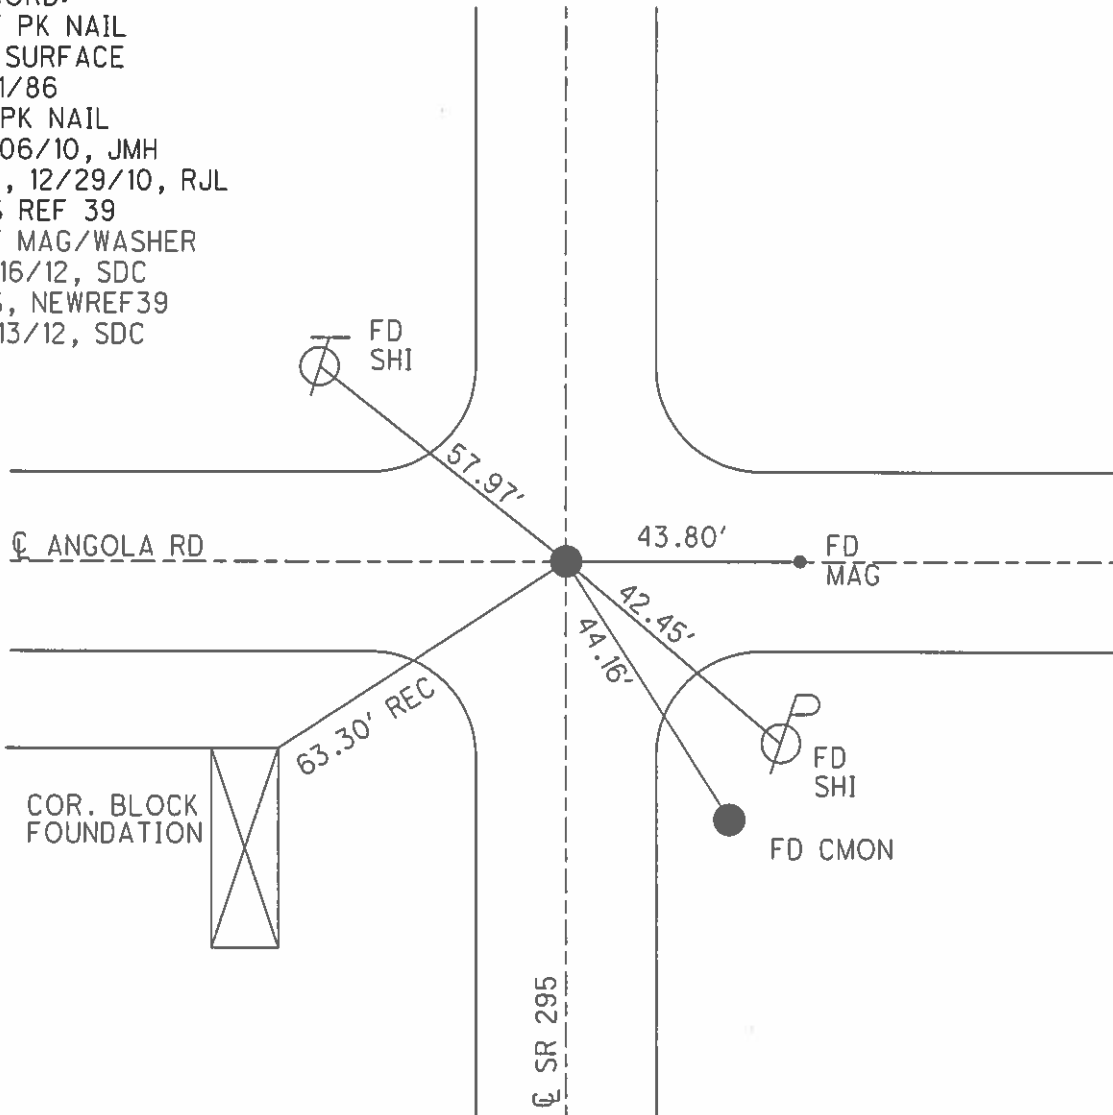

O.D.O.T. DISTRICT 2 SURVEY OFFICE (USE ONLY)


PERSONNEL _____ REFERENCE NO. 39 SHEET 14 OF 24
 NOTES HARBAUGH DATE 12-29-10 ROUTE SR#295
 H.C. HUSS WEATHER FAIR COUNTY LUCAS
 R.C. COUTCHER TEMP. 25° TOWNSHIP HARDING
 _____ SECTION 4-5-8-9
 _____ T 10 N R 5 E

TYPE MONUMENT _____ MAG NAIL
 ON SURFACE - ~~BELOW~~ _____ ON _____
 LEFT - ☉ PAV'T - ~~RIGHT~~ _____ 1.3', ON ☉ W-E
 _____ TO _____ EDGE PAVEMENT
 S.L.M. 797+30.22
 Grid: Northing: 717875.717 Easting: 1603055.930

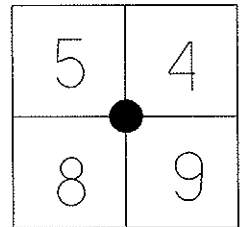

RECORD: SET PK NAIL
 TO SURFACE 8-11-86
 FD PK NAIL 10-06-10 JMH
 REF. 12-29-10 RJL
 GPS REF 39

SET MAG/WASHER
 10/16/12, SDC
 GPS, NEWREF39
 12/13/12, SDC

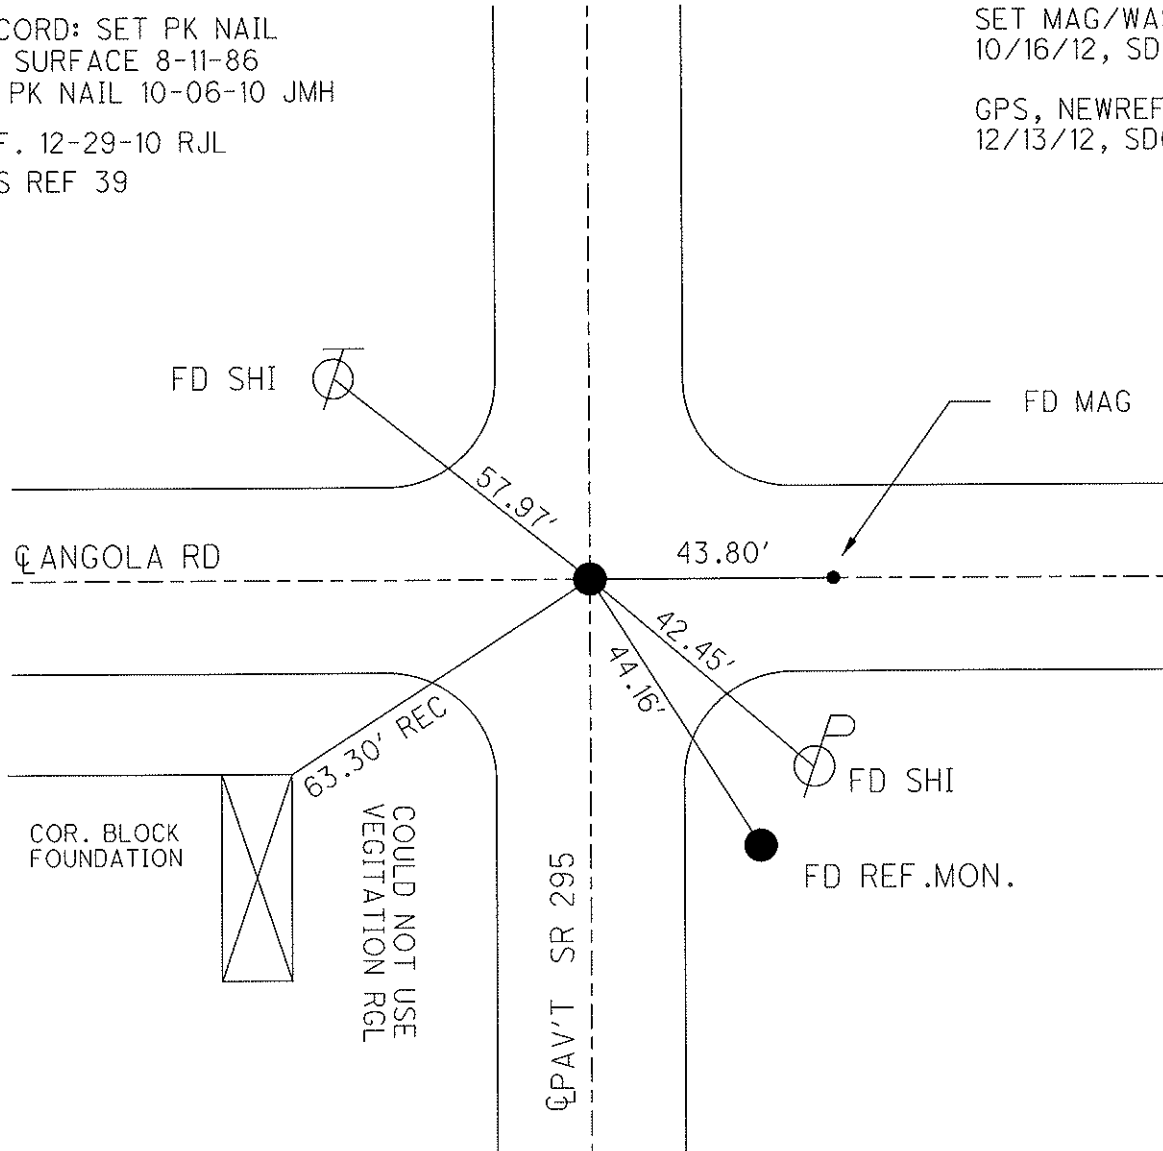

O.D.O.T. DISTRICT 2 SURVEY OFFICE

PERSONNEL

REFERENCE NO. 39

SHEET 13 OF

NOTES 1. Stone

H.C. D. Curtis

R.C. J. Haushalter

R. Michelak

DATE 6 May 86

WEATHER Warm

TEMP. 80

ROUTE SR#295

COUNTY Lucas

TOWNSHIP Harding

SECTION 4-5-8-9

T R


TYPE MONUMENT PK Nail

ON SURFACE - BELOW Surface


LEFT - & PAW'T. - RIGHT

 TO EDGE PAVEMENT

S.L.M. 735+91

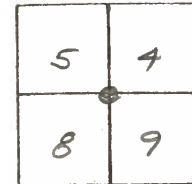


*Set P.K. Nail To Surface -
8-11-86*

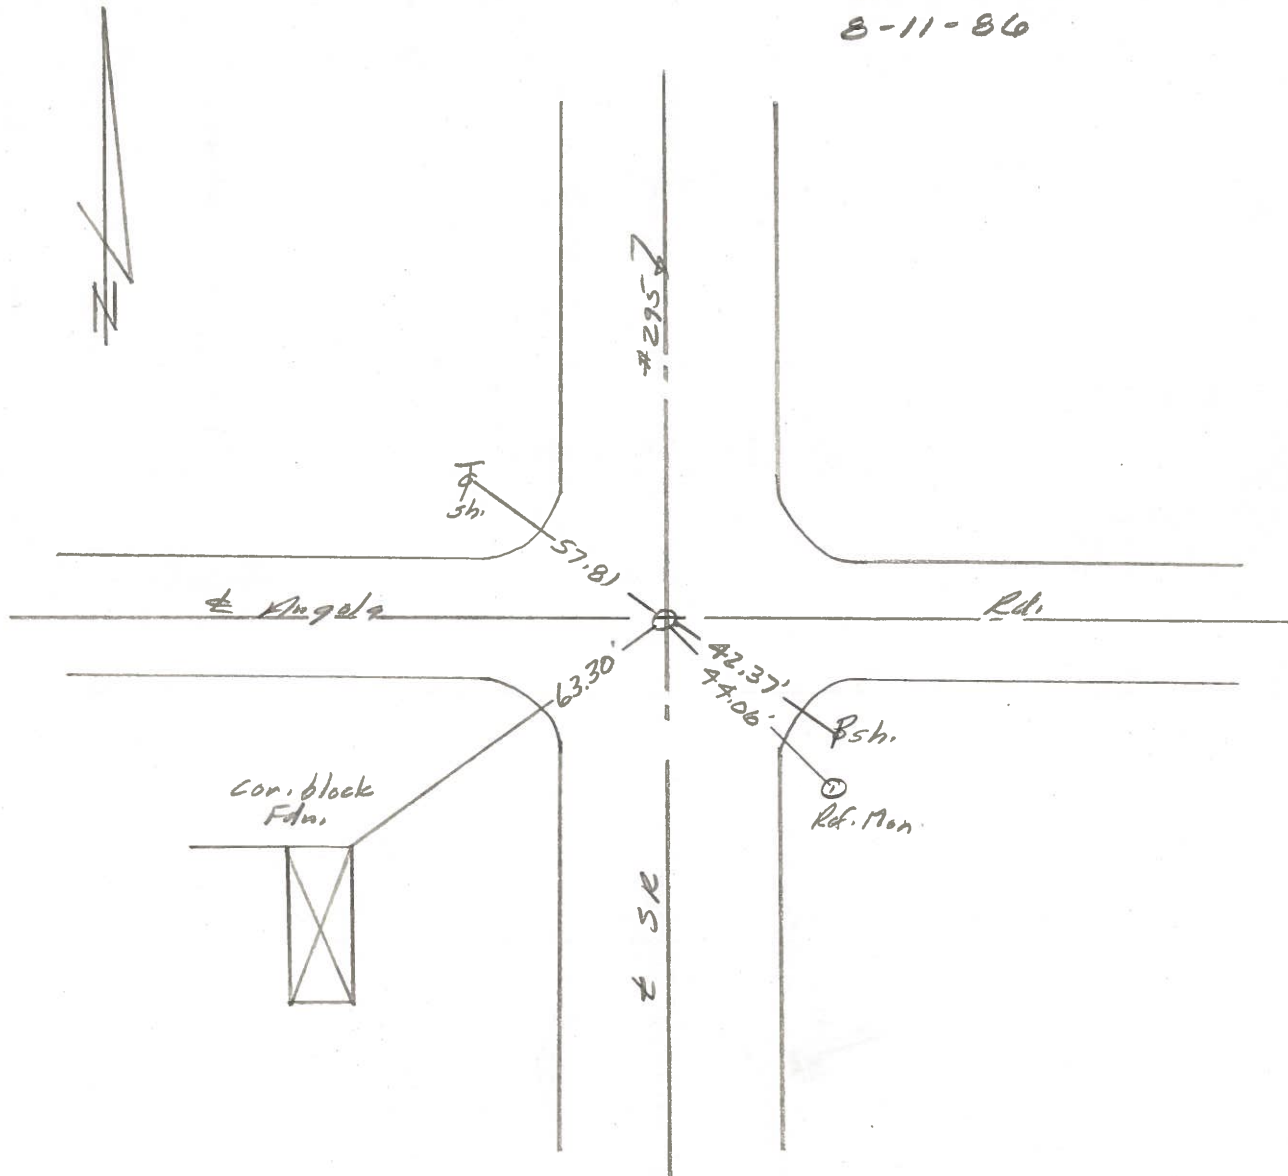

PERSONNEL	TITLE	PERSONNEL	TITLE	COUNTY	DATE	WEATHER	TEMP.
W. DENNO				LUCAS	JULY 19, 1971	FAIR	70±
D. CURTIS				S. R. #295			
D. STEVENS							
R. BRANNAN				SEC.			

DESCRIPTION	REFERENCES TO CONTROL POINTS	JOB NO.
	LEFT CENTER LINE RIGHT	

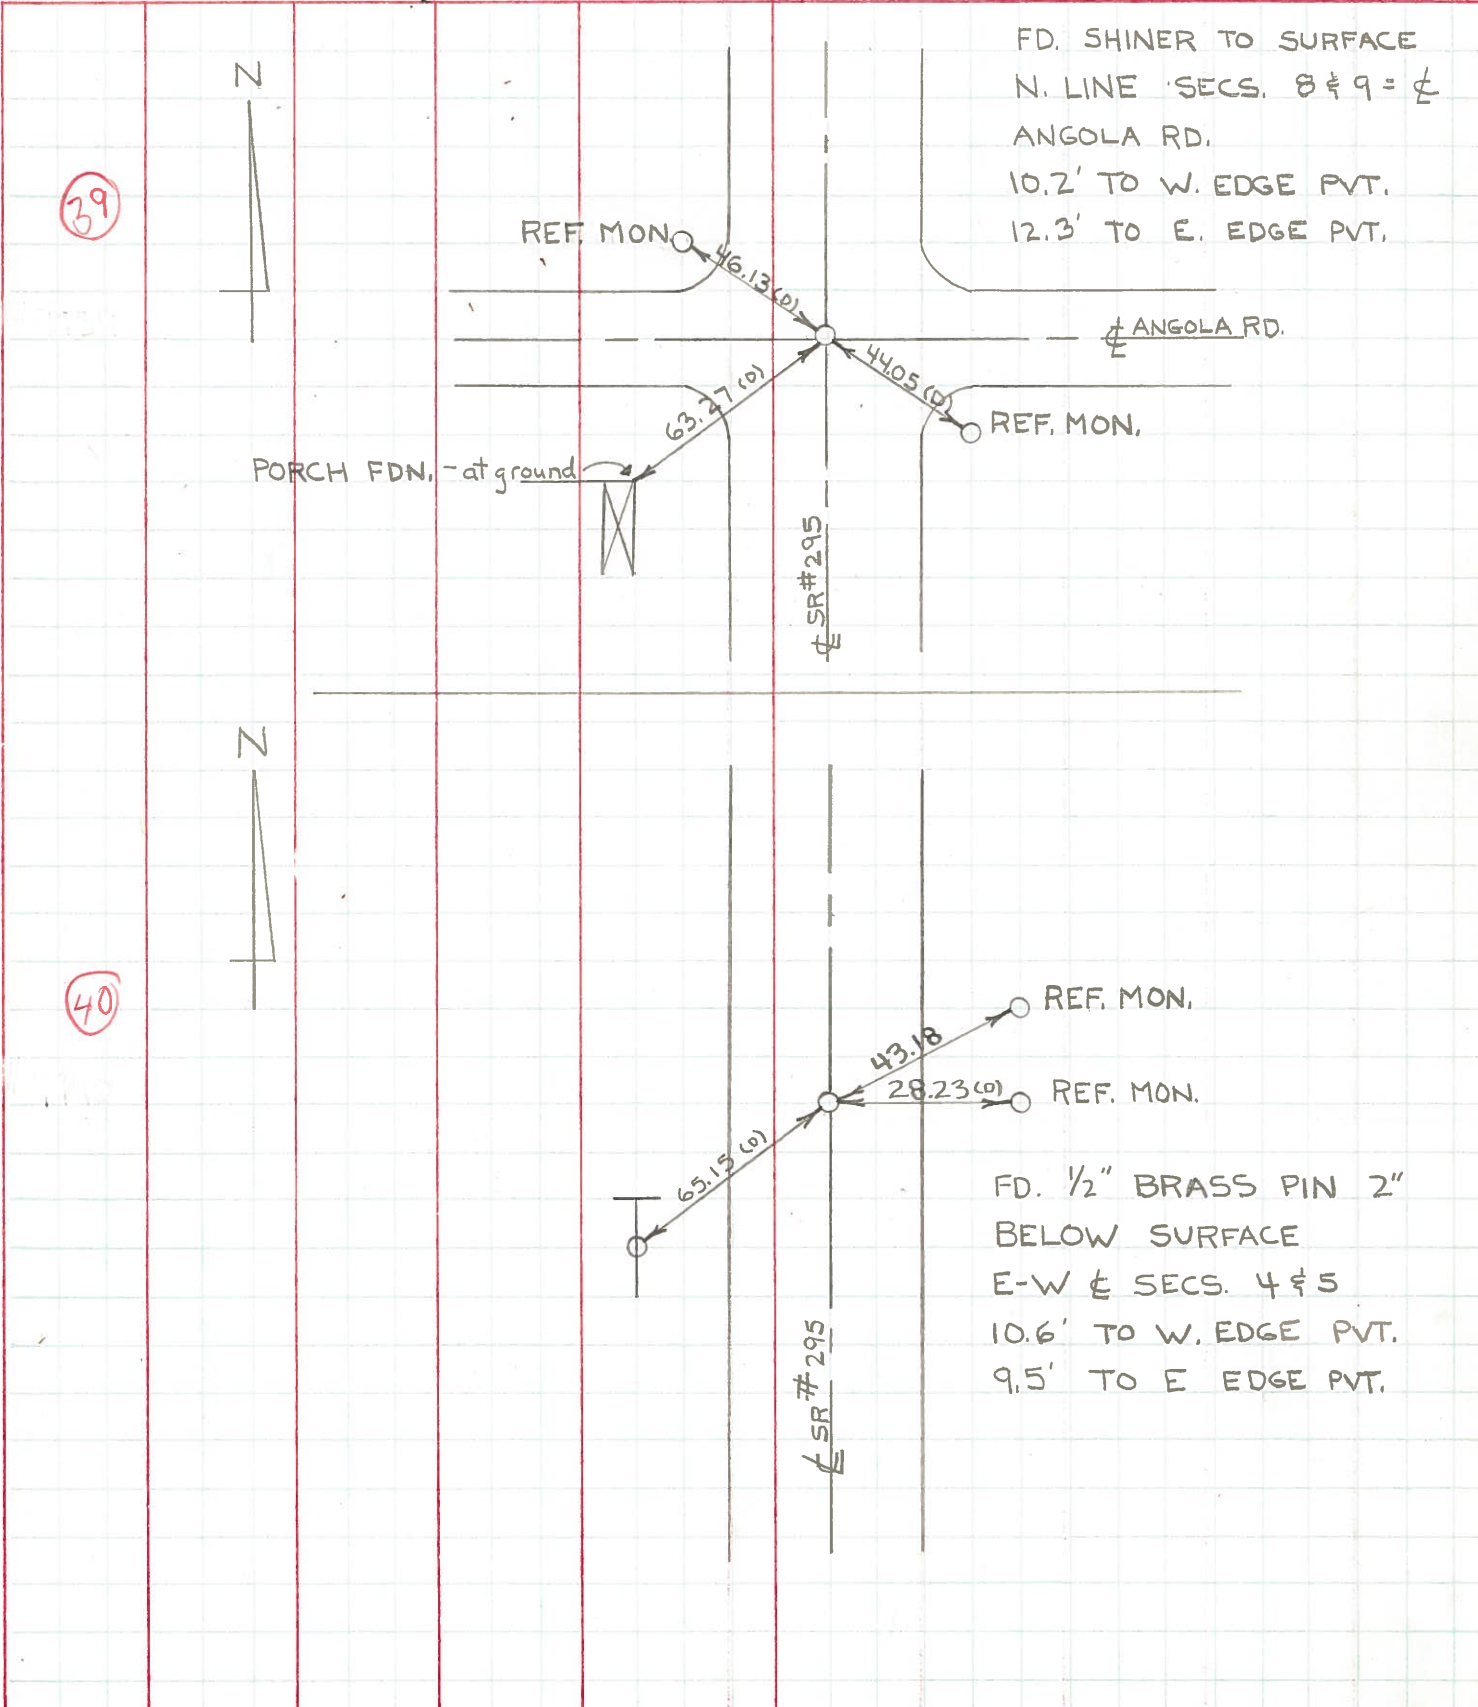

PERSONNEL	TITLE	PERSONNEL	TITLE	COUNTY	DATE
Stone	Notes			Lucas	13 June 68
Beck	Flag			S. R. 4295	WEATHER Cool
Michalak	Tape			SEC.	TEMP. 60°
Schroeder	Tape				

DESCRIPTION References to Control Points JOB NO. _____

