

O.D.O.T. DISTRICT 2 SURVEY OFFICE (USE ONLY)

PERSONNEL _____ REFERENCE NO. _____ 4 C SHEET 7 OF 38
NOTES RHOADES DATE 6/24/15 ROUTE SR 2
H.C. O'DONNELL WEATHER FAIR COUNTY OTTAWA
R.C. RHOADES TEMP. 70° TOWNSHIP BENTON
SECTION 33
T 8 N R 14 E

TYPE MONUMENT MONBOX


ON SURFACE - ~~BELOW~~ ON _____

~~LEFT~~ - Q PAV'T - RIGHT 13.6'


1.7' RT TO RT EDGE PAVEMENT

S.L.M. 90+55.11

GRID: NORTHING: 706725.012 EASTING: 1763273.454

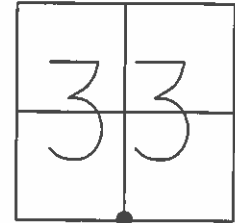

RECORD:
S 1/4 POST
SECTION 33
FD MAG NAIL
SET BY ANDRUS
2011, MC
FD MAG NAIL
4/23/13, SDC
MONBOX INSTALLED
W/ 1" IPIN
GPS, REFC4
6/24/15, JFO

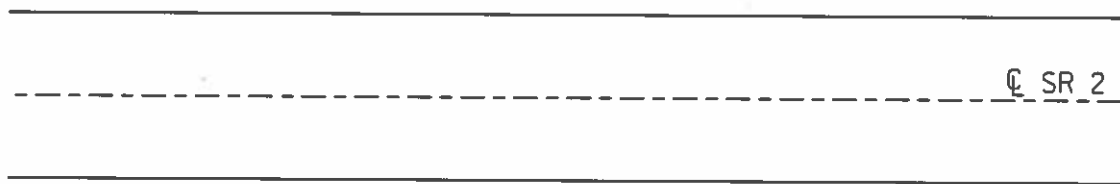

M

DIST. 4B-4C= 141.49'