


**O.D.O.T. DISTRICT 2 SURVEY OFFICE (USE ONLY)**

PERSONNEL	REFERENCE NO.	5 A SHEET	9 OF	38	
NOTES	RHOADES	DATE	6/24/15	ROUTE	SR 2
H.C.	O'DONNELL	WEATHER	FAIR	COUNTY	OTTAWA
R.C.	RHOADES	TEMP.	70°F	TOWNSHIP	BENTON
				SECTION	4
				T	7 N R 14 E

TYPE MONUMENT MONBOX  
 ON SURFACE - ~~BELOW~~ ON  
 LEFT - ☉ PAV'T - RIGHT ON  
12.3' TO LT EDGE PAVEMENT  
 S.L.M. 115+84.29  
 GRID: NORTHING: 706716.416 EASTING: 1765802.203

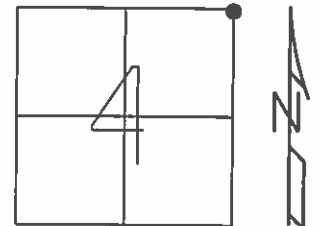

RECORD:  
 FD P.K./WASHER  
 GPS, REFA6  
 11/25/11, MC  
 FD P.K./WASHER  
 4/23/13, SDC  
 MON.BOX SET  
 W/ 3/4" IPIN  
 GPS, NEWREFA6  
 10/1/15, JFO

